

# Collingwood Green Phase 3 Invitations for Bids (IFB17-B002) Issued: September 6, 2017

### ADDENDUM #2 Issued: September 21, 2017

#### **NOTICE TO PROPOSERS:**

- A. This Addendum shall be considered part of the Contract Documents for the above mentioned project as though it had been issued at the same time and shall be incorporated integrally therewith. Where provisions of the following supplementary data differ from those of the original Contract Documents, this Addendum shall govern and take precedence.
- B. Offerors are hereby notified that they shall make any necessary adjustment in their estimates on account of this Addendum. It will be construed that each Bidder's documentation is submitted with full knowledge of all modifications and supplemental data specified herein.

#### **ADDENDUM NO. 2**

- The Submittal Date for this IFB has been extended to <u>Friday, October 6, 2017 at 11:00 AM</u>.
- 2. Please see the attached Addendums Items from Berardi + Partners, Inc.

(End of Addendum #2) #####

**Solicitation Inquiries: Kattie Bond** 

E-Mail: kbond@lucasmha.org Phone: 419-259-9471

Section 3 Inquiries to: mbishop@lucasmha.org

time and shall be incorporated integrally the from those of the original Contract Documen	•	
(1) GAUGE LEVEL OF INTEREST: So that we done so, please advise us as to whether or to this solicitation (e.g. "Will Submit" or "No E	not you anticipate delivering to u	
Will Submit	No Bid	
Thank you for your interest in doing busin from your firm.	ess with LMHA and we look forv	vard to receiving a submission
Sherry Tobin, Manager, Procurement & Contracts, Lucas N stobin@lucasmha.org	etropolitan Housing Authority	
**********	*********	*******
You must acknowledge this Addendum eleby fax to (419)259-9494, email, or de PM EST. It is the responsibility of all offero acknowledge this addendum by the dearesponsive and may eliminate such offer from	livery service by no later the rs to acknowledge addendums. F dline may, at the LMHA's disc	han September 26, 2017 at 12:00 ailure on the part of any offeror to
ACKNOWLEDGED BY:		
Signature Date	Printed Name	Company
Email		

This Addendum shall be considered part of the above referenced IFB as though it had been issued at the same

Demetria M. Simpson, President and Chief Executive Officer
Board of Commissioners
Hugh W. Grefe, *Chairman*, Barbara J. Fuqua, *Vice Chairman*, William J. Brennan, Alisha Gant, James A. Peppers



#### ADDENDUM '02'

The Proposal Drawings and Specifications, dated (09/06/2017) for:

Project Name Collingwood Green Phase 3

Toledo, Ohio

Addendum Date: September 20, 2017

#### NOTICE TO CONTRACTORS:

- A. This Addendum shall be considered part of the Contract Documents for the above mentioned project as though it had been issued at the same time and shall be incorporated integrally therewith. Where provisions of the following supplementary data differ from those of the original Contract Documents, this Addendum shall govern and take precedence.
- B. This Addendum is complimentary to and refers to revised drawings issued herewith this document, or provides general narrative for revisions to drawings not necessarily issued with this document.

#### Civil:

- **1.** Sheet C401:
  - a. Detail H/C401: to be deleted
  - **b.** Detail P/C401: revise title to 'cleanout protection'
- 2. Site furnishings: Arbor identified on L1 sheets to be provided per attached cut sheet.

#### Structural:

- 1. Sheets S101 Foundation Plans: have been revised for building dimensions attached.
- 2. Sheets S101 Buildings A/B/C/D/F/H Foundation Plans: section cuts have been identified at stoops with steps at entry door as indicated on Civil Grading Plans
- 3. Sheet S101H: Building step elevations have been revised.
- 4. Sheet S103 Buildings B/D/E/F/H Roof Framing Plans: parking lot side roof elements have been removed from roof framing plans; see attached sheets.
- 5. Sheet S201 Foundation Details:
  - a. S/S201 Stepped Entry: Exposed block to be solid smooth face architectural block, color to be determined.
  - b. Details R and Q: Note that depth of foundation varies coordinate with exterior elevations / Civil grading plan and foundation plans.

#### **Architectural:**

- 1. Sheet A101H: handrail coded note '5' added at north stoop.
- 2. Sheet A201A: North elevation coded note '11' at center element revised to '9'.
- 3. Sheet A300's Dwelling Units 301/302/303/304/30: Door tags have been added to all doors.
- 4. Sheet A306 Dwelling Unit 4 BR Townhouse:
  - a. Add shelf per coded note 3 at both bedroom #4 closets.
  - b. Add shelves per coded note 1 and 3 at both bedroom #10 closets.
  - c. Storage closet door to be type U8.
- 5. Sheet A307 3 Bedroom townhouse 'A':
- 6. bedroom 3 closet shelving note '26' added see attached sheet.
- 7. Sheet A308 3 BR Corner TH:
  - a. Add shelf coded notes 10 and 3 at bedroom #2 closet.
  - b. Second floor exterior deck door to be type U2.



- 8. Sheet A701: Exterior doors to be steel Therma Tru per specification.
- 9. Sheet A901 Finish Schedule: to be replaced with attached sheet A900.

#### **Specifications:**

- 1. General: Project specification is industry standard and no warranty language has been modified to change responsibility. Product and equipment etc. warranties are by the manufacturer and workmanship etc. requirements are to be the responsibility of the general contractor.
- 2. Section 05 720 Vista Pro railing is an acceptable manufacturer
- **3.** Section 07 6113 Metal Roofing: to be deleted.
- **4.** Section 08 5313 Vinyl Windows:
  - a. 1.3.C: Only **Handicap ANSI Type A** dwelling unit windows are required to meet the 5 pound of pressure requirement, which is to be met by utilization a product similar to the Windowease product specified in 2.5.F.
  - b. 2.1 A: add Anderson Silverline to allowable manufactures.
  - c. 2.1 A: remove Crystal from allowable manufactures.
  - d. 2.3 D.2: remove U-factor = .30; refer to section 'H' for Energy Star requirements.
  - e. 2.3 E: remove SHGC = 0.51; refer to section 'H' for Energy Star requirements.
  - f. 2.3.I: Windows to be white as per the specifications.
  - g. 2.4.C: all glazing to be tempered.
- 5. Section 09 2900: Certainteed Gypsum products is an acceptable manufacturer of equal products.
- **6.** Section 12 2110:
  - a. No cellular shades are required.
  - b. Levolar is an acceptable manufacturer; must meet specification requirements.
- 7. Section 12 3530; basis of design, Advanta Vista Birch Premier series
- **8.** Division 21 Fire Suppression: Disregard entire division.

#### **Contractor Ouestion Responses:**

- It does not appear that Unit Floor Finish Plans are provided for the 2 BR Townhouse HC unit or the 3 BR Townhouse HC unit as they are listed on the cover sheet. Please advise. Revised finish schedule is attached.
- 2. It does not appear that a Finish Schedule for the 4 BR End unit has been provided. Please advise. *Revised finish schedule is attached.*
- 3. It does not appear that storage closet flooring or base is called out in the 3 BR Townhouse Type "B" unit. Please advise. *Revised finish schedule is attached*.
- 4. Door Type U13 shows up on the floor plans but on the door schedule. Please advise. *Added to schedule to be identical to door type U11*.
- 5. The storage closet door type is not called out on the 4 BR townhouse on the first floor. Please advise. *To be door type U8*.
- 6. Exterior elevations show the two outside windows on the south elevation of Building D as double windows 6'8" wide but the door schedule calls for a single window that is 3'0" wide. Please advise. *To be window type Q*.
- 7. Exterior elevations show the window on the north east corner of Building B as double windows 6'8" wide but the door schedule calls for a single window 2'6" wide. Please advise *To be window type Q.*
- 8. Can consideration please be given to requiring only the LMHA bid forms shown in 00 42 33 to be turned in with the bid and NOT the separate HUD 2328 form that is listed later in the spec. These two bid forms do not line up exactly and are very difficult to make "match" prior to submitting the bid. The HUD 2328 could be turned in along with any additional information required post bid.
  - a. The requirement that the HUD-5372 be submitted with the bid shall be deleted in its entirety. The awarded contractor shall be required to submit the completed form within three days of the Notice of Award.
- 9. Please confirm that this project is taxable. Yes, the project is subject to all applicable taxes.
- 10. Is the contractor responsible to provide a certified ALTA survey upon project completion? The Contractor
- 11. When is the proposed start date for construction? Spring 2018



- 12. Section 01 5000 does not dictate whether overnight and weekend security is a requirement of the contractor. Will the owner be providing this security? *LMHA will not be providing site security for Phase 3.* The GC will be responsible for the site security of the phase 3 project site per specification section 01 500.
- 13. Please confirm the contractor is providing the builder's risk insurance.

Per HUD 5370 General Conditions for Construction Contracts, as attached to the bid documents, Clause 36 Insurance Section (b):

Before commencing work, the Contractor shall furnish the PHA with a certificate of insurance evidencing that Building's Risk (fire and extended coverage) Insurance on all work in place and/or materials stored at the building site(s), including foundations and building equipment, is in force...

- 14. Please confirm that a 2 year maintenance bond is required for all work within the ROW. A 2 year maintenance bond is required for the roadway work portion of the project and shall meet the requirements of section 109.12E in the City of Toledo's Part 'A' Standards 2017
- 15. Does this project require a fire suppression systems? Question is related to Division 21 Specification Sections that are provided. *Disregard entire specification division*.
- 16. Plumbing Manufactures:
  - a. 2.01:
    - i. proflo OK,
    - ii. Zurn OK,
    - iii. Gerber OK,
    - iv. cmi We cannot approve this manufacturer without additional information.
    - v. and mainline We cannot approve this manufacturer.
  - b. 2.02:
- i. proflo, zurn, gerber, cmi, See above
- Olympia and pioneer, We cannot approve this manufacturer without additional information.
- iii. and mainline. See above
- **c.** 2.03:
- i. proflo, zurn, mainline, Gerber, cmi, See above for each brand's respective comments.
- ii. and Elkay. OK
- d. 2.04
- i. proflo, gerber, and zurn. See above
- ii. Mansfield, OK other than their toilets.
- e. 2.07: oatey, Sioux chief OK
- f. 2.08: badger Insinkerator? already included in specs.
- g. 2.09: zurn, gerber, Mansfield, and proflo. All OK if they meet MaP test score of 1000+ grams and performance of the basis of design
- h. 2.10 gerber, zurn, Mansfield, and proflo. These are OK
- i. mainline, We cannot approve this manufacturer.
- j. 2.11 cdx, CDX is the new name of Praxis, which is included in specs and oasis, OK
- k. 2.12
- i. proflo, and mainline. Stainless steel sinks OK
- ii. zurn, Mansfield, We cannot approve this manufacturer without additional information.
- 1. 2.13 Sioux chief OK
- 17. Can consideration also be given to completing the HUD-5372 as a post bid document? Without final numbers being completed until minutes before bids are due, it is difficult to <u>accurately</u> complete this form. The requirement that the HUD-5372 be submitted with the bid shall be deleted in its entirety. The awarded contractor shall be required to submit the completed form within three days of the Notice of Award.
- 18. Will the project budget be published before contractors are to submit their bids? LMHA does not publish independent cost estimates for public bids unlike the Request for Proposal or Qualification process.
- 19. Starting/Completion Information 00 43 56 1 of 1 describes a mid-July start. Pre Bid notes identify a Spring start. Spring 2018 is proposed start date.
- 20. Please delete the requirement for a detailed preliminary construction schedule to be turned in with the bid. A preliminary construction schedule is required for the HUD funding submission which is scheduled to occur shortly after the bid date. Please submit your best estimated schedule based on previous experience.
- 21. Is a level 5 finish required on the drywall where a gloss or semi-gloss paint is used per the drywall spec? *No; level 5 finish not required, level 4 finish to be provided.*
- 22. In the existing building walk thru I noticed there is a knockdown finish on most of the drywall. Is this required for this phase of buildings? If so, where is it to be located? *Knockdown ceiling finish is not required but can be provided at contractor's option.*

#### END OF ADDENDUM 02

Search...

0 Items



Home Products Info Interact Dealer Contact





Accessories

Arbors

Lamp Posts

Pergolas

Planter Boxes

**Trellises** 

#### CONTACT:

Canadian Office 211 Campbell Street Sarnia, ON N7T 2G6 MAP Office Hours 8:00 to 5:00 EST Monday to Friday

Toll Free 1 800 282 9346

Toll Free Fax 1 866 698 9047

Michigan Warehouse 3605 32nd St, Bldg 3 Port Huron, MI 48060 MAP E-mail info@newenglandarbors.com

# Arbors







# Fairfield Grande **\$829.99 - \$889.99**

Looking for that wide arbor to span a walkway or fit your riding lawn mower through? The Fairfield Grande Arbor offers the perfect solution. Not only is it functional, but it looks beautiful with its stylish flat top design, while still offering timeless appeal. This arbor will offer an eloquent entrance to any yard or garden, helping define the concept of the outdoor room. Because it's made of premium weatherresistant vinyl, the Fairfield Grande Arbor is virtually maintenance free. This means that you will never need to stain, paint or maintain your arbor again! The Fairfield Grande Arbor combines modern appeal with classic looks that will

give you a lifetime of enjoyment.

This product comes with a 20 year warranty against yellowing, warping, cracking, and rotting.

#### **Details:**

Item Code: VA84231 Assembly difficulty:

Medium Posts: 4 x 4 Color: White

Number of Boxes: 2 Shipping Information

Price: \$829.99 Add-ons: Trim Kit

Instructions

Line Drawings

\$829.99 - Fairfield Grande Arbor

\$889.99 - Fairfield Grande Arbor (with Trim Kit)


Add to Cart


#### Home Products Info Interact Dealer Contact


© 2015 New England Arbors. All Rights Reserved. Site by CCI Studios

## Fairfield Grande Arbor



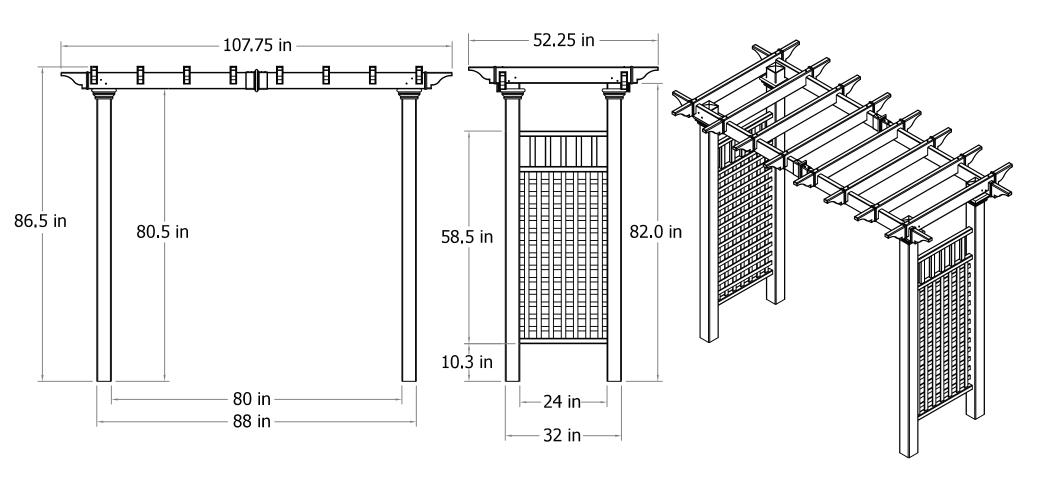

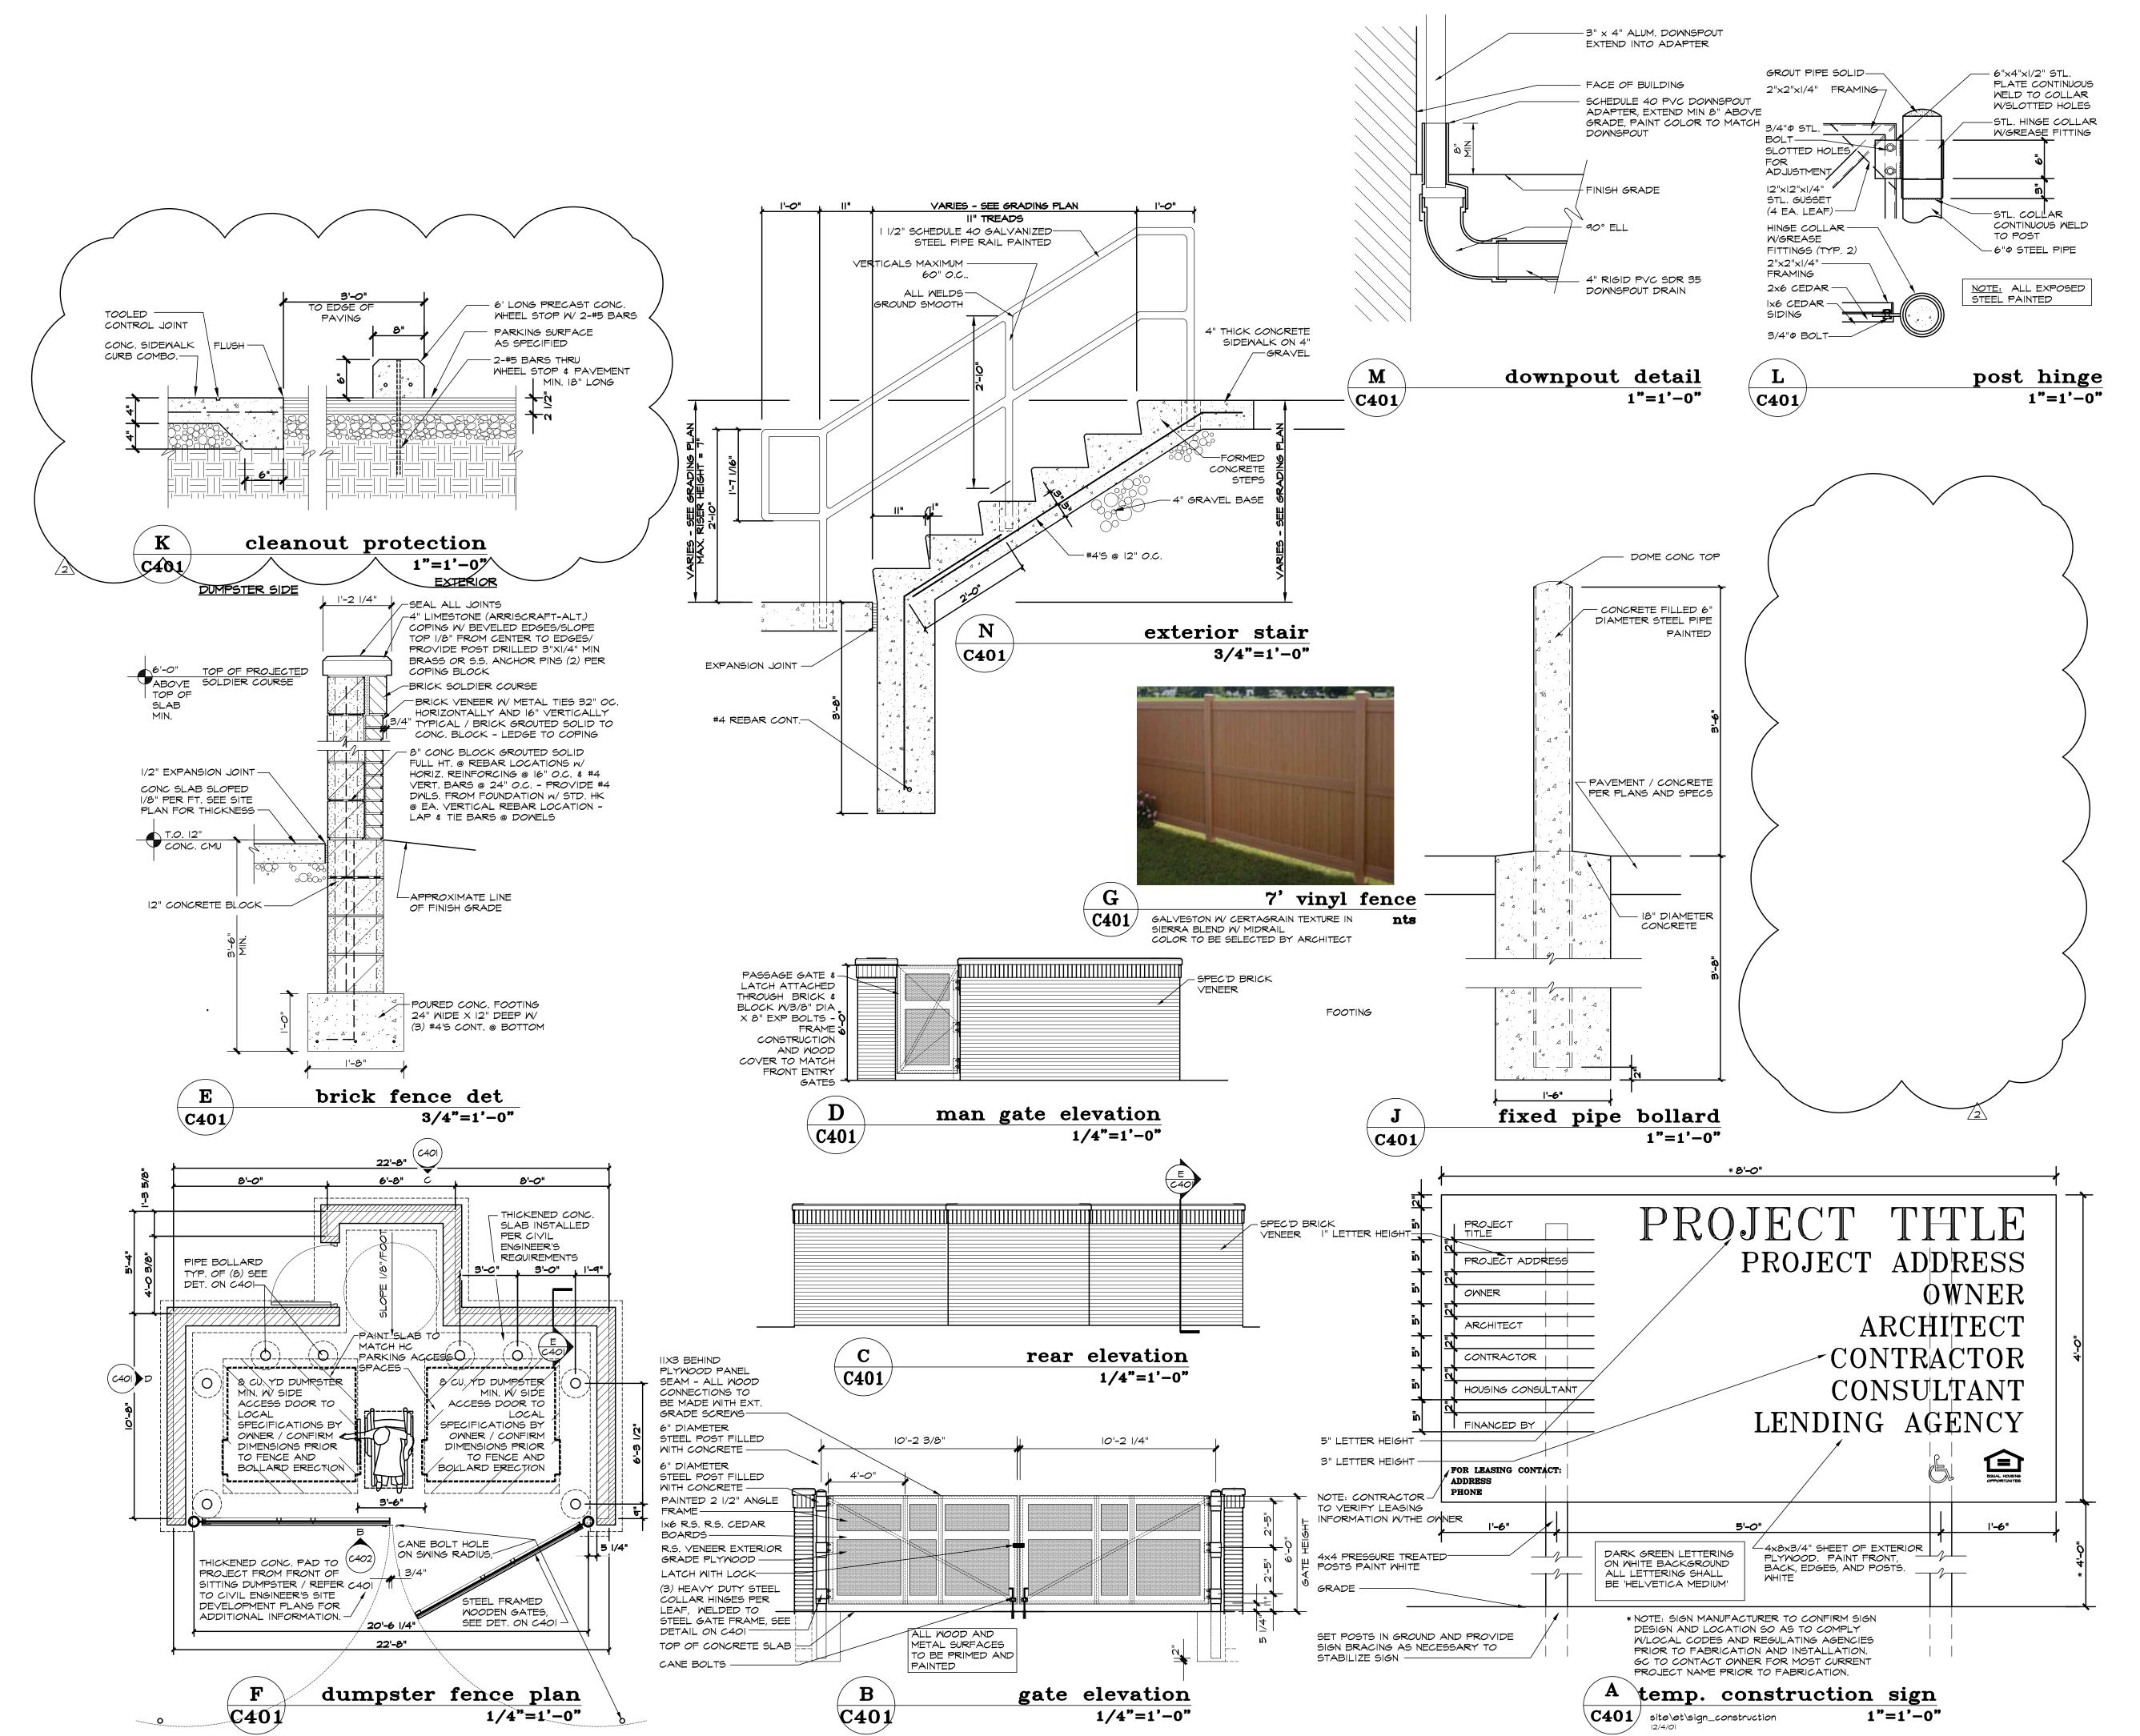

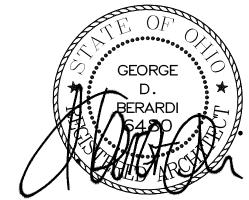

LMHA Collingwood Green, Phase III

Collingwood Green
"Quality affordable living within a green community."



THE ARRANGEMENTS DEPICTED HEREIN ARE THE SOLE PROPERTY OF BERARDI + PARTNERS, INC., ARCHITECTS AND ENGINEERS, AND MAY NOT BE REPRODUCED WITHOUT ITS WRITTEN PERMISSION

NOTE:

1. ALL BIDDERS SHALL VISIT THE SITE AND BECOME FAMILIAR M/
THE EXISTING CONDITIONS AND REQUIREMENTS OF THE PROJECT
AND SHALL NOTIFY THE ARCHITECT OF ANY ERRORS AND OMISSIONS
SUBSEQUENTLY DISCOVERED IN THE CONTRACT DOCUMENTS.

SUBSEQUENTLY DISCOVERED IN THE CONTRACT DOCUMENTS.

2. THE CONTRACT DOCUMENTS ARE COMPRISED OF THE DRAWINGS AND THE PROJECT MANUAL IN THEIR ENTIRETY. THE INFORMATION IN THESE DOCUMENTS IS DEPENDENT UPON AND COMPLEMENTARY OF EACH OTHER. SEPARATION OF THE CONTRACT DOCUMENTS SHALL NOT BE PERMITTED. IF THE CONTRACT OR CHOOSES TO SEPARATE

THE DOCUMENTS, THEY DO SO AT THEIR OWN RISK AND EXPENS:

3. ADDITIONALLY, SEE GENERAL INFORMATION ON "AO" SHEETS.

4. THE CLIENT ACKNOWLEDGES THE CONSULTANT'S (ARCHITECT) DRAMINGS AND SPECIFICATION, INCLUDING ALL DOCUMENTS ON ELECTRONIC MEDIA AS INSTRUMENTS OF THE CONSULTANTS (ARCHITECT) PROFESSIONAL SERVICE. THE CLIENT SHALL NOT REUSE OR MAKE OR PERMIT TO BE MADE ANY MODIFICATION TO THE DRAWINGS AND SPECIFICATIONS HITHOUT THE PRIOR WRITTEN AUTHORIZATION OF THE CONSULTANT (ARCHITECT). THE CLIENT AGREES TO WAIVE ANY CLAIM AGAINST THE CONSULTANT (ARCHITECT) ARISING FROM ANY UNAUTHORIZED TRANSFER, REUSE OR

MODIFICATION OF THE DRAWINGS AND SPECIFICATIONS.

5. ARCHITECT CANNOT WARRANT THE ACCURACY OF DATA CONTAINED HEREIN. ANY USE OR REUSE OF ORIGINAL OR ALTERED CADD DESIGN MATERIALS BY THE USER OR OTHER PARTIES WITHOUT THE REVIEW AND WRITTEN APPROVAL OF THE ARCHITECT SHALL BE AT THE SOLE RISK OF THE USER. FURTHERMORE, USER AGREES TO DEFEND, INDEMNIFY, AND HOLD ARCHITECT HARMLESS FROM ALL CLAIMS, INJURIES, DAMAGES, LOSSES, EXPENSES, AND ATTORNEY'S FEES ARISING OUT OF THE MODIFICATION OR REUSE OF THESE MATERIALS.

6. THESE DRAWINGS AS PART OF THE CONTRACT DOCUMENTS ARE DIAGRAMMATIC AND ARE NOT INTENDED TO DEFINE EXACT QUANTITIES, LOCATIONS OR CODIFIED REQUIREMENTS, THE DRAWINGS SHALL NOT BE SCALED, EXACT STATE AND LOCAL CODE REQUIREMENTS AND OTHER APPLICABLE CODE REQUIREMENTS SHALL BE VERIFIED BY AND ARE THE SOLE RESPONSIBILITY OF THIS CONTRACTOR. ANY INFORMATION WHICH DIRECTLY CONFLICTS WITH ANY OF THESE CODES OR ANY DISCREPANCIES FOUND IN THE CONTRACT DOCUMENTS SHALL BE BROUGHT TO THE ATTENTION OF THE PROJECT ARCHITECT.

Bid Set

PROJECT DATE 09/06/2017

14105

sue Description Date
1 ADDENDUM 2 09/18/17

PROJECT #:


CIVIL DETAILS

C401



1398 Goodale Blvd. Columbus, Ohio 43212

Phone (614)221-1110) Fax (614)221-0831 www.berardipartners.com

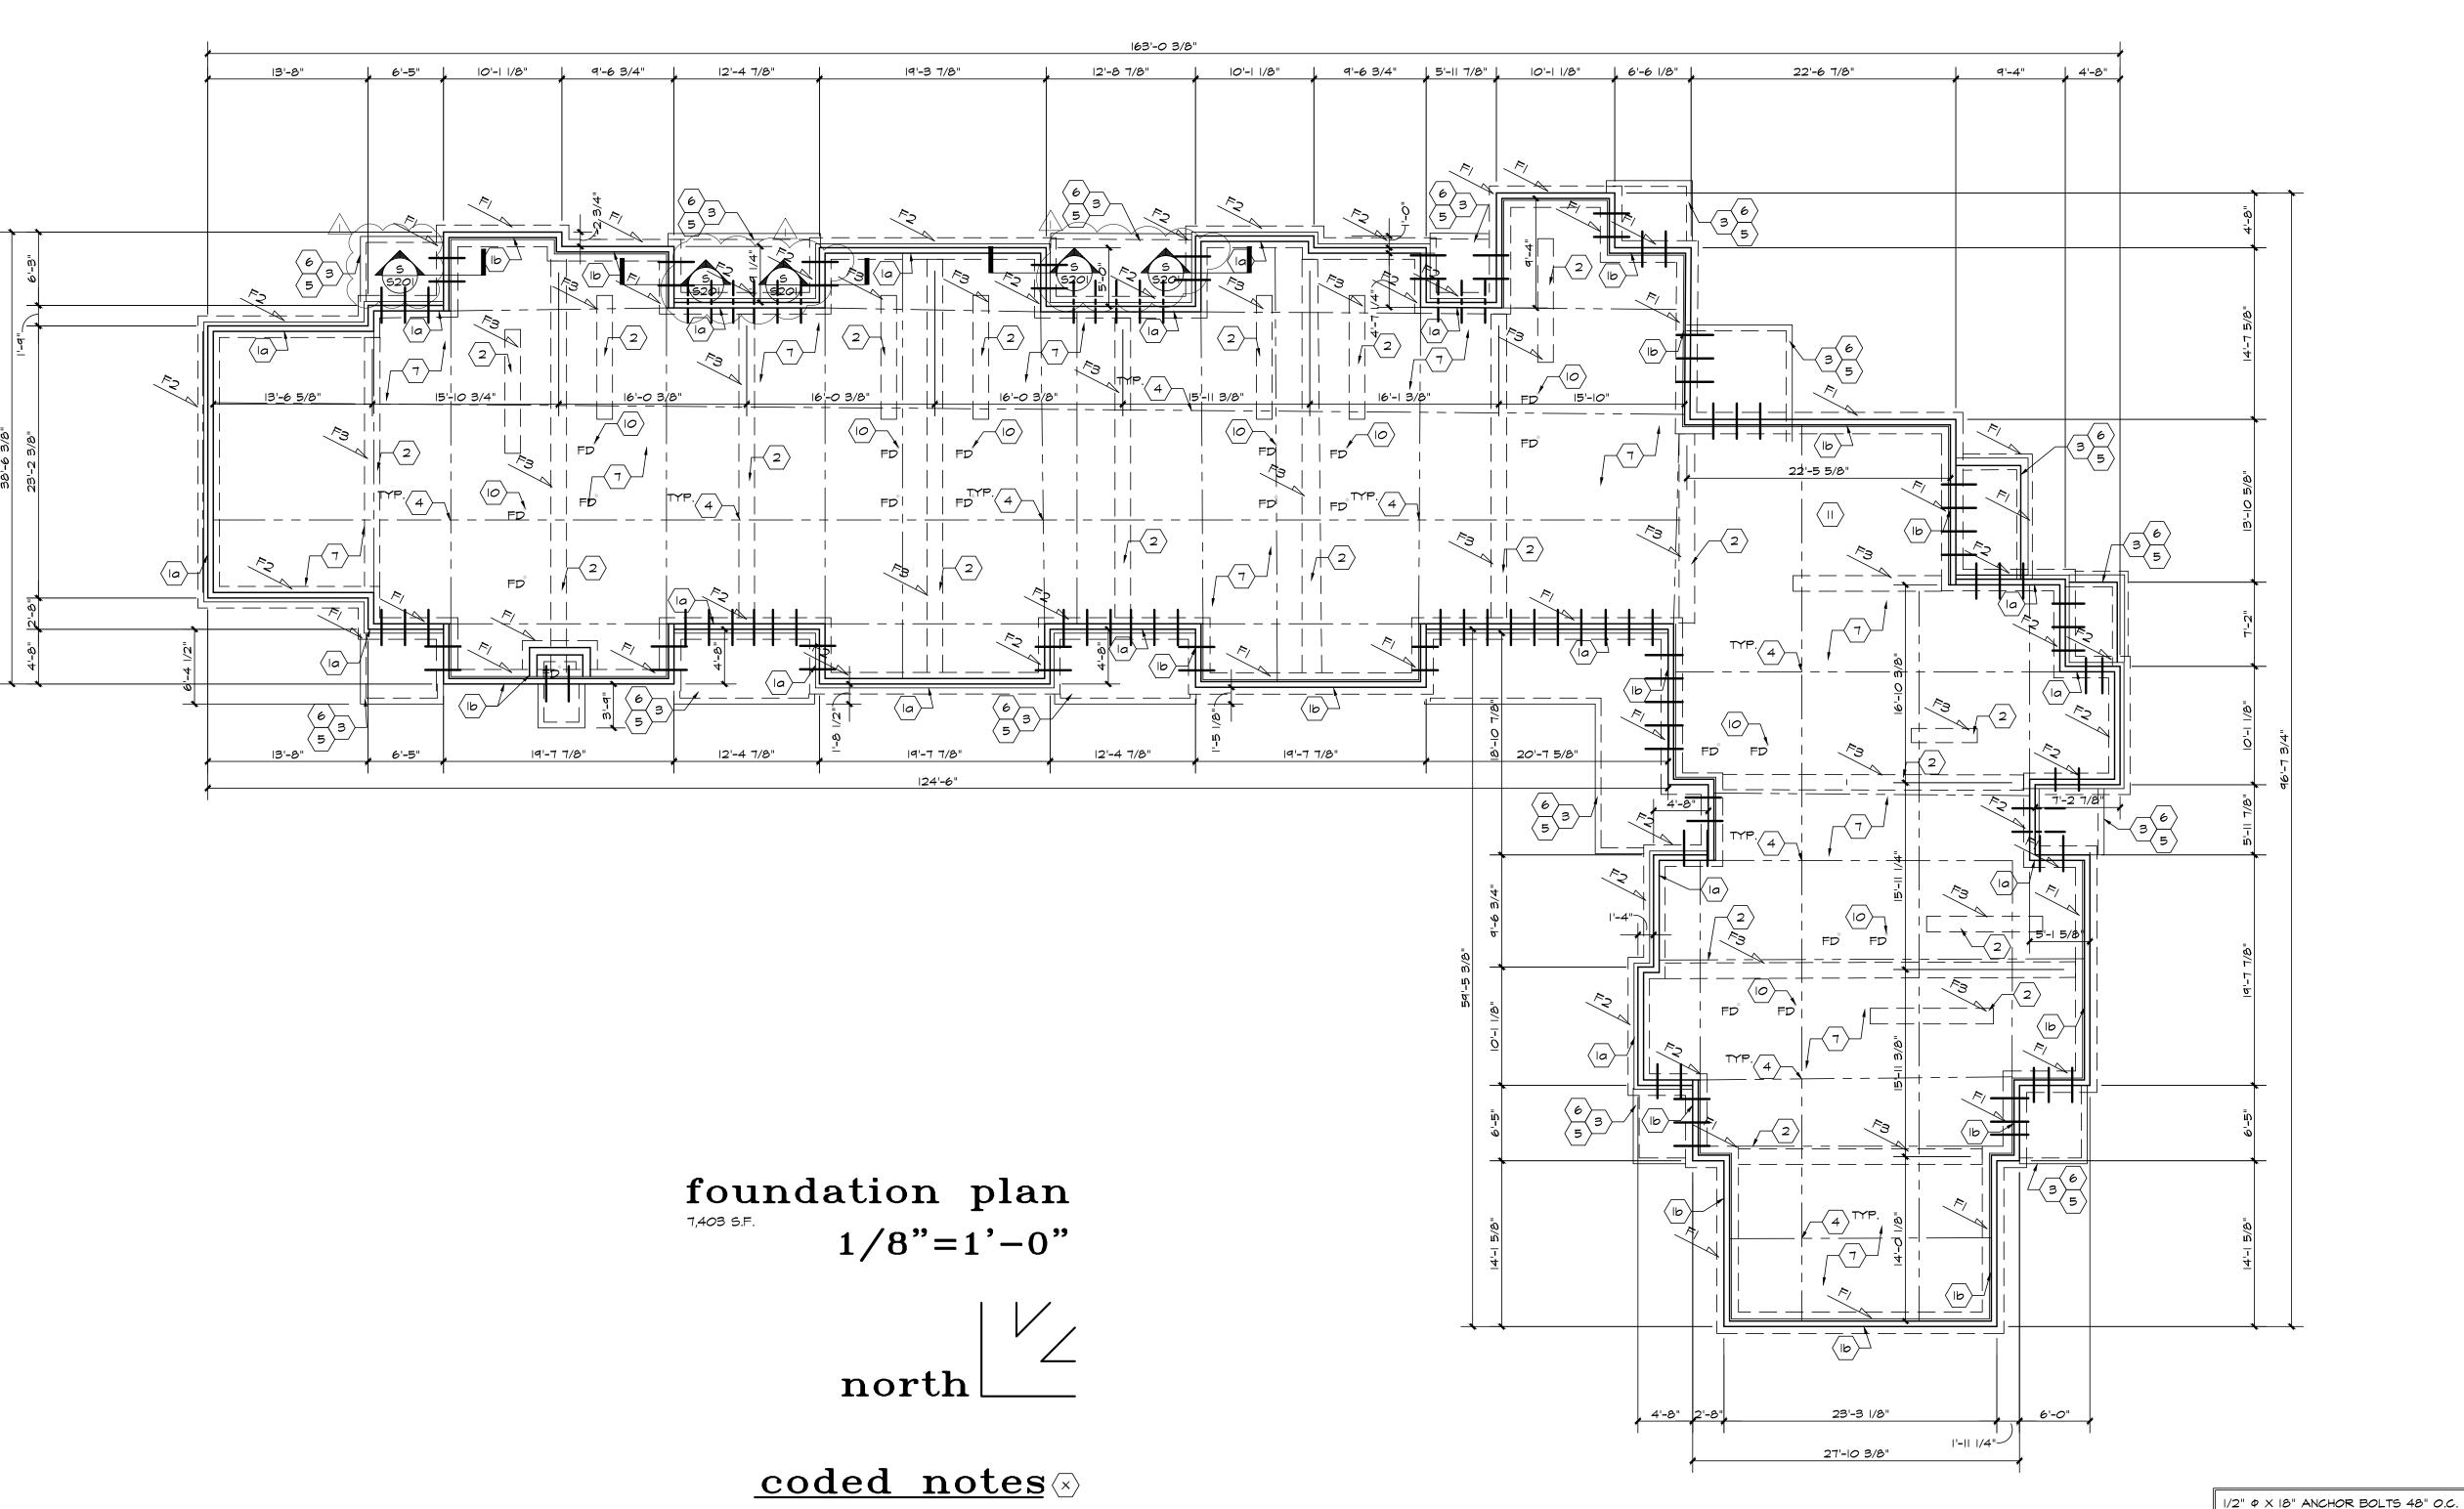

- POURED CONCRETE FOUNDATION STEM WALL ON POURED CONCRETE FOOTING SEE FOUNDATION SCHEDULE. (BOTTOM OF ALL PERIMETER AND BUILDING EXTERIOR FOUNDATION SYSTEMS TO BE 42" MINIMUM BELOW FINISH GRADE.)
  - a. 10" MASONRY STEM WALL PLUS BRICK VENEER DETAILS ON 5201.
- b. 8" MASONRY STEM WALL PLUS STONE VENEER AND SIDING DETAILS ON \$201.
   POURED CONCRETE THICKENED SLAB (SEE FOOTING SCHEDULE). SEE DETAIL \$201
- POURED CONCRETE THICKENED SLAB (SEE FOOTING SCHEDULE). SEE DETAIL S201
   4" THICK CONCRETE STOOP/SLAB W/ FIBROUS REINFORCING AND 42" DEEP TURNED DOWN EDGE ON GRAVEL SEE DETAIL E/S201 & F/S201. (SEE SECTIONS FOR DEEPER SLAB EDGE ) TOOLED JOINTS AS INDICATED. HAND SWIRLED FINISH W/PICTURE FRAME JOINTS AND EDGES.
- 4. SAW CUT CONTROL JOINT. SEE DETAIL G/S201.
- 5. #4 BENT REBAR @ 16" O.C. AT EXTERIOR WALL ABUTMENT. FIRST AND LAST
- DOWEL PLACED W/IN 12" OF WALL. SEE DET. B/S201 SIM.

  6. #4 BENT REBAR @ 16" O.C. AT EXTERIOR DOOR LOCATION. FIRST AND LAST DOWEL PLACED W/IN 12" OF WALL. SEE DET. A/S201 SIM.
- 7. 4" CONC. SLAB W/ WITH FIBROUS REINFORCING ON 6 MIL. POLY VAPOR BARRIER ON 4" GRANULAR FILL, TYPICAL.
- 8. CONT. FTG. FOR SHEAR WALL. SEE SECTION E/A601 THICKEN FOOTING HOLD-DOWN TO 15" 1'-0" PAST HOLD DOWN ALL DIRECTIONS.
- 9. INTERIOR CONCRETE FOOTING FOR WOOD COLUMN

ž ×


Q Q

a ×


₹ X

- 10. RECESSED FLOOR DRAINS 1/8" PER FT WITHIN AREA SERVED, TYP.
- COORDINATE WITH MP FOR EQUIPMENT LAYOUT.

  II. CONCRETE SLAB TO BE DEPRESSED AT FIRST FLOOR SHOWERS, SEE DETAIL
- P/5201. 12. STEPPED FOOTING LOCATION. REFER TO DETAIL A/SIOI.
- 13. KEYED CONSTRUCTION JOINT FOR THICKENED SLAB STEPPED 8" / FOUNDATION STEPPED EA. END REFER TO ELEVATIONS AND RELATED DETAIL.
- 14. 12" DIA.  $\times$  42" DP. CONC. POST FOOTING / 1" ISOLATION JOINT BETWEEN POST FOOTING AND CONC. SLAB (U.N.O. TYPICAL OF ALL POST COLUMNS ALL BLDGS TYP.)
- 15. SEE DETAIL M/S201 FOR STEPPED CONDITION @ EXTERIOR SLAB

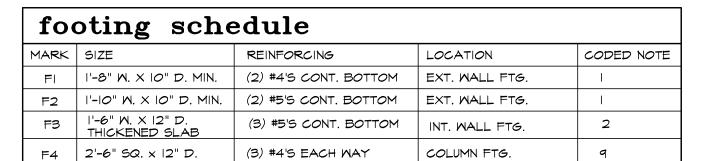

NOTES:
CODED NOTES APPLY TO ENTIRE BUILDING.
INDIVIDUAL IDENTIFICATION IS FOR REFERENCE
ONLY.
MATERIALS TO BE INSTALLED PER MANUFACTURERS
MOST CURRENT WRITTEN INSTALLATION
INSTRUCTIONS

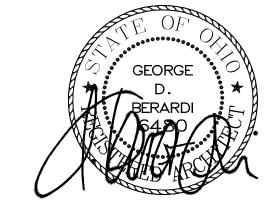

# LMHA Collingwood Green, Phase III





THE ARRANGEMENTS DEPICTED HEREIN ARE THE SOLE PROPERTY OF BERARDI + PARTNERS, INC., ARCHITECTS AND ENGINEERS, AND MAY NOT BEREPRODUCED WITHOUT ITS WRITTEN PERMISSION

NOTE:

1. ALL BIDDERS SHALL VISIT THE SITE AND BECOME FAMILIAR M/
THE EXISTING CONDITIONS AND REQUIREMENTS OF THE PROJECT
AND SHALL NOTIFY THE ARCHITECT OF ANY ERRORS AND OMISSIONS
SUBSEQUENTLY DISCOVERED IN THE CONTRACT DOCUMENTS.

2. THE CONTRACT DOCUMENTS ARE COMPRISED OF THE DRAWINGS AND THE PROJECT MANUAL IN THEIR ENTIRETY. THE INFORMATION IN THESE DOCUMENTS IS DEPENDENT UPON AND COMPLEMENTARY OF EACH OTHER. SEPARATION OF THE CONTRACT DOCUMENTS SHALL NOT BE PERMITTED. IF THE CONTRACT DOCUMENTS SHALL NOT BE PERMITTED. IF THE CONTRACTOR CHOOSES TO SEPARATE THE DOCUMENTS, THEY DO SO AT THEIR OWN RISK AND EXPENSE.

3. ADDITIONALLY, SEE GENERAL INFORMATION ON "AO" SHEETS.

4. THE CLIENT ACKNOWLEDGES THE CONSULTANT'S (ARCHITECT) DRAMINGS AND SPECIFICATION, INCLUDING ALL DOCUMENTS ON ELECTRONIC MEDIA AS INSTRUMENTS OF THE CONSULTANTS (ARCHITECT) PROFESSIONAL SERVICE. THE CLIENT SHALL NOT REUSE OR MAKE OR PERMIT TO BE MADE ANY MODIFICATION TO THE DRAWINGS AND SPECIFICATIONS WITHOUT THE PRIOR WRITTEN AUTHORIZATION OF THE CONSULTANT (ARCHITECT). THE CLIENT AGREES TO WAIVE ANY CLAIM AGAINST THE CONSULTANT (ARCHITECT)

MODIFICATION OF THE DRAWINGS AND SPECIFICATIONS.

5. ARCHITECT CANNOT WARRANT THE ACCURACY OF DATA CONTAINED HEREIN. ANY USE OR REUSE OF ORIGINAL OR ALTERED CADD DESIGN MATERIALS BY THE USER OR OTHER PARTIES WITHOUT THE REVIEW AND WRITTEN APPROVAL OF THE ARCHITECT SHALL BE AT THE SOLE RISK OF THE USER. FURTHERMORE, USER AGREES TO DEFEND, INDEMNIFY, AND HOLD ARCHITECT HARMLESS FROM ALL CLAIMS, INJURIES, DAMAGES, LOSSES,

ARISING FROM ANY UNAUTHORIZED TRANSFER, REUSE OR

EXPENSES, AND ATTORNEY'S FEES ARISING OUT OF THE MODIFICATION OR REUSE OF THESE MATERIALS.

6. THESE DRAWINGS AS PART OF THE CONTRACT DOCUMENTS ARE DIAGRAMMATIC AND ARE NOT INTENDED TO DEFINE EXACT QUANTITIES, LOCATIONS OR CODIFIED REQUIREMENTS, THE DRAWINGS SHALL NOT BE SCALED, EXACT STATE AND LOCAL CODE REQUIREMENTS AND OTHER APPLICABLE CODE REQUIREMENTS SHALL BE VERIFIED BY AND ARE THE SOLE RESPONSIBILITY OF THIS CONTRACTOR. ANY INFORMATION WHICH DIRECTLY CONFLICTS WITH ANY OF THESE CODES OR ANY DISCREPANCIES FOUND IN THE CONTRACT DOCUMENTS SHALL BE BROUGHT TO THE ATTENTION OF THE PROJECT ARCHITECT.

Bid Set

PROJECT DATE 09/06/2017
PROJECT #: 14105

Issue Description Date
1 ADDENDUM 2 09/18/17

W/ 2" HOOK - NO GREATER THAN 12"

FROM INSIDE OR OUTSIDE CORNER

BEYOND. IF INBED ANCHOR BOLT CONFLICTS W/WD POST, INSTALL 8"

OPENINGS AND THEN SPACED 48" OC

ALL EXTERIOR CONCRETE JOINTS TO

SOIL BEARING PRESSURE IS 3000 PSI

SOILS ENGINEER TO INSPECT FOOTING

EXCAVATIONS PRIOR TO PLACEMENT

OF CONCRETE AND REINFORCING

AND WITHIN 8" OF ALL DOOR

WEDGE ANCHOR.


BE TOOLED.


BUILDING A FOUNDATION PLAN

S101A



www.berardipartners.com

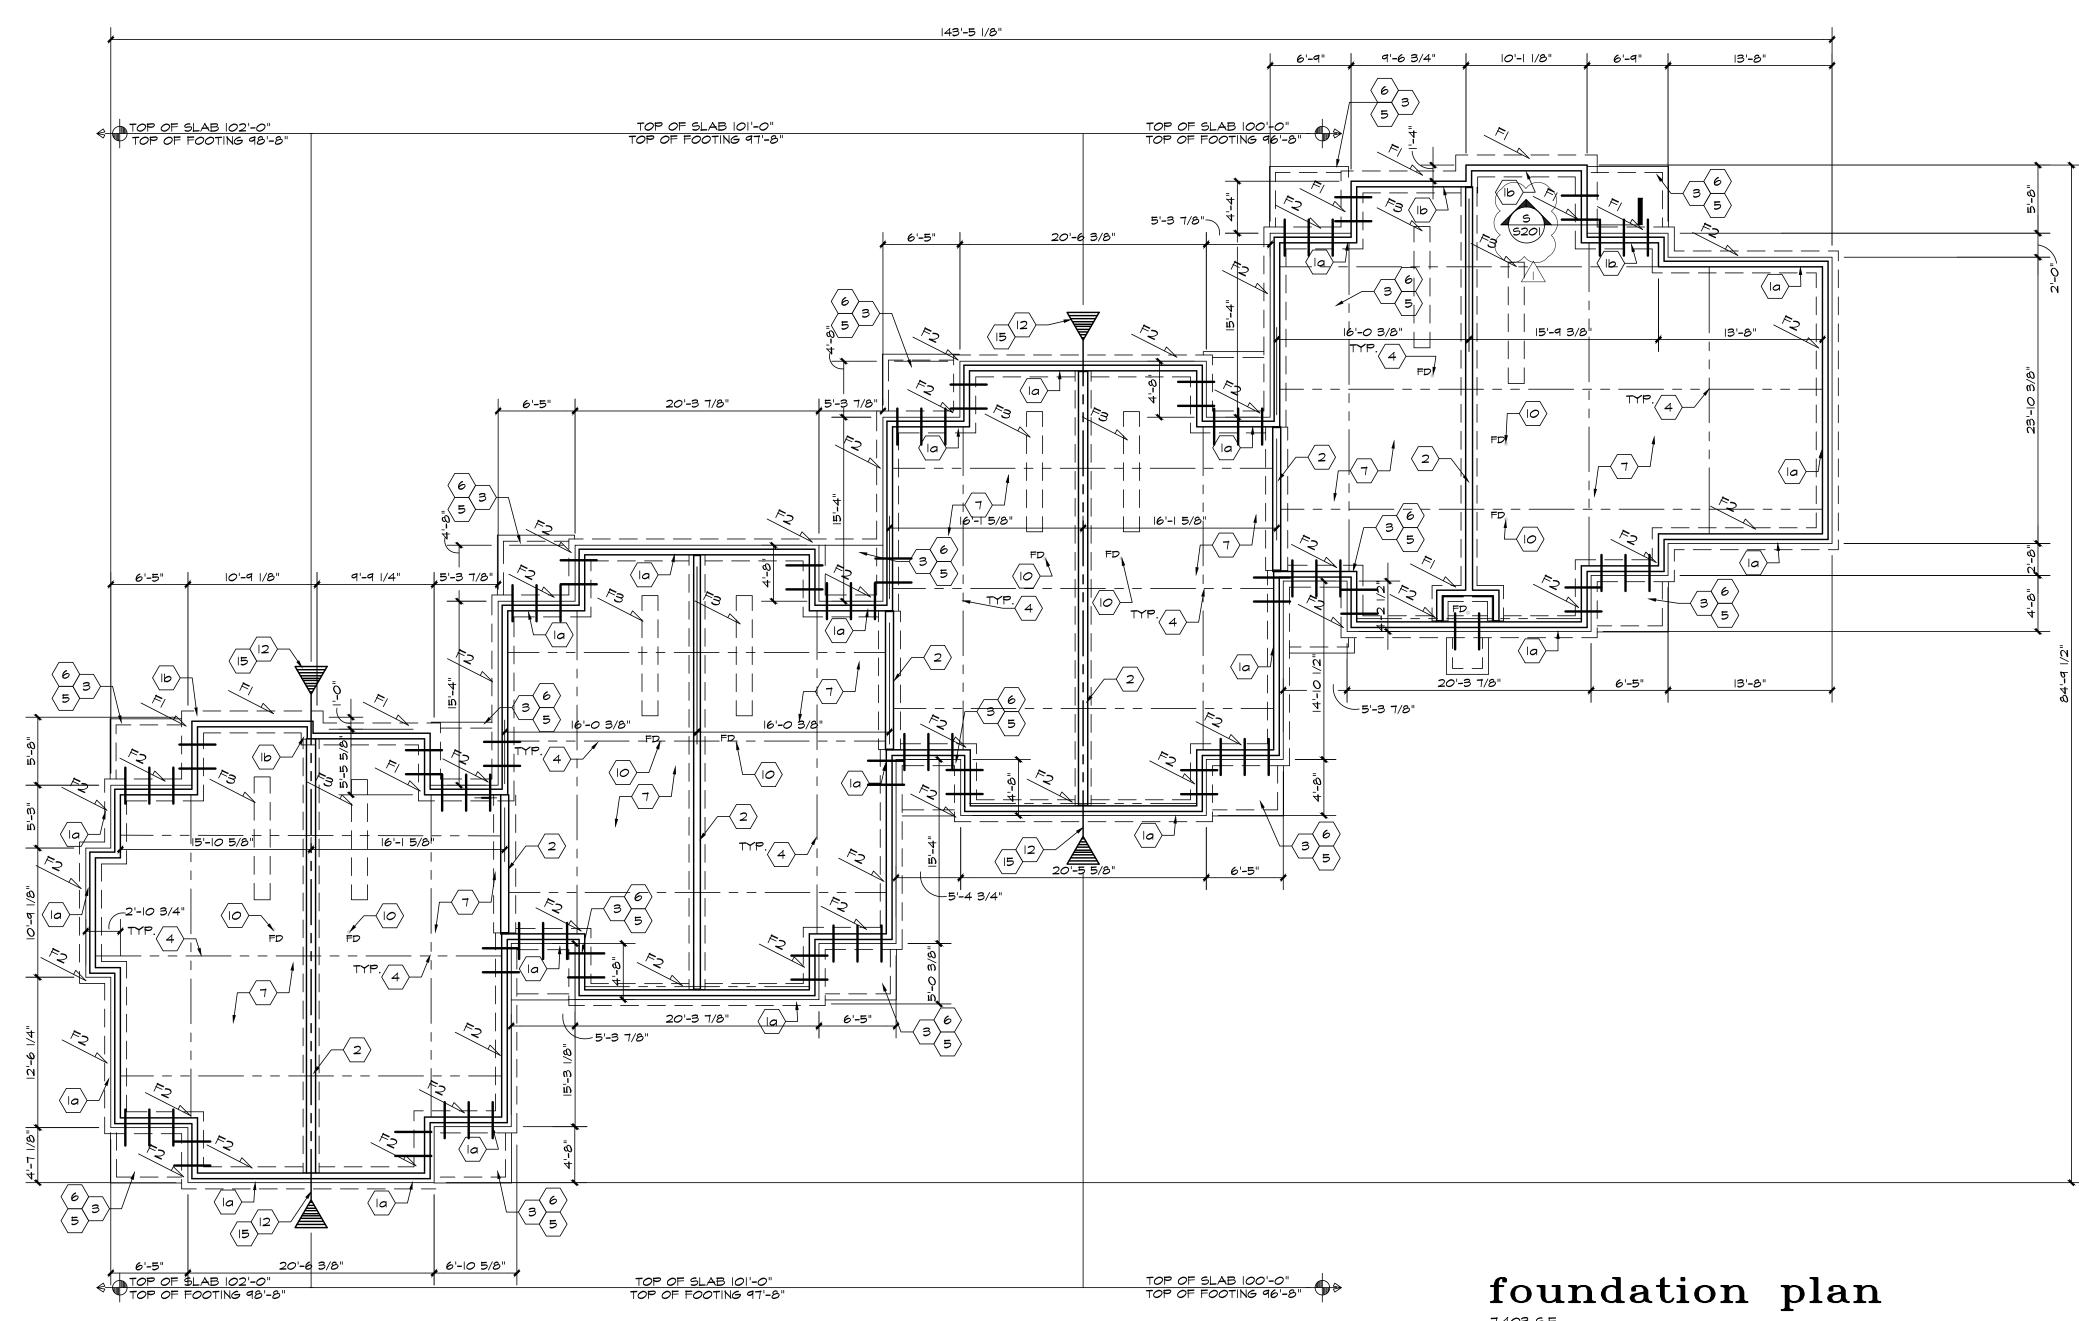

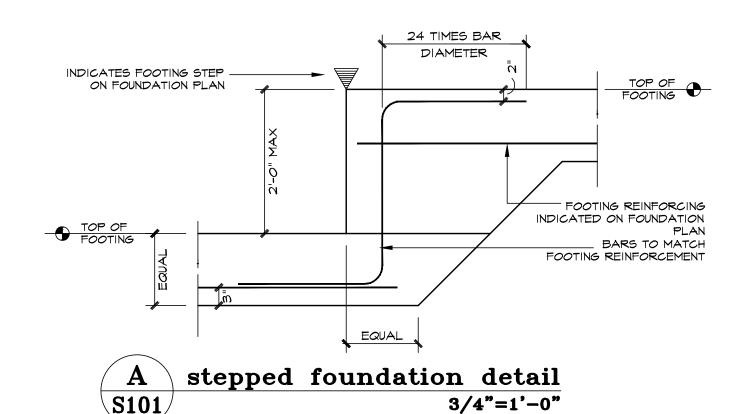

ž ×

Q Q


B X

₹ X

## coded notes (x)


- POURED CONCRETE FOUNDATION STEM WALL ON POURED CONCRETE FOOTING SEE FOUNDATION SCHEDULE. (BOTTOM OF ALL PERIMETER AND BUILDING EXTERIOR FOUNDATION SYSTEMS TO BE 42" MINIMUM BELOW FINISH GRADE.)
- a. 10" MASONRY STEM WALL PLUS BRICK VENEER DETAILS ON S201.
- b. 8" MASONRY STEM WALL PLUS STONE VENEER AND SIDING DETAILS ON
- 2. POURED CONCRETE THICKENED SLAB (SEE FOOTING SCHEDULE). SEE DETAIL S201 3. 4" THICK CONCRETE STOOP/SLAB W/ FIBROUS REINFORCING AND 42" DEEP TURNED DOWN EDGE ON GRAVEL - SEE DETAIL E/S201 & F/S201. (SEE SECTIONS FOR DEEPER SLAB EDGE ) TOOLED JOINTS AS INDICATED. HAND SMIRLED FINISH
- W/PICTURE FRAME JOINTS AND EDGES. 4. SAW CUT CONTROL JOINT. SEE DETAIL 6/S201.
- 5. #4 BENT REBAR @ 16" O.C. AT EXTERIOR WALL ABUTMENT. FIRST AND LAST DOWEL PLACED W/IN 12" OF WALL. SEE DET. B/S201 SIM.
- 6. #4 BENT REBAR @ 16" O.C. AT EXTERIOR DOOR LOCATION. FIRST AND LAST DOWEL PLACED W/IN 12" OF WALL. SEE DET. A/S201 SIM.
- 7. 4" CONC. SLAB W/ WITH FIBROUS REINFORCING ON 6 MIL. POLY VAPOR BARRIER ON 4" GRANULAR FILL, TYPICAL.
- 8. CONT. FTG. FOR SHEAR WALL. SEE SECTION E/A601 THICKEN FOOTING HOLD-DOWN
- TO 15" 1'-0" PAST HOLD DOWN ALL DIRECTIONS.
- 9. INTERIOR CONCRETE FOOTING FOR WOOD COLUMN
- 10. RECESSED FLOOR DRAINS 1/8" PER FT WITHIN AREA SERVED, TYP.
- COORDINATE WITH MP FOR EQUIPMENT LAYOUT. II. CONCRETE SLAB TO BE DEPRESSED AT FIRST FLOOR SHOWERS, SEE DETAIL
- P/S201. 12. STEPPED FOOTING LOCATION. REFER TO DETAIL A/SIOI.
- 13. KEYED CONSTRUCTION JOINT FOR THICKENED SLAB STEPPED 8" / FOUNDATION
- STEPPED EA. END REFER TO ELEVATIONS AND RELATED DETAIL. 14. 12" DIA. x 42" DP. CONC. POST FOOTING / 1" ISOLATION JOINT BETWEEN POST FOOTING
- AND CONC. SLAB (U.N.O. TYPICAL OF ALL POST COLUMNS ALL BLDGS TYP.) 15. SEE DETAIL M/S201 FOR STEPPED CONDITION @ EXTERIOR SLAB

# 1/8"=1'-0"

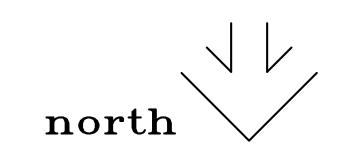

footing schedule									
MARK	SIZE	REINFORCING	LOCATION	CODED NOTE					
FI	1'-8" W. X 10" D. MIN.	(2) #4'S CONT. BOTTOM	EXT. WALL FTG.	I					
F2	1'-10" W. X 10" D. MIN.	(2) #5'S CONT. BOTTOM	EXT. WALL FTG.	I					
F3	I'-6" W. X I2" D. THICKENED SLAB	(3) #5'S CONT. BOTTOM	INT. WALL FTG.	2					
F4	2'-6" SQ. × 12" D.	(3) #4'S EACH WAY	COLUMN FTG.	9					

NOTES: CODED NOTES APPLY TO ENTIRE BUILDING. INDIVIDUAL IDENTIFICATION IS FOR REFERENCE MATERIALS TO BE INSTALLED PER MANUFACTURERS MOST CURRENT WRITTEN INSTALLATION INSTRUCTIONS

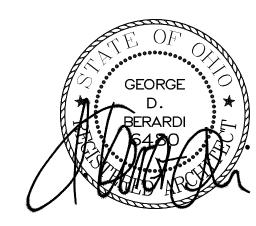

# LMHA Collingwood Green, Phase III





THE ARRANGEMENTS DEPICTED HEREIN ARE THE SOLE PROPERTY OF BERARDI + PARTNERS, INC., ARCHITECTS AND ENGINEERS, AND MAY NOT BE REPRODUCED WITHOUT ITS WRITTEN PERMISSION

NOTE:

1. ALL BIDDERS SHALL VISIT THE SITE AND BECOME FAMILIAR W/
THE EXISTING CONDITIONS AND REQUIREMENTS OF THE PROJECT
AND SHALL NOTIFY THE ARCHITECT OF ANY ERRORS AND OMISSIONS
SUBSEQUENTLY DISCOVERED IN THE CONTRACT DOCUMENTS.

2. THE CONTRACT DOCUMENTS ARE COMPRISED OF THE DRAWINGS AND THE PROJECT MANUAL IN THEIR ENTIRETY. THE INFORMATION IN THESE DOCUMENTS IS DEPENDENT UPON AND COMPLEMENTARY OF EACH OTHER. SEPARATION OF THE CONTRACT DOCUMENTS SHALL NOT BE PERMITTED. IF THE CONTRACTOR CHOOSES TO SEPARATE THE DOCUMENTS, THEY DO SO AT THEIR OWN RISK AND EXPENSE.

3. ADDITIONALLY, SEE GENERAL INFORMATION ON "AO" SHEETS 4. THE CLIENT ACKNOWLEDGES THE CONSULTANT'S (ARCHITECT) DRAWINGS AND SPECIFICATION, INCLUDING ALL DOCUMENTS ON ELECTRONIC MEDIA AS INSTRUMENTS OF THE CONSULTANTS (ARCHITECT) PROFESSIONAL SERVICE. THE CLIENT SHALL NOT REUSE OR MAKE OR PERMIT TO BE MADE ANY MODIFICATION TO THE DRAWINGS AND SPECIFICATIONS WITHOUT THE PRIOR WRITTEN AUTHORIZATION OF THE CONSULTANT (ARCHITECT). THE CLIENT AGREES TO WAIVE ANY CLAIM AGAINST THE CONSULTANT (ARCHITECT)

MODIFICATION OF THE DRAWINGS AND SPECIFICATIONS. 5. ARCHITECT CANNOT WARRANT THE ACCURACY OF DATA CONTAINED HEREIN, ANY USE OR REUSE OF ORIGINAL OR ALTERED CADD DESIGN MATERIALS BY THE USER OR OTHER PARTIES WITHOUT THE REVIEW AND WRITTEN APPROVAL OF THE ARCHITECT SHALL BE AT THE SOLE RISK OF THE USER. FURTHERMORE, USER AGREES T DEFEND, INDEMNIFY, AND HOLD ARCHITECT HARMLESS FROM ALL CLAIMS, INJURIES, DAMAGES, LOSSES, EXPENSES, AND ATTORNEYS FEES ARISING OUT OF THE MODIFICATION OR REUSE OF THESE MATERIALS.

ARISING FROM ANY UNAUTHORIZED TRANSFER, REUSE OR

6. THESE DRAWINGS AS PART OF THE CONTRACT DOCUMENTS ARE DIAGRAMMATIC AND ARE NOT INTENDED TO DEFINE EXACT QUANTITIES, LOCATIONS OR CODIFIED REQUIREMENTS. THE DRAWINGS SHALL NOT BE SCALED, EXACT STATE AND LOCAL CODE REQUIREMENTS AND OTHER APPLICABLE CODE REQUIREMENTS SHALL BE VERIFIED BY AND ARE THE SOLE RESPONSIBILITY OF THIS CONTRACTOR. ANY INFORMATION WHICH DIRECTLY CONFLICTS WITH ANY OF THESE CODES OR ANY DISCREPANCIES FOUND IN THE CONTRACT DOCUMENTS SHALL BE BROUGHT TO THE ATTENTION OF THE PROJECT ARCHITECT.

Bid Set

PROJECT DATE 09/06/2017 14105 PROJECT #:

ADDENDUM 2 09/18/17

1/2" Φ X 18" ANCHOR BOLTS 48" O.C. W/ 2" HOOK - NO GREATER THAN 12" FROM INSIDE OR OUTSIDE CORNER

OPENINGS AND THEN SPACED 48" OC

ALL EXTERIOR CONCRETE JOINTS TO

SOIL BEARING PRESSURE IS 3000 PS

SOILS ENGINEER TO INSPECT FOOTING

EXCAVATIONS PRIOR TO PLACEMENT

OF CONCRETE AND REINFORCING

BEYOND. IF INBED ANCHOR BOLT

CONFLICTS W/ WD POST, INSTALL 8"

AND WITHIN 8" OF ALL DOOR

WEDGE ANCHOR.


BE TOOLED.

**BUILDING B** FOUNDATION PLAN

S101B



Phone (614)221-1110) Fax (614)221-0831 www.berardipartners.com

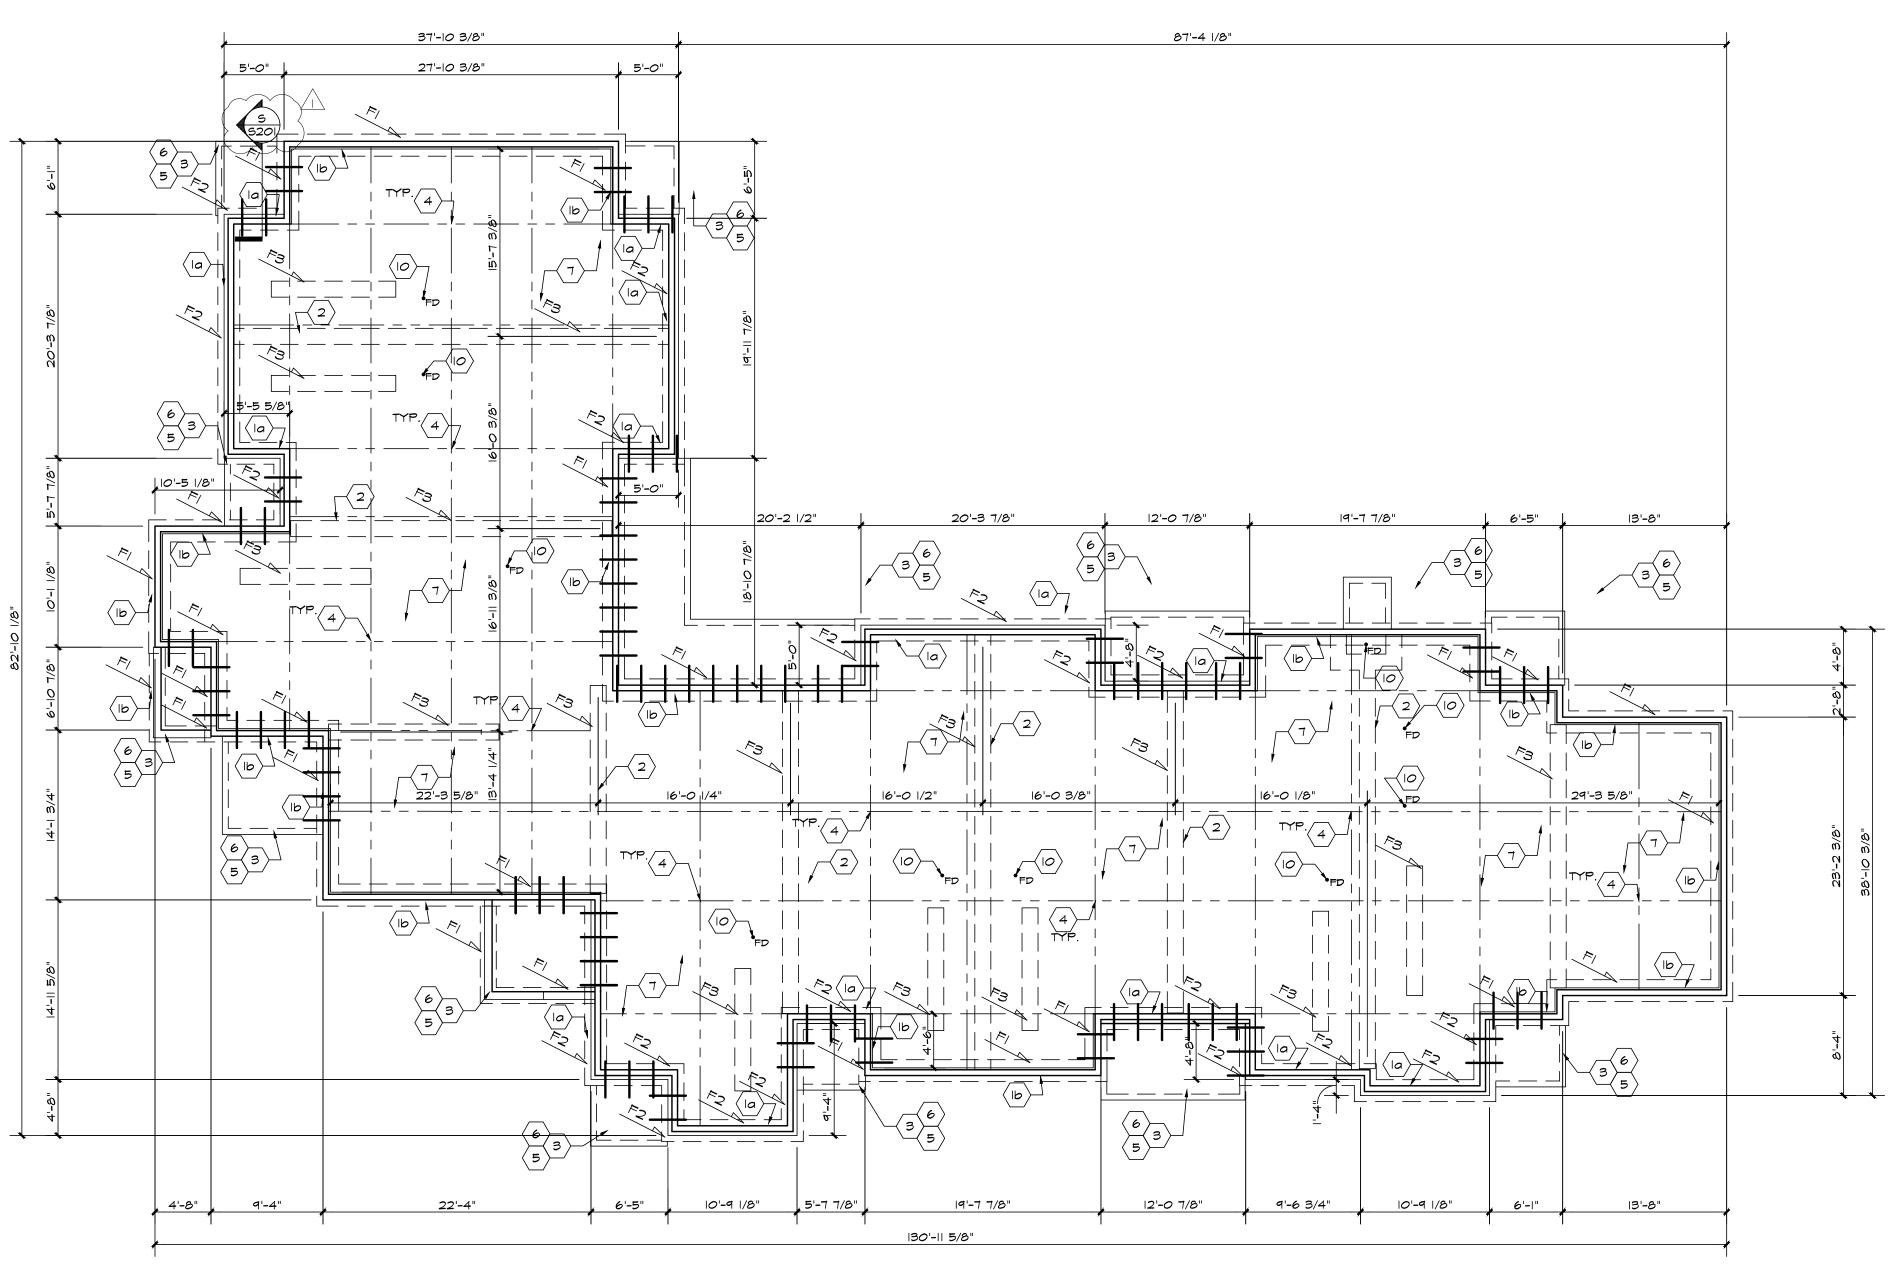

# foundation plan 1/8"=1'-0"

# north

footing schedule										
MARK	SIZE	REINFORCING	LOCATION	CODED NOTE						
FI	1'-8" W. X 10" D. MIN.	(2) #4'S CONT. BOTTOM	EXT. WALL FTG.	1						
F2	1'-10" W. X 10" D. MIN.	(2) #5'S CONT. BOTTOM	EXT. WALL FTG.	I						
F3	I'-6" W. X I2" D. THICKENED SLAB	(3) #5'S CONT. BOTTOM	INT. WALL FTG.	2						
F4	2'-6" 5Q. × 12" D.	(3) #4'S EACH WAY	COLUMN FTG.	9						

NOTES: CODED NOTES APPLY TO ENTIRE BUILDING. INDIVIDUAL IDENTIFICATION IS FOR REFERENCE MATERIALS TO BE INSTALLED PER MANUFACTURERS MOST CURRENT WRITTEN INSTALLATION INSTRUCTIONS

LMHA Collingwood Green, Phase III





THE ARRANGEMENTS DEPICTED HEREIN ARE THE SOLE PROPERTY OF BERARDI + PARTNERS, INC., ARCHITECTS AND ENGINEERS, AND MAY NOT BE REPRODUCED WITHOUT ITS WRITTEN PERMISSION

NOTE:

1. ALL BIDDERS SHALL VISIT THE SITE AND BECOME FAMILIAR W/
THE EXISTING CONDITIONS AND REQUIREMENTS OF THE PROJECT
AND SHALL NOTIFY THE ARCHITECT OF ANY ERRORS AND OMISSIONS
SUBSEQUENTLY DISCOVERED IN THE CONTRACT DOCUMENTS.

2. THE CONTRACT DOCUMENTS ARE COMPRISED OF THE DRAWINGS AND THE PROJECT MANUAL IN THEIR ENTIRETY. THE INFORMATION IN THESE DOCUMENTS IS DEPENDENT UPON AND COMPLEMENTARY OF EACH OTHER. SEPARATION OF THE CONTRACT DOCUMENTS SHALL NOT BE PERMITTED. IF THE CONTRACTOR CHOOSES TO SEPARATE THE DOCUMENTS, THEY DO SO AT THEIR OWN RISK AND EXPENSE.

3. ADDITIONALLY, SEE GENERAL INFORMATION ON "AO" SHEETS 4. THE CLIENT ACKNOWLEDGES THE CONSULTANT'S (ARCHITECT) DRAWINGS AND SPECIFICATION, INCLUDING ALL DOCUMENTS ON ELECTRONIC MEDIA AS INSTRUMENTS OF THE CONSULTANTS (ARCHITECT) PROFESSIONAL SERVICE. THE CLIENT SHALL NOT REUSE OR MAKE OR PERMIT TO BE MADE ANY MODIFICATION TO THE DRAWINGS AND SPECIFICATIONS WITHOUT THE PRIOR WRITTEN AUTHORIZATION OF THE CONSULTANT (ARCHITECT). THE CLIENT AGREES TO WAIVE ANY CLAIM AGAINST THE CONSULTANT (ARCHITECT) ARISING FROM ANY UNAUTHORIZED TRANSFER, REUSE OR

5. ARCHITECT CANNOT WARRANT THE ACCURACY OF DATA CONTAINED HEREIN, ANY USE OR REUSE OF ORIGINAL OR ALTERED CADD DESIGN MATERIALS BY THE USER OR OTHER PARTIES WITHOUT THE REVIEW AND WRITTEN APPROVAL OF THE ARCHITECT SHALL BE AT THE SOLE RISK OF THE USER. FURTHERMORE, USER AGREES T DEFEND, INDEMNIFY, AND HOLD ARCHITECT HARMLESS FROM ALL CLAIMS, INJURIES, DAMAGES, LOSSES, EXPENSES, AND ATTORNEY'S FEES ARISING OUT OF THE MODIFICATION OR REUSE OF THESE MATERIALS.

MODIFICATION OF THE DRAWINGS AND SPECIFICATIONS.

6. THESE DRAWINGS AS PART OF THE CONTRACT DOCUMENTS ARE DIAGRAMMATIC AND ARE NOT INTENDED TO DEFINE EXACT QUANTITIES, LOCATIONS OR CODIFIED REQUIREMENTS. THE DRAWINGS SHALL NOT BE SCALED, EXACT STATE AND LOCAL CODE REQUIREMENTS AND OTHER APPLICABLE CODE REQUIREMENTS SHALL BE VERIFIED BY AND ARE THE SOLE RESPONSIBILITY OF THIS CONTRACTOR. ANY INFORMATION WHICH DIRECTLY CONFLICTS WITH ANY OF THESE CODES OR ANY DISCREPANCIES FOUND IN THE CONTRACT DOCUMENTS SHALL BE BROUGHT TO THE ATTENTION OF THE PROJECT ARCHITECT.

Bid Set

PROJECT DATE 09/06/2017 14105 PROJECT #:

ADDENDUM 2 09/18/17

1/2" Φ X 18" ANCHOR BOLTS 48" O.C. W/ 2" HOOK - NO GREATER THAN 12" FROM INSIDE OR OUTSIDE CORNER

OPENINGS AND THEN SPACED 48" OC

ALL EXTERIOR CONCRETE JOINTS TO

SOIL BEARING PRESSURE IS 3000 PSI SOILS ENGINEER TO INSPECT FOOTING

EXCAVATIONS PRIOR TO PLACEMENT

OF CONCRETE AND REINFORCING

BEYOND. IF INBED ANCHOR BOLT

CONFLICTS W/ WD POST, INSTALL 8"

AND WITHIN 8" OF ALL DOOR

WEDGE ANCHOR.

BE TOOLED.

**BUILDING C** FOUNDATION PLAN

S101C



# coded notes (x)

DETAILS ON S201.

- POURED CONCRETE FOUNDATION STEM WALL ON POURED CONCRETE FOOTING SEE FOUNDATION SCHEDULE. (BOTTOM OF ALL PERIMETER AND BUILDING EXTERIOR FOUNDATION SYSTEMS TO BE 42" MINIMUM BELOW FINISH GRADE.)
  - a. 10" POURED CONCRETE STEM WALL PLUS BRICK VENEER DETAILS ON S201.
    b. 8" POURED CONCRETE STEM WALL - PLUS STONE VENEER AND SIDING
- 2. POURED CONCRETE THICKENED SLAB (SEE FOOTING SCHEDULE). SEE DETAIL S201 3. 4" THICK CONCRETE STOOP/SLAB W/ FIBROUS REINFORCING AND 42" DEEP TURNED DOWN EDGE ON GRAVEL - SEE DETAIL F/S201. (SEE SECTIONS FOR DEEPER SLAB EDGE ) TOOLED JOINTS AS INDICATED. HAND SWIRLED FINISH W/PICTURE FRAME JOINTS AND EDGES.
- 4. SAW CUT CONTROL JOINT. SEE DETAIL G/S201.
- 5. #4 BENT REBAR @ 16" O.C. AT EXTERIOR WALL ABUTMENT. FIRST AND LAST DOWEL PLACED W/IN 12" OF WALL. SEE DET. B/S201 SIM.
- 6. #4 BENT REBAR @ 16" O.C. AT EXTERIOR DOOR LOCATION. FIRST AND LAST DOWEL PLACED W/IN 12" OF WALL. SEE DET. A/S201 SIM.
- 7. 4" CONC. SLAB W/ WITH FIBROUS REINFORCING ON 6 MIL. POLY VAPOR BARRIER ON 4" GRANULAR FILL, TYPICAL.
- 8. CONT. FTG. FOR SHEAR WALL. SEE SECTION E/A601 THICKEN FOOTING HOLD-DOWN TO 15" - 1'-0" PAST HOLD DOWN ALL DIRECTIONS.
- 9. INTERIOR CONCRETE FOOTING FOR WOOD COLUMN


ž ×


O O

a ×

∃ X

- 10. RECESSED FLOOR DRAINS 1/8" PER FT WITHIN AREA SERVED, TYP.
- COORDINATE WITH MP FOR EQUIPMENT LAYOUT. II. CONCRETE SLAB TO BE DEPRESSED AT FIRST FLOOR SHOWERS, SEE DETAIL P/SIOI.
- 12. STEPPED FOOTING LOCATION, REFER TO DETAIL A/SIOI.
- 13. KEYED CONSTRUCTION JOINT FOR THICKENED SLAB STEPPED 8" / FOUNDATION STEPPED EA. END - REFER TO ELEVATIONS AND RELATED DETAIL.
- 14. 12" DIA.  $\times$  42" DP. CONC. POST FOOTING / 1" ISOLATION JOINT BETWEEN POST FOOTING AND CONC. SLAB (U.N.O. TYPICAL OF ALL POST COLUMNS ALL BLDGS TYP.)
- 15. SEE DETAIL M/S201 FOR STEPPED CONDITION @ EXTERIOR SLAB

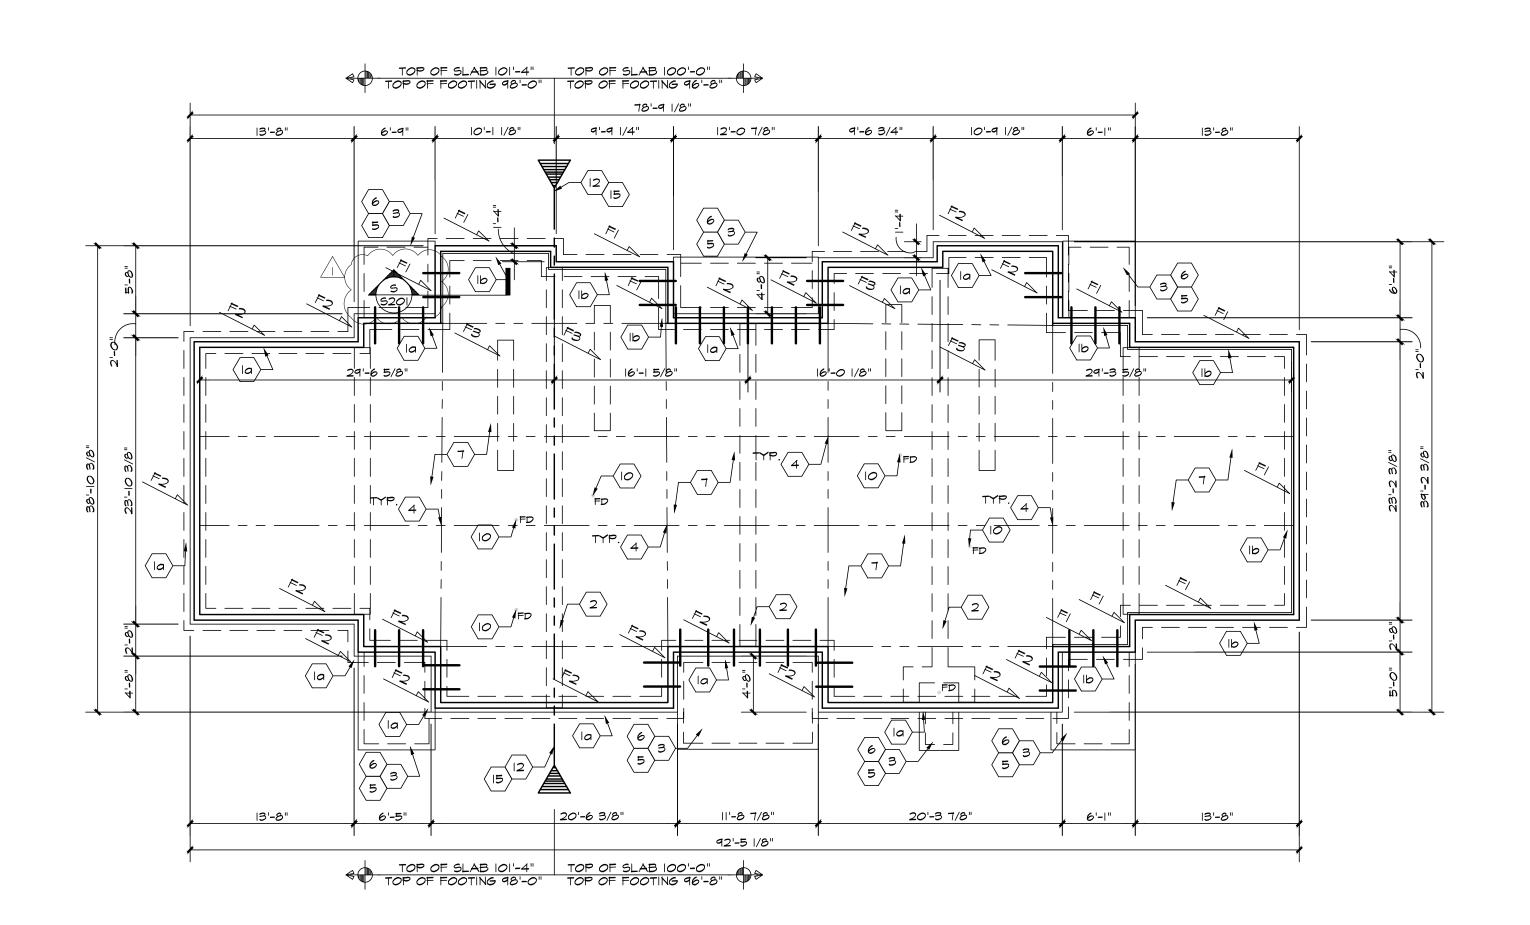

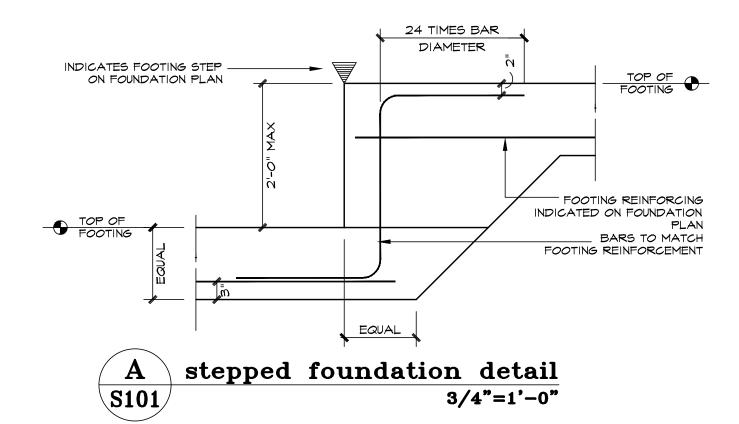

ž ×

Q Q

a ×


₹ X

# coded notes (x)

- POURED CONCRETE FOUNDATION STEM WALL ON POURED CONCRETE FOOTING SEE FOUNDATION SCHEDULE. (BOTTOM OF ALL PERIMETER AND BUILDING EXTERIOR FOUNDATION SYSTEMS TO BE 42" MINIMUM BELOW FINISH GRADE.)
- a. 10" MASONRY STEM WALL PLUS BRICK VENEER DETAILS ON S201.
- b. 8" MASONRY STEM WALL PLUS STONE VENEER AND SIDING DETAILS ON
- 2. POURED CONCRETE THICKENED SLAB (SEE FOOTING SCHEDULE). SEE DETAIL S201
  3. 4" THICK CONCRETE STOOP/SLAB W/ FIBROUS REINFORCING AND 42" DEEP TURNED DOWN EDGE ON GRAVEL SEE DETAIL E/S201 & F/S201. (SEE SECTIONS FOR DEEPER SLAB EDGE) TOOLED JOINTS AS INDICATED. HAND SWIRLED FINISH
- W/PICTURE FRAME JOINTS AND EDGES.
  4. SAW CUT CONTROL JOINT. SEE DETAIL G/S201.
- 5. #4 BENT REBAR @ 16" O.C. AT EXTERIOR WALL ABUTMENT. FIRST AND LAST DOWEL PLACED W/IN 12" OF WALL. SEE DET. B/S201 SIM.
- 6. #4 BENT REBAR @ 16" O.C. AT EXTERIOR DOOR LOCATION. FIRST AND LAST DOWEL PLACED W/IN 12" OF WALL. SEE DET. A/S201 SIM.
- 7. 4" CONCRETE SLAB ON GRADE W/ WITH FIBROUS REINFORCING ON 6 MIL. POLY VAPOR BARRIER ON 4" GRANULAR FILL, TYPICAL.
- 8. CONT. FTG. FOR SHEAR WALL. SEE SECTION E/A601 THICKEN FOOTING HOLD-DOWN TO 15" 1'-0" PAST HOLD DOWN ALL DIRECTIONS.
- 9. INTERIOR CONCRETE FOOTING FOR WOOD COLUMN
- 10. RECESSED FLOOR DRAINS 1/8" PER FT WITHIN AREA SERVED, TYP.
- COORDINATE WITH MP FOR EQUIPMENT LAYOUT.

  II. CONCRETE SLAB TO BE DEPRESSED AT FIRST FLOOR SHOWERS, SEE DETAIL
- P/S201. 12. STEPPED FOOTING LOCATION. REFER TO DETAIL A/SIOI.
- 13. KEYED CONSTRUCTION JOINT FOR THICKENED SLAB STEPPED 8" / FOUNDATION STEPPED EA. END REFER TO ELEVATIONS AND RELATED DETAIL.
- 14. 12" DIA. × 42" DP. CONC. POST FOOTING / 1" ISOLATION JOINT BETWEEN POST FOOTING
- AND CONC. SLAB (U.N.O. TYPICAL OF ALL POST COLUMNS ALL BLDGS TYP.)
  15. SEE DETAIL M/S201 FOR STEPPED CONDITION @ EXTERIOR SLAB

# foundation plan 1/8"=1'-0"

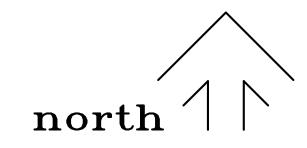

footing schedule									
MARK	SIZE	REINFORCING	LOCATION	CODED NOTE					
FI	1'-8" W. X 10" D. MIN.	(2) #4'S CONT. BOTTOM	EXT. WALL FTG.	I					
F2	1'-10" W. X 10" D. MIN.	(2) #5'S CONT. BOTTOM	EXT. WALL FTG.	I					
F3	I'-6" W. X I2" D. THICKENED SLAB	(3) #5'S CONT. BOTTOM	INT. WALL FTG.	2					
F4	2'-6" SQ. × 12" D.	(3) #4'S EACH WAY	COLUMN FTG.	9					

NOTES:
CODED NOTES APPLY TO ENTIRE BUILDING.
INDIVIDUAL IDENTIFICATION IS FOR REFERENCE
ONLY.
MATERIALS TO BE INSTALLED PER MANUFACTURERS
MOST CURRENT WRITTEN INSTALLATION
INSTRUCTIONS

September 18, 2017

LMHA Collingwood Green, Phase III





THE ARRANGEMENTS DEPICTED HEREIN ARE THE SOLE PROPERTY OF BERARDI + PARTNERS, INC., ARCHITECTS AND ENGINEERS, AND MAY NOT BE REPRODUCED WITHOUT ITS WRITTEN PERMISSION

NOTE:

1. ALL BIDDERS SHALL VISIT THE SITE AND BECOME FAMILIAR W/
THE EXISTING CONDITIONS AND REQUIREMENTS OF THE PROJECT
AND SHALL NOTIFY THE ARCHITECT OF ANY ERRORS AND OMISSIONS
SUBSEQUENTLY DISCOVERED IN THE CONTRACT DOCUMENTS.

2. THE CONTRACT DOCUMENTS ARE COMPRISED OF THE DRAWINGS AND THE PROJECT MANUAL IN THEIR ENTIRETY. THE INFORMATION IN THESE DOCUMENTS IS DEPENDENT UPON AND COMPLEMENTARY OF EACH OTHER. SEPARATION OF THE CONTRACT DOCUMENTS SHALL NOT BE PERMITTED. IF THE CONTRACT OCCUMENTS SHALL THE DOCUMENTS, THEY DO SO AT THEIR OWN RISK AND EXPENSE.

3. ADDITIONALLY, SEE GENERAL INFORMATION ON "AO" SHEETS.

4. THE CLIENT ACKNOWLEDGES THE CONSULTANT'S (ARCHITECT) DRAWINGS AND SPECIFICATION, INCLUDING ALL DOCUMENTS ON ELECTRONIC MEDIA AS INSTRUMENTS OF THE CONSULTANTS (ARCHITECT) PROFESSIONAL SERVICE. THE CLIENT SHALL NOT REUSE OR MAKE OR PERMIT TO BE MADE ANY MODIFICATION TO THE DRAWINGS AND SPECIFICATIONS WITHOUT THE PRIOR WRITTEN AUTHORIZATION OF THE CONSULTANT (ARCHITECT). THE CLIENT AGREES TO MAIVE ANY CLAIM AGAINST THE CONSULTANT (ARCHITECT) ARISING FROM ANY UNAUTHORIZED TRANSFER, REUSE OR

5. ARCHITECT CANNOT WARRANT THE ACCURACY OF DATA CONTAINED HEREIN. ANY USE OR REUSE OF ORIGINAL OR ALTERED CADD DESIGN MATERIALS BY THE USER OR OTHER PARTIES WITHOUT THE REVIEW AND WRITTEN APPROVAL OF THE ARCHITECT SHALL BE AT THE SOLE RISK OF THE USER. FURTHERMORE, USER AGREES TO DEFEND, INDEMNIFY, AND HOLD ARCHITECT HARMLESS FROM ALL CLAIMS, INJURIES, DAMAGES, LOSSES, EXPENSES, AND ATTORNEY'S FEES ARISING OUT OF THE MODIFICATION OR REUSE OF THESE MATERIALS.

MODIFICATION OF THE DRAWINGS AND SPECIFICATIONS.

6. THESE DRAWINGS AS PART OF THE CONTRACT DOCUMENTS ARE DIAGRAMMATIC AND ARE NOT INTENDED TO DEFINE EXACT QUANTITIES, LOCATIONS OR CODIFIED REQUIREMENTS. THE DRAWINGS SHALL NOT BE SCALED. EXACT STATE AND LOCAL CODE REQUIREMENTS AND OTHER APPLICABLE CODE REQUIREMENTS SHALL BE VERIFIED BY AND ARE THE SOLE RESPONSIBILITY OF THIS CONTRACTOR. ANY INFORMATION WHICH DIRECTLY CONFLICTS WITH ANY OF THESE CODES OR ANY DISCREPANCIES FOUND IN THE CONTRACT DOCUMENTS SHALL BE BROUGHT TO THE ATTENTION OF THE PROJECT ARCHITECT.

Bid Set

PROJECT DATE 09/06/2017
PROJECT #: 14105

Issue Description Date
1 ADDENDUM 2 09/18/17

1/2" Φ X 18" ANCHOR BOLTS 48" O.C. W/ 2" HOOK - NO GREATER THAN 12" FROM INSIDE OR OUTSIDE CORNER

OPENINGS AND THEN SPACED 48" OC

ALL EXTERIOR CONCRETE JOINTS TO

SOIL BEARING PRESSURE IS 3000 PSI SOILS ENGINEER TO INSPECT FOOTING

EXCAVATIONS PRIOR TO PLACEMENT

OF CONCRETE AND REINFORCING

BEYOND. IF INBED ANCHOR BOLT

CONFLICTS W/ WD POST, INSTALL 8"

AND WITHIN 8" OF ALL DOOR


MEDGE ANCHOR.


BE TOOLED.

BUILDING D FOUNDATION PLAN

S101D



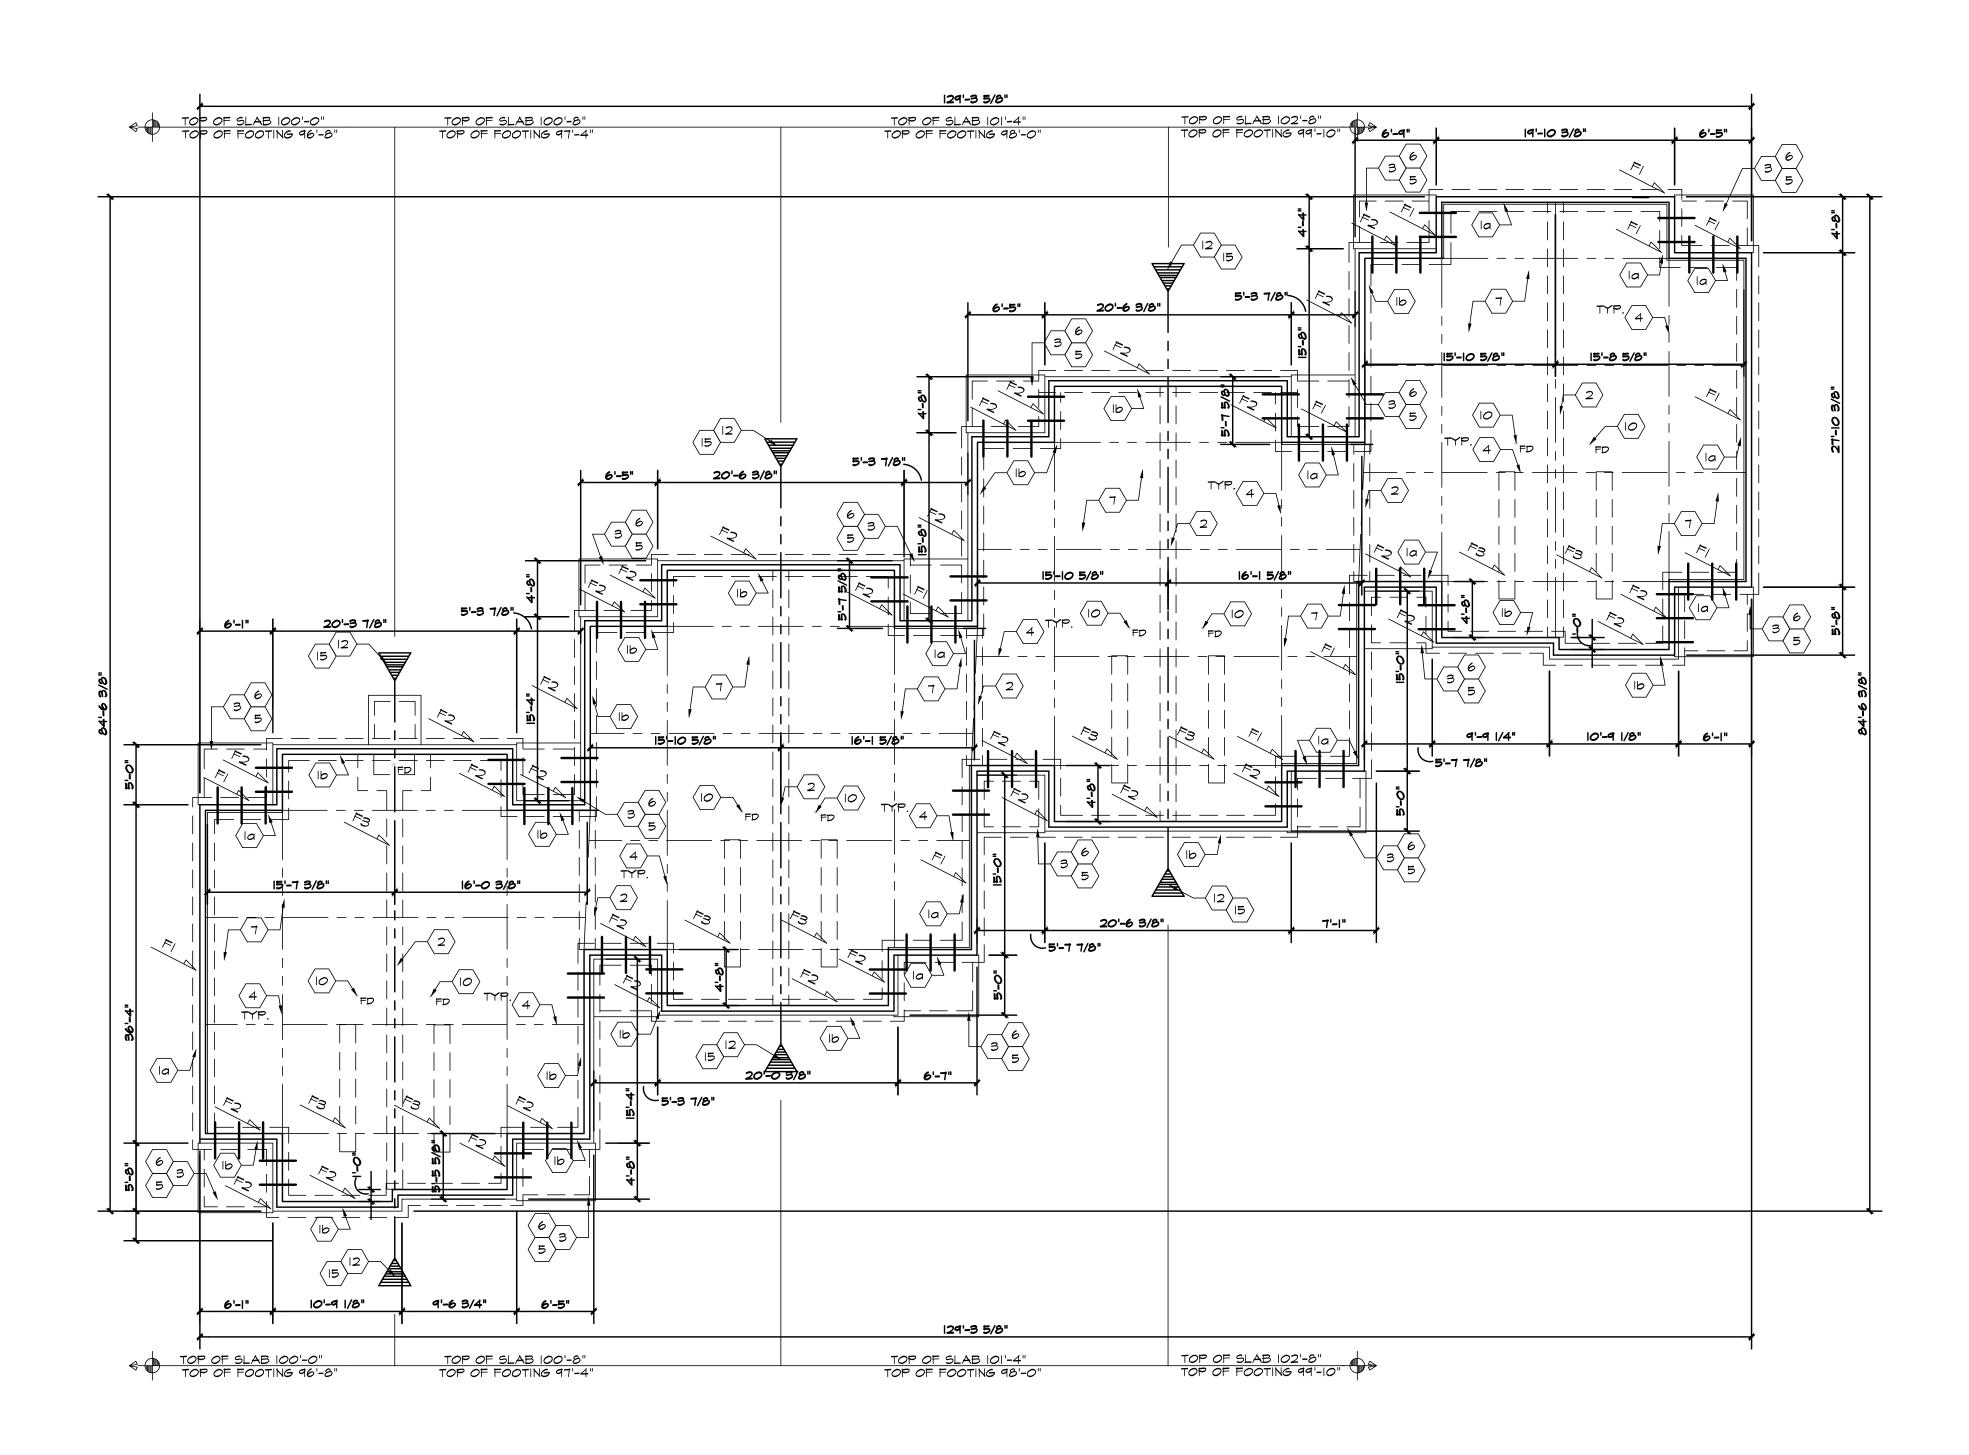


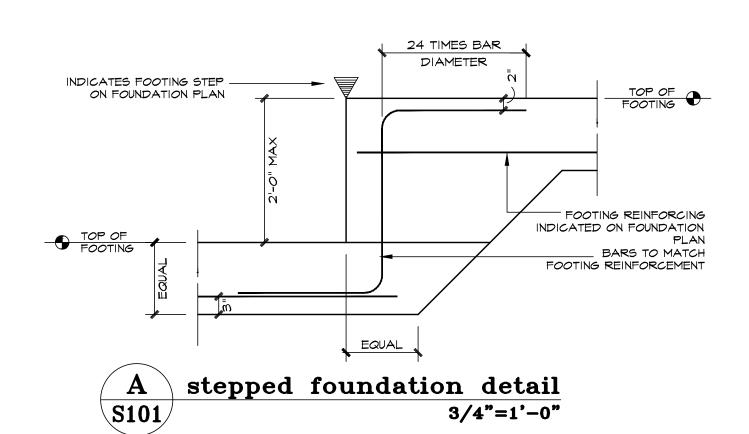

로 X

## coded notes (x)

- POURED CONCRETE FOUNDATION STEM WALL ON POURED CONCRETE FOOTING SEE FOUNDATION SCHEDULE. (BOTTOM OF ALL PERIMETER AND BUILDING EXTERIOR FOUNDATION SYSTEMS TO BE 42" MINIMUM BELOW FINISH GRADE.)
- a. 10" MASONRY STEM WALL PLUS BRICK VENEER DETAILS ON S201.
- b. 8" MASONRY STEM WALL PLUS STONE VENEER AND SIDING DETAILS ON
- 2. POURED CONCRETE THICKENED SLAB (SEE FOOTING SCHEDULE). SEE DETAIL S201 3. 4" THICK CONCRETE STOOP/SLAB W/ FIBROUS REINFORCING AND 42" DEEP TURNED DOWN EDGE ON GRAVEL - SEE DETAIL E/S201 & F/S201. (SEE SECTIONS FOR DEEPER SLAB EDGE ) TOOLED JOINTS AS INDICATED. HAND SMIRLED FINISH
- W/PICTURE FRAME JOINTS AND EDGES. 4. SAW CUT CONTROL JOINT. SEE DETAIL G/S201.
- #4 BENT REBAR @ 16" O.C. AT EXTERIOR WALL ABUTMENT. FIRST AND LAST DOWEL PLACED W/IN 12" OF WALL. SEE DET. B/S201 SIM.
- #4 BENT REBAR @ 16" O.C. AT EXTERIOR DOOR LOCATION. FIRST AND LAST
- DOWEL PLACED W/IN 12" OF WALL. SEE DET. A/S201 SIM. 7. 4" CONC. SLAB W/ WITH FIBROUS REINFORCING ON 6 MIL. POLY VAPOR BARRIER ON
- 4" GRANULAR FILL, TYPICAL. CONT. FTG. FOR SHEAR WALL. SEE SECTION E/A601 - THICKEN FOOTING HOLD-DOWN
- TO 15" 1'-0" PAST HOLD DOWN ALL DIRECTIONS. 9. INTERIOR CONCRETE FOOTING FOR WOOD COLUMN
- 10. RECESSED FLOOR DRAINS 1/8" PER FT WITHIN AREA SERVED, TYP. COORDINATE WITH MP FOR EQUIPMENT LAYOUT.
- CONCRETE SLAB TO BE DEPRESSED AT FIRST FLOOR SHOWERS, SEE DETAIL P/S201.
- 12. STEPPED FOOTING LOCATION. REFER TO DETAIL A/SIOI.
- 13. KEYED CONSTRUCTION JOINT FOR THICKENED SLAB STEPPED 8" / FOUNDATION STEPPED EA. END - REFER TO ELEVATIONS AND RELATED DETAIL.
- 14. 12" DIA.  $\times$  42" DP. CONC. POST FOOTING / 1" ISOLATION JOINT BETWEEN POST FOOTING AND CONC. SLAB (U.N.O. TYPICAL OF ALL POST COLUMNS ALL BLDGS TYP.)
- 15. SEE DETAIL M/S201 FOR STEPPED CONDITION @ EXTERIOR SLAB

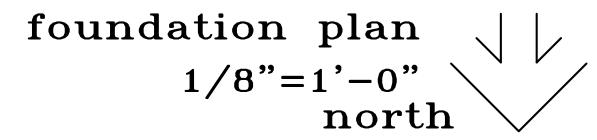

footing schedule									
MARK	SIZE	REINFORCING	LOCATION	CODED NOTE					
FI	1'-8" W. X 10" D. MIN.	(2) #4'S CONT. BOTTOM	EXT. WALL FTG.	I					
F2	1'-10" W. X 10" D. MIN.	(2) #5'S CONT. BOTTOM	EXT. WALL FTG.	I					
F3	I'-6" W. X I2" D. THICKENED SLAB	(3) #5'S CONT. BOTTOM	INT. WALL FTG.	2					
F4	2'-6" SQ. x 12" D.	(3) #4'S EACH WAY	COLUMN FTG.	9					

CODED NOTES APPLY TO ENTIRE BUILDING. INDIVIDUAL IDENTIFICATION IS FOR REFERENCE MATERIALS TO BE INSTALLED PER MANUFACTURERS MOST CURRENT WRITTEN INSTALLATION INSTRUCTIONS



# Collingwood Green, Phase III



THE ARRANGEMENTS DEPICTED HEREIN ARE THE SOLE PROPERTY OF BERARDI + PARTNERS, INC., ARCHITECTS AND ENGINEERS, AND MAY NOT BE REPRODUCED WITHOUT ITS WRITTEN PERMISSION

1. ALL BIDDERS SHALL VISIT THE SITE AND BECOME FAMILIAR W/
THE EXISTING CONDITIONS AND REQUIREMENTS OF THE PROJECT
AND SHALL NOTIFY THE ARCHITECT OF ANY ERRORS AND OMISSIONS
SUBSEQUENTLY DISCOVERED IN THE CONTRACT DOCUMENTS.

 THE CONTRACT DOCUMENTS ARE COMPRISED OF THE DRAWINGS AND THE PROJECT MANUAL IN THEIR ENTIRETY. THE INFORMATION IN THESE DOCUMENTS IS DEPENDENT UPON AND COMPLEMENTARY OF EACH OTHER, SEPARATION OF THE CONTRACT DOCUMENTS SHALL THE DOCUMENTS, THEY DO SO AT THEIR OWN RISK AND EXPENSE

3. ADDITIONALLY, SEE GENERAL INFORMATION ON "AO" SHEETS 4. THE CLIENT ACKNOWLEDGES THE CONSULTANT'S (ARCHITECT) DRAWINGS AND SPECIFICATION, INCLUDING ALL DOCUMENTS ON ELECTRONIC MEDIA AS INSTRUMENTS OF THE CONSULTANTS (ARCHITECT) PROFESSIONAL SERVICE. THE CLIENT SHALL NOT REUSE OR MAKE OR PERMIT TO BE MADE ANY MODIFICATION TO THE DRAWINGS AND SPECIFICATIONS WITHOUT THE PRIOR WRITTEN AUTHORIZATION OF THE CONSULTANT (ARCHITECT). THE CLIENT AGREES TO WAIVE ANY CLAIM AGAINST THE CONSULTANT (ARCHITECT ARISING FROM ANY UNAUTHORIZED TRANSFER, REUSE OR MODIFICATION OF THE DRAWINGS AND SPECIFICATIONS.

5. ARCHITECT CANNOT WARRANT THE ACCURACY OF DATA CONTAINED HEREIN. ANY USE OR REUSE OF ORIGINAL OR ALTERED CADD DESIGN MATERIALS BY THE USER OR APPROVAL OF THE ARCHITECT SHALL BE AT THE SOLE RISK OF THE USER. FURTHERMORE, USER AGREES TO DEFEND, INDEMNIFY, AND HOLD ARCHITECT HARMLESS FROM ALL CLAIMS, INJURIES, DAMAGES, LOSSES, EXPENSES, AND ATTORNEY'S FEES ARISING OUT OF THE MODIFICATION OR REUSE OF THESE MATERIALS.

6. THESE DRAWINGS AS PART OF THE CONTRACT DOCUMENTS ARE DIAGRAMMATIC AND ARE NOT INTENDED TO DEFINE EXACT QUANTITIES, LOCATIONS OR CODIFIED REQUIREMENTS. THE DRAMINGS SHALL NOT BESCALED.EXACT STATE AND LOCAL CODE REQUIREMENTS AND OTHER APPLICABLE CODE REQUIREMENTS SHALL BE VERIFIED BY AND ARE THE SOLE RESPONSIBILITY OF THIS CONTRACTOR. CODES OR ANY DISCREPANCIES FOUND IN THE CONTRACT DOCUMENTS SHALL BE BROUGHT TO THE ATTENTION OF THE PROJECT ARCHITECT.

Bid Set

09/06/2017

14105

PROJECT DATE PROJECT #:

ADDENDUM 2 09/18/17

**BUILDING E FOUNDATION** PLAN

S101E

THE COLLABORATIVE

Phone (614)221-1110) Fax (614)221-0831 www.berardipartners.com

\* SEE AIOI SHEETS FOR DIMENSIONS

1/2" Φ X 18" ANCHOR BOLTS 48" O.C. W/ 2" HOOK - NO GREATER THAN 12" FROM INSIDE OR OUTSIDE CORNER

OPENINGS AND THEN SPACED 48" OC

ALL EXTERIOR CONCRETE JOINTS TO

SOIL BEARING PRESSURE IS 3000 PSI

SOILS ENGINEER TO INSPECT FOOTING EXCAVATIONS PRIOR TO PLACEMENT

OF CONCRETE AND REINFORCING

BEYOND. IF INBED ANCHOR BOLT

CONFLICTS W/ WD POST, INSTALL 8"


AND WITHIN 8" OF ALL DOOR

WEDGE ANCHOR.

BE TOOLED.

BARS.

architecture + interior design + engineering 1398 Goodale Blvd. Columbus, Ohio 43212

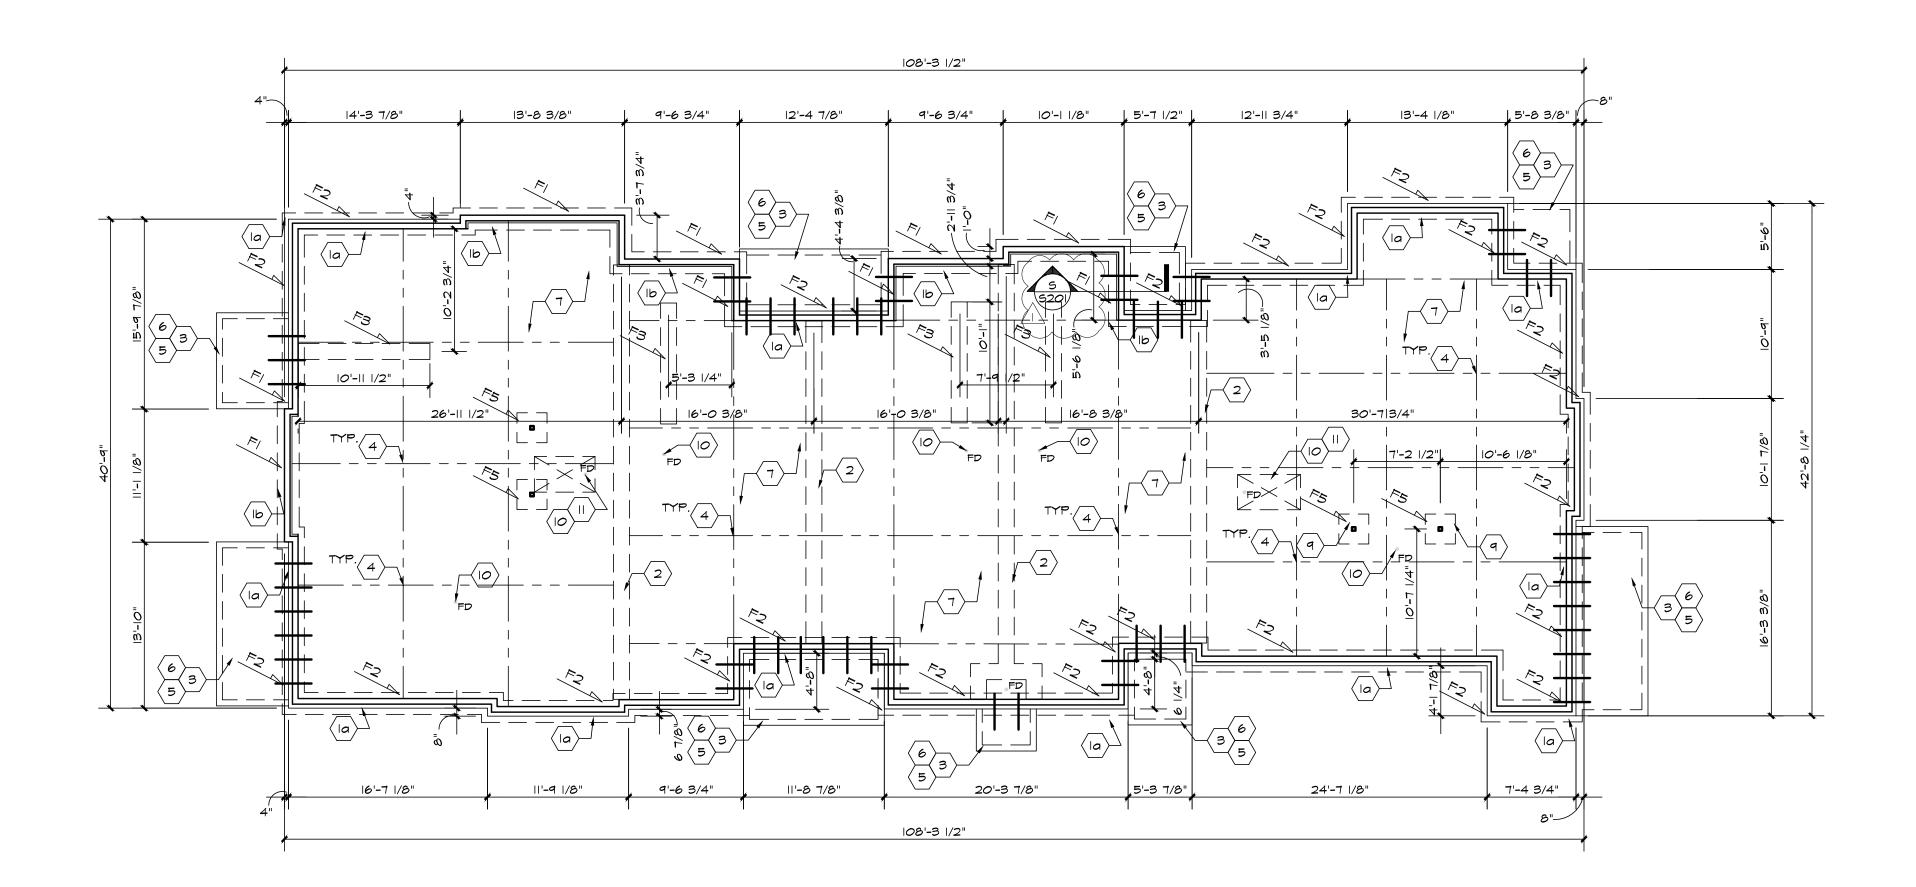



fo	footing schedule									
MARK	SIZE	REINFORCING	LOCATION	CODED NOTE						
FI	1'-8" W. X 10" D. MIN.	(2) #4'S CONT. BOTTOM	EXT. WALL FTG.	I						
F2	1'-10" W. X 10" D. MIN.	(2) #5'S CONT. BOTTOM	EXT. WALL FTG.	I						
F3	I'-6" W. X I2" D. THICKENED SLAB	(3) #5'S CONT. BOTTOM	INT. WALL FTG.	2						
F4	2'-6" SQ. × 12" D.	(3) #4'S EACH WAY	COLUMN FTG.	9						
F5	2'-6" SQ. × 12" D. THICKENED SLAB	(3) #5'S EACH WAY	INT. WALL FTG.							

CODED NOTES APPLY TO ENTIRE BUILDING.
INDIVIDUAL IDENTIFICATION IS FOR REFERENCE MATERIALS TO BE INSTALLED PER MANUFACTURERS MOST CURRENT WRITTEN INSTALLATION INSTRUCTIONS

foundation plan 1/8"=1'-0"

foo	footing schedule									
MARK	SIZE	REINFORCING	LOCATION	CODED NOTE						
FI	1'-8" W. X 10" D. MIN.	(2) #4'S CONT. BOTTOM	EXT. WALL FTG.	I						
F2	1'-10" W. X 10" D. MIN.	(2) #5'S CONT. BOTTOM	EXT. MALL FTG.	I						
F3	I'-6" W. X I2" D. THICKENED SLAB	(3) #5'S CONT. BOTTOM	INT. WALL FTG.	2						
F4	2'-6" SQ. × 12" D.	(3) #4'S EACH WAY	COLUMN FTG.	9						
F5	2'-6" SQ. × I2" D. THICKENED SLAB	(3) #5'S EACH WAY	INT. WALL FTG.							

# LMHA Collingwood Green, Phase III





THE ARRANGEMENTS DEPICTED HEREIN ARE THE SOLE PROPERTY OF BERARDI + PARTNERS, INC., ARCHITECTS AND ENGINEERS, AND MAY NOT BE REPRODUCED WITHOUT ITS WRITTEN PERMISSION

NOTE:

1. ALL BIDDERS SHALL VISIT THE SITE AND BECOME FAMILIAR W/
THE EXISTING CONDITIONS AND REQUIREMENTS OF THE PROJECT
AND SHALL NOTIFY THE ARCHITECT OF ANY ERRORS AND OMISSIONS
SUBSEQUENTLY DISCOVERED IN THE CONTRACT DOCUMENTS.

2. THE CONTRACT DOCUMENTS ARE COMPRISED OF THE DRAWINGS AND THE PROJECT MANUAL IN THEIR ENTIRETY. THE INFORMATION IN THESE DOCUMENTS IS DEPENDENT UPON AND COMPLEMENTARY OF EACH OTHER. SEPARATION OF THE CONTRACT DOCUMENTS SHALL NOT BE PERMITTED. IF THE CONTRACTOR CHOOSES TO SEPARATE THE DOCUMENTS, THEY DO SO AT THEIR OWN RISK AND EXPENSE.

3. ADDITIONALLY, SEE GENERAL INFORMATION ON "AO" SHEETS. 4. THE CLIENT ACKNOWLEDGES THE CONSULTANT'S (ARCHITECT) DRAWINGS AND SPECIFICATION, INCLUDING ALL DOCUMENTS ON ELECTRONIC MEDIA AS INSTRUMENTS OF THE CONSULTANTS (ARCHITECT) PROFESSIONAL SERVICE. THE CLIENT SHALL NOT REUSE OR MAKE OR PERMIT TO BE MADE ANY MODIFICATION TO THE DRAWINGS AND SPECIFICATIONS WITHOUT THE PRIOR WRITTEN AUTHORIZATION OF THE CONSULTANT (ARCHITECT). THE CLIENT AGREES TO WAIVE ANY CLAIM AGAINST THE CONSULTANT (ARCHITECT) ARISING FROM ANY UNAUTHORIZED TRANSFER, REUSE OR

5. ARCHITECT CANNOT WARRANT THE ACCURACY OF DATA CONTAINED HEREIN, ANY USE OR REUSE OF ORIGINAL OR ALTERED CADD DESIGN MATERIALS BY THE USER OR OTHER PARTIES WITHOUT THE REVIEW AND WRITTEN APPROVAL OF THE ARCHITECT SHALL BE AT THE SOLE RISK OF THE USER. FURTHERMORE, USER AGREES T DEFEND, INDEMNIFY, AND HOLD ARCHITECT HARMLESS FROM ALL CLAIMS, INJURIES, DAMAGES, LOSSES,

MODIFICATION OF THE DRAWINGS AND SPECIFICATIONS.

EXPENSES, AND ATTORNEY'S FEES ARISING OUT OF THE MODIFICATION OR REUSE OF THESE MATERIALS. 6. THESE DRAWINGS AS PART OF THE CONTRACT DOCUMENTS ARE DIAGRAMMATIC AND ARE NOT INTENDED TO DEFINE EXACT QUANTITIES, LOCATIONS OR CODIFIED REQUIREMENTS. THE DRAWINGS SHALL NOT BE SCALED, EXACT STATE AND LOCAL CODE REQUIREMENTS AND OTHER APPLICABLE CODE REQUIREMENTS SHALL BE VERIFIED BY AND ARE THE SOLE RESPONSIBILITY OF THIS CONTRACTOR. ANY INFORMATION WHICH DIRECTLY CONFLICTS WITH ANY OF THESE CODES OR ANY DISCREPANCIES FOUND IN THE CONTRACT DOCUMENTS SHALL BE BROUGHT TO THE ATTENTION OF THE PROJECT ARCHITECT.

## Bid Set

PROJECT DATE 09/06/2017 14105 PROJECT #:

ADDENDUM 2 09/18/17

**BUILDING F** FOUNDATION PLAN

S101F



## coded notes (x)

- POURED CONCRETE FOUNDATION STEM WALL ON POURED CONCRETE FOOTING SEE FOUNDATION SCHEDULE. (BOTTOM OF ALL PERIMETER AND BUILDING EXTERIOR FOUNDATION SYSTEMS TO BE 42" MINIMUM BELOW FINISH GRADE.)
  - a. 10" MASONRY STEM WALL PLUS BRICK VENEER DETAILS ON S201.
- b. 8" MASONRY STEM WALL PLUS STONE VENEER AND SIDING DETAILS ON 2. POURED CONCRETE THICKENED SLAB (SEE FOOTING SCHEDULE). SEE DETAIL J/S201 3. 4" THICK CONCRETE STOOP/SLAB W/ FIBROUS REINFORCING AND 42" DEEP TURNED DOWN EDGE ON GRAVEL - SEE DETAIL E/S201 & F/S201. (SEE SECTIONS FOR
- DEEPER SLAB EDGE ) TOOLED JOINTS AS INDICATED. HAND SWIRLED FINISH W/PICTURE FRAME JOINTS AND EDGES. 4. SAW CUT CONTROL JOINT. SEE DETAIL G/S201.
- 5. #4 BENT REBAR @ 16" O.C. AT EXTERIOR WALL ABUTMENT. FIRST AND LAST
- DOWEL LACED W/IN 12" OF WALL. SEE DET. B/S201 SIM. 6. #4 BENT REBAR @ 16" O.C. AT EXTERIOR DOOR LOCATION. FIRST AND LAST DOWEL PLACED W/IN 12" OF WALL. SEE DET. A/S201 SIM.
- 7. 4" CONC. SLAB W/ WITH FIBROUS REINFORCING ON 6 MIL. POLY VAPOR BARRIER ON 4" GRANULAR FILL, TYPICAL.
- 8. CONT. FTG. FOR SHEAR WALL. SEE SECTION E/A601 THICKEN FOOTING HOLD-DOWN TO 15" - 1'-0" PAST HOLD DOWN ALL DIRECTIONS.
- 9. INTERIOR CONCRETE FOOTING FOR WOOD COLUMN

ž ×

Q Q

a ×

₹ X

- 10. RECESSED FLOOR DRAINS 1/8" PER FT WITHIN AREA SERVED, TYP.
- COORDINATE WITH MP FOR EQUIPMENT LAYOUT. II. CONCRETE SLAB TO BE DEPRESSED AT FIRST FLOOR SHOWERS, SEE DETAIL
- P/S201. 12. STEPPED FOOTING LOCATION. REFER TO DETAIL A/SIOI.
- 13. KEYED CONSTRUCTION JOINT FOR THICKENED SLAB STEPPED 8" / FOUNDATION STEPPED EA. END - REFER TO ELEVATIONS AND RELATED DETAIL.
- 14. 12" DIA.  $\times$  42" DP. CONC. POST FOOTING / 1" ISOLATION JOINT BETWEEN POST FOOTING
- AND CONC. SLAB (U.N.O. TYPICAL OF ALL POST COLUMNS ALL BLDGS TYP.) 15. SEE DETAIL M/S201 FOR STEPPED CONDITION @ EXTERIOR SLAB

1/2" Φ X 18" ANCHOR BOLTS 48" O.C.

W/ 2" HOOK - NO GREATER THAN 12" FROM INSIDE OR OUTSIDE CORNER

OPENINGS AND THEN SPACED 48" OC

ALL EXTERIOR CONCRETE JOINTS TO

SOIL BEARING PRESSURE IS 3000 PSI

SOILS ENGINEER TO INSPECT FOOTING

EXCAVATIONS PRIOR TO PLACEMENT


OF CONCRETE AND REINFORCING

BEYOND. IF INBED ANCHOR BOLT CONFLICTS W/ WD POST, INSTALL 8"

AND WITHIN 8" OF ALL DOOR

WEDGE ANCHOR.

BE TOOLED.

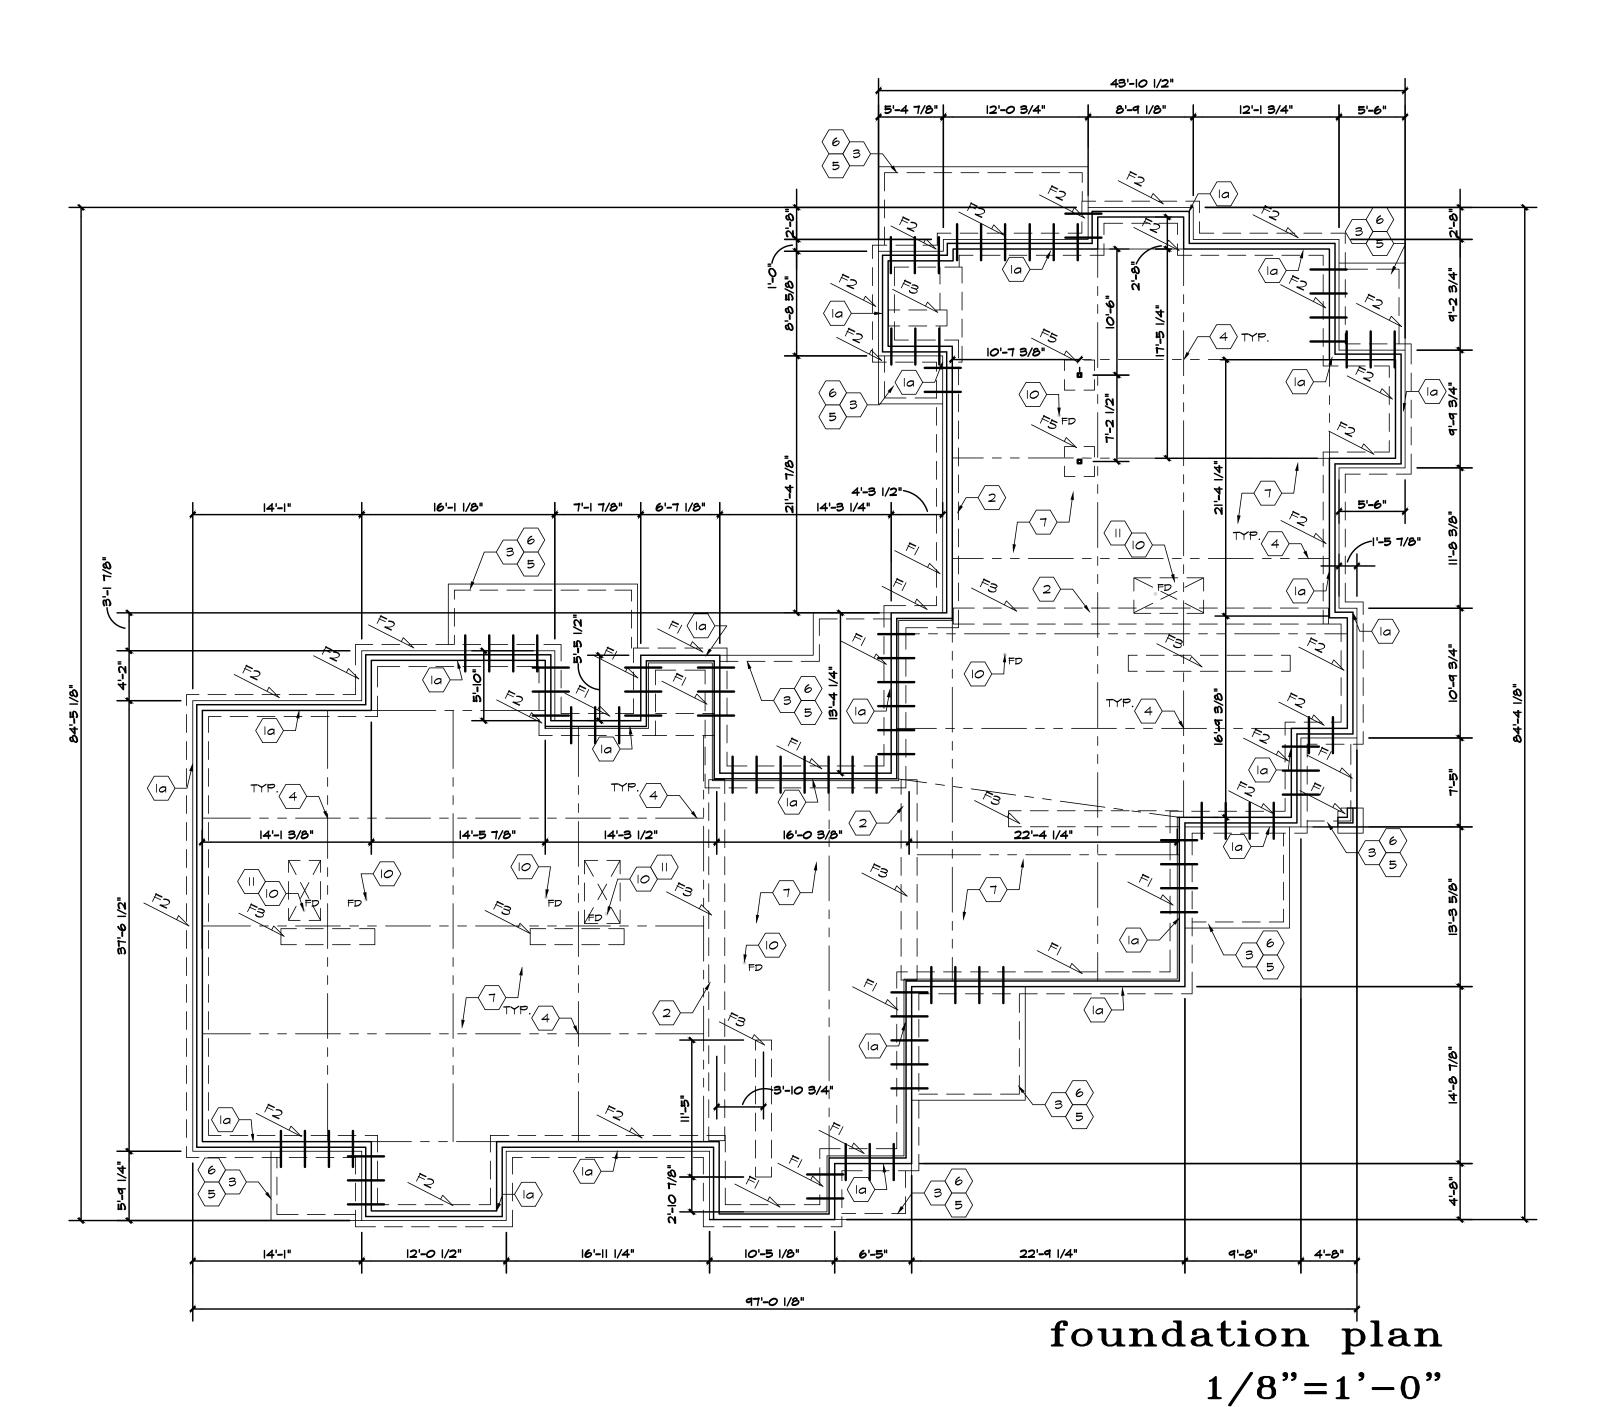

# coded notes (x)


- POURED CONCRETE FOUNDATION STEM WALL ON POURED CONCRETE FOOTING SEE FOUNDATION SCHEDULE. (BOTTOM OF ALL PERIMETER AND BUILDING EXTERIOR FOUNDATION SYSTEMS TO BE 42" MINIMUM BELOW FINISH GRADE.)
- a. 10" MASONRY STEM WALL PLUS BRICK VENEER DETAILS ON S201.
- b. 8" MASONRY STEM WALL PLUS STONE VENEER AND SIDING DETAILS ON
- 2. POURED CONCRETE THICKENED SLAB (SEE FOOTING SCHEDULE). SEE DETAIL S201 3. 4" THICK CONCRETE STOOP/SLAB W/ FIBROUS REINFORCING AND 42" DEEP TURNED DOWN EDGE ON GRAVEL - SEE DETAIL E/S201 & F/S201. (SEE SECTIONS FOR DEEPER SLAB EDGE ) TOOLED JOINTS AS INDICATED. HAND SMIRLED FINISH W/PICTURE FRAME JOINTS AND EDGES.
- 4. SAW CUT CONTROL JOINT. SEE DETAIL 6/5201. #4 BENT REBAR @ 16" O.C. AT EXTERIOR WALL ABUTMENT. FIRST AND LAST
- DOWEL PLACED W/IN 12" OF WALL. SEE DET. B/S201 SIM.
- 6. #4 BENT REBAR @ 16" O.C. AT EXTERIOR DOOR LOCATION. FIRST AND LAST DOWEL PLACED W/IN 12" OF WALL. SEE DET. A/S201 SIM.
- 7. 4" CONC. SLAB W/ WITH FIBROUS REINFORCING ON 6 MIL. POLY VAPOR BARRIER ON 4" GRANULAR FILL, TYPICAL.
- 8. CONT. FTG. FOR SHEAR WALL. SEE SECTION E/A601 THICKEN FOOTING HOLD-DOWN TO 15" - 1'-0" PAST HOLD DOWN ALL DIRECTIONS.
- 9. INTERIOR CONCRETE FOOTING FOR WOOD COLUMN 10. RECESSED FLOOR DRAINS 1/8" PER FT WITHIN AREA SERVED, TYP.

Q Q

a ×

ЧX

- COORDINATE WITH MP FOR EQUIPMENT LAYOUT.
- CONCRETE SLAB TO BE DEPRESSED AT FIRST FLOOR SHOWERS, SEE DETAIL
- 12. STEPPED FOOTING LOCATION. REFER TO DETAIL A/SIOI.
- 13. KEYED CONSTRUCTION JOINT FOR THICKENED SLAB STEPPED 8" / FOUNDATION STEPPED EA. END - REFER TO ELEVATIONS AND RELATED DETAIL.
- 14. 12" DIA. × 42" DP. CONC. POST FOOTING / I" ISOLATION JOINT BETWEEN POST FOOTING AND CONC. SLAB (U.N.O. TYPICAL OF ALL POST COLUMNS ALL BLDGS TYP.)
- 15. SEE DETAIL M/S201 FOR STEPPED CONDITION @ EXTERIOR SLAB

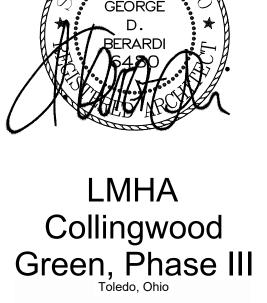



THE ARRANGEMENTS DEPICTED HEREIN ARE THE SOLE PROPERTY OF BERARDI + PARTNERS, INC., ARCHITECTS AND ENGINEERS, AND MAY NOT BEREPRODUCED WITHOUT ITS WRITTEN PERMISSION

1. ALL BIDDERS SHALL VISIT THE SITE AND BECOME FAMILIAR W/
THE EXISTING CONDITIONS AND REQUIREMENTS OF THE PROJECT
AND SHALL NOTIFY THE ARCHITECT OF ANY ERRORS AND OMISSIONS
SUBSEQUENTLY DISCOVERED IN THE CONTRACT DOCUMENTS.

 THE CONTRACT DOCUMENTS ARE COMPRISED OF THE DRAWINGS AND THE PROJECT MANUAL IN THEIR ENTIRETY. THE INFORMATION IN THESE DOCUMENTS IS DEPENDENT UPON AND COMPLEMENTARY OF EACH OTHER. SEPARATION OF THE CONTRACT DOCUMENTS SHALL NOT BE PERMITTED. IF THE CONTRACTOR CHOOSES TO SEPARATE THE DOCUMENTS, THEY DO SO AT THEIR OWN RISK AND EXPENSE

3. ADDITIONALLY, SEE GENERAL INFORMATION ON "AO" SHEETS. 4. THE CLIENT ACKNOWLEDGES THE CONSULTANT'S (ARCHITECT) DRAWINGS AND SPECIFICATION, INCLUDING ALL DOCUMENTS ON ELECTRONIC MEDIA AS INSTRUMENTS OF THE CONSULTANTS (ARCHITECT) PROFESSIONAL SERVICE. THE CLIENT SHALL NOT REUSE OR MAKE OR PERMIT TO BE MADE ANY MODIFICATION TO THE DRAWINGS AND SPECIFICATIONS WITHOUT THE PRIOR WRITTEN AUTHORIZATION OF THE CONSULTANT (ARCHITECT). THE CLIENT AGREES TO WAIVE ANY CLAIM AGAINST THE CONSULTANT (ARCHITECT ARISING FROM ANY UNAUTHORIZED TRANSFER, REUSE OR MODIFICATION OF THE DRAWINGS AND SPECIFICATIONS.

5. ARCHITECT CANNOT WARRANT THE ACCURACY OF DATA CONTAINED HEREIN. ANY USE OR REUSE OF ORIGINAL OR ALTERED CADD DESIGN MATERIALS BY THE USER OR APPROVAL OF THE ARCHITECT SHALL BE AT THE SOLE RISK OF THE USER. FURTHERMORE, USER AGREES TO DEFEND INDEMNIFY AND HOLD ARCHITECT HARMLESS FROM ALL CLAIMS, INJURIES, DAMAGES, LOSSES, EXPENSES, AND ATTORNEY'S FEES ARISING OUT OF THE MODIFICATION OR REUSE OF THESE MATERIALS.

6. THESE DRAWINGS AS PART OF THE CONTRACT DOCUMENTS ARE DIAGRAMMATIC AND ARE NOT INTENDED TO DEFINE EXACT QUANTITIES, LOCATIONS OR CODIFIED REQUIREMENTS. THE DRAWINGS SHALL NOT BESCALED. EXACT STATE AND LOCAL CODE REQUIREMENTS AND OTHER APPLICABLE CODE REQUIREMENTS SHALL BE VERIFIED BY AND ARE THE SOLE RESPONSIBILITY OF THIS CONTRACTOR. CODES OR ANY DISCREPANCIES FOUND IN THE CONTRACT DOCUMENTS SHALL BE BROUGHT TO THE ATTENTION OF THE PROJECT ARCHITECT.

Bid Set

PROJECT DATE 09/06/2017 PROJECT #:

Description ADDENDUM 2 09/18/17

14105

**BUILDING G FOUNDATION** 

PLAN

S101G



www.berardipartners.com

north

footing schedule										
MARK	SIZE	REINFORCING	LOCATION	CODED NOTE						
FI	1'-8" W. X 10" D. MIN.	(2) #4'S CONT. BOTTOM	EXT. WALL FTG.	1						
F2	1'-10" W. X 10" D. MIN.	(2) #5'S CONT. BOTTOM	EXT. WALL FTG.	I						
F3	I'-6" W. X I2" D. THICKENED SLAB	(3) #5'S CONT. BOTTOM	INT. WALL FTG.	2						
F4	2'-6" SQ. x 12" D.	(3) #4'S EACH WAY	COLUMN FTG.	9						

CODED NOTES APPLY TO ENTIRE BUILDING. INDIVIDUAL IDENTIFICATION IS FOR REFERENCE MATERIALS TO BE INSTALLED PER MANUFACTURERS MOST CURRENT WRITTEN INSTALLATION INSTRUCTIONS

1/2" Φ X 18" ANCHOR BOLTS 48" O.C. W/ 2" HOOK - NO GREATER THAN 12"

FROM INSIDE OR OUTSIDE CORNER

BEYOND. IF INBED ANCHOR BOLT

CONFLICTS W/ WD POST, INSTALL 8"

OPENINGS AND THEN SPACED 48" OC

ALL EXTERIOR CONCRETE JOINTS TO

SOIL BEARING PRESSURE IS 3000 PSI.

SOILS ENGINEER TO INSPECT FOOTING EXCAVATIONS PRIOR TO PLACEMENT


OF CONCRETE AND REINFORCING


AND WITHIN 8" OF ALL DOOR

WEDGE ANCHOR.

BE TOOLED.

BARS.

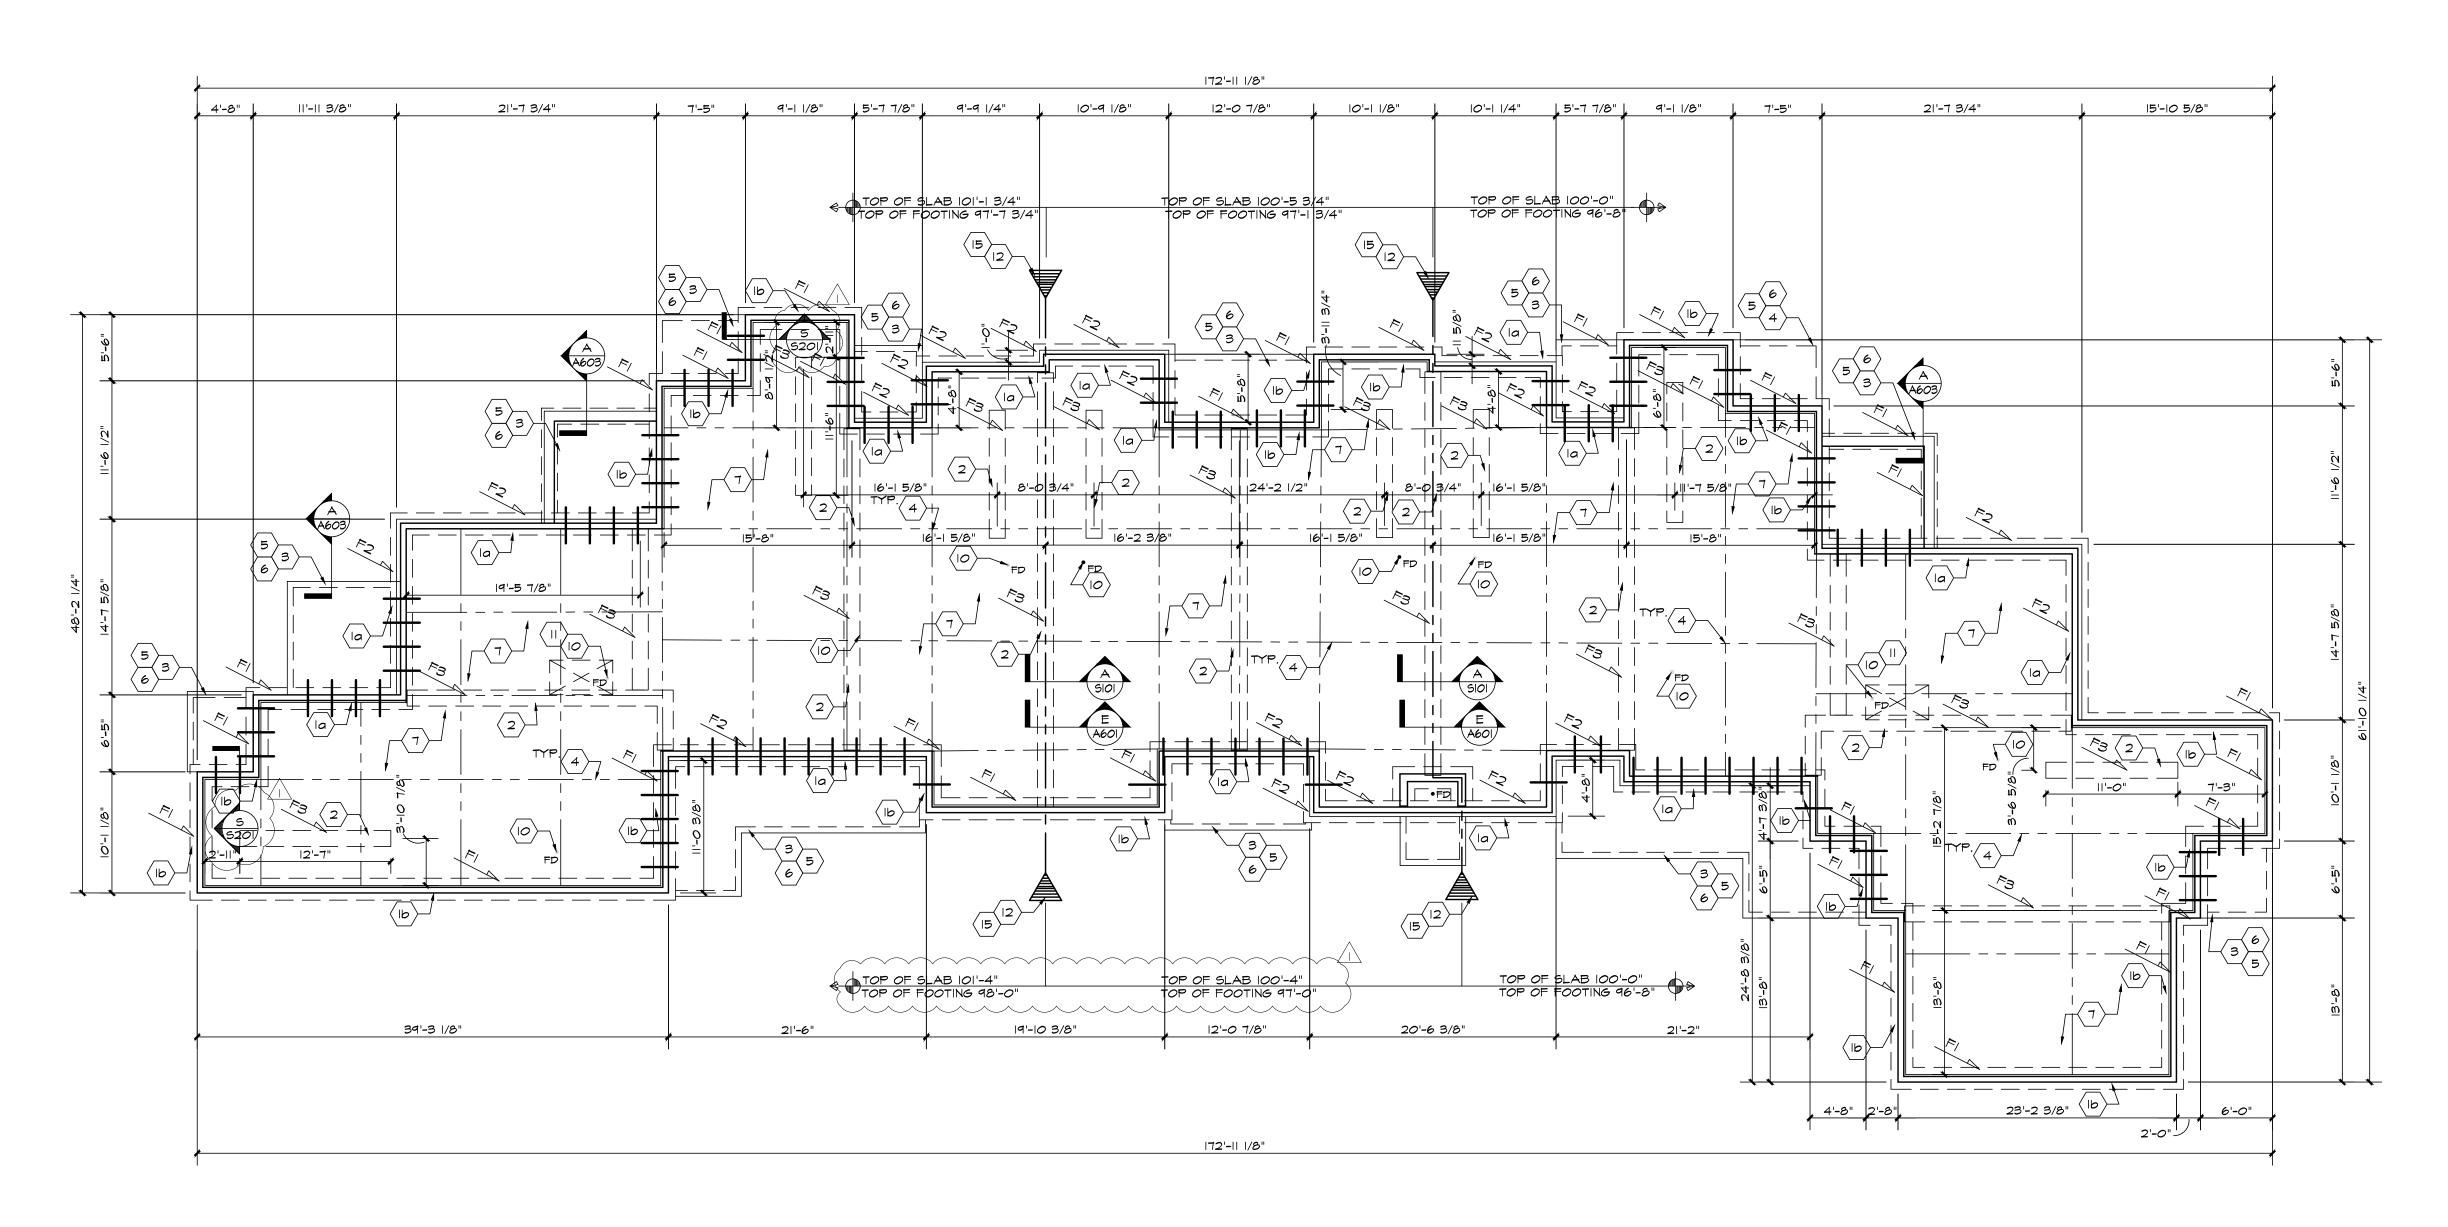

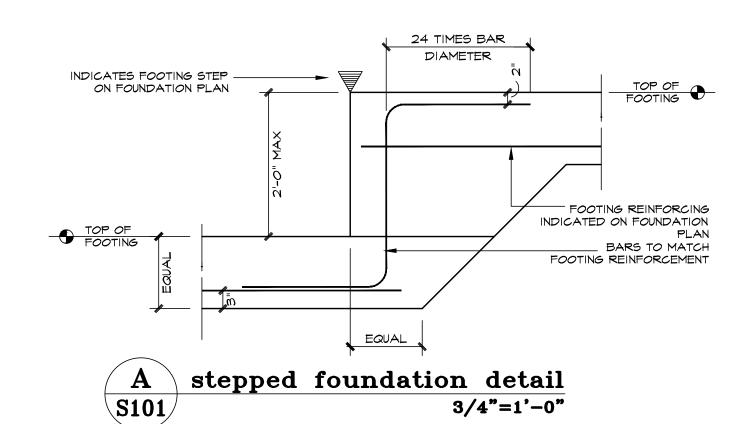

ž ×


B X

₹ X

## coded notes (x)

- POURED CONCRETE FOUNDATION STEM WALL ON POURED CONCRETE FOOTING SEE FOUNDATION SCHEDULE. (BOTTOM OF ALL PERIMETER AND BUILDING EXTERIOR FOUNDATION SYSTEMS TO BE 42" MINIMUM BELOW FINISH GRADE.)
  - a. 10" POURED CONCRETE STEM WALL PLUS BRICK VENEER DETAILS ON S201. 8" POURED CONCRETE STEM WALL - PLUS STONE VENEER AND SIDING
- DETAILS ON S201. 2. POURED CONCRETE THICKENED SLAB (SEE FOOTING SCHEDULE). SEE DETAIL S201 3. 4" THICK CONCRETE STOOP/SLAB W/ FIBROUS REINFORCING AND 42" DEEP TURNED DOWN EDGE ON GRAVEL - SEE DETAIL F/S201. (SEE SECTIONS FOR DEEPER SLAB EDGE ) TOOLED JOINTS AS INDICATED. HAND SWIRLED FINISH W/PICTURE FRAME
- JOINTS AND EDGES. 4. SAW CUT CONTROL JOINT. SEE DETAIL G/S201.
- 5. #4 x 36" REBAR DOMELS @ 24" O.C. AT EXTERIOR WALL ABUTMENT. FIRST AND LAST DOWEL PLACED W/IN 12" OF WALL. SEE DET. B/S201 SIM. 6. #4 x 36" REBAR DOMELS @ 24" O.C. AT EXTERIOR DOOR LOCATION. FIRST AND
- LAST DOWEL PLACED W/IN 12" OF WALL. SEE DET. A/S201 SIM. 7. 4" CONCRETE SLAB ON GRADE W/ WITH FIBROUS REINFORCING ON 6 MIL. POLY
- VAPOR BARRIER ON 4" GRANULAR FILL, TYPICAL. 8. CONT. FTG. FOR SHEAR WALL. SEE SECTION E/A601 - THICKEN FOOTING HOLD-DOWN
- TO 15" 1'-0" PAST HOLD DOWN ALL DIRECTIONS.
- 9. INTERIOR CONCRETE FOOTING FOR WOOD COLUMN
- 10. RECESSED FLOOR DRAINS 1/8" PER FT WITHIN AREA SERVED, TYP.
- COORDINATE WITH MP FOR EQUIPMENT LAYOUT.
- II. CONCRETE SLAB TO BE DEPRESSED AT FIRST FLOOR SHOWERS, SEE DETAIL P/SIOI.
- 12. STEPPED FOOTING LOCATION. REFER TO DETAIL A/SIOI. 13. KEYED CONSTRUCTION JOINT FOR THICKENED SLAB STEPPED 8" / FOUNDATION
- STEPPED EA. END REFER TO ELEVATIONS AND RELATED DETAIL. 14. 12" DIA.  $\times$  42" DP. CONC. POST FOOTING / 1" ISOLATION JOINT BETWEEN POST FOOTING
- AND CONC. SLAB (U.N.O. TYPICAL OF ALL POST COLUMNS ALL BLDGS TYP.) 15. SEE DETAIL M/S201 FOR STEPPED CONDITION @ EXTERIOR SLAB

# foundation plan 1/8"=1'-0"

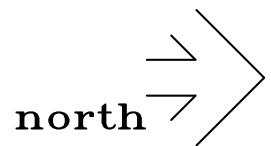

foo	footing schedule									
MARK	SIZE	REINFORCING	LOCATION	CODED NOTE						
FI	1'-8" W. X 10" D. MIN.	(2) #4'S CONT. BOTTOM	EXT. WALL FTG.	I						
F2	1'-10" W. X 10" D. MIN.	(2) #5'S CONT. BOTTOM	EXT. WALL FTG.	I						
F3	I'-6" W. X I2" D. THICKENED SLAB	(3) #5'S CONT. BOTTOM	INT. WALL FTG.	2						
F4	2'-6" SQ. × 12" D.	(3) #4'S EACH WAY	COLUMN FTG.	q						

CODED NOTES APPLY TO ENTIRE BUILDING. INDIVIDUAL IDENTIFICATION IS FOR REFERENCE MATERIALS TO BE INSTALLED PER MANUFACTURERS MOST CURRENT WRITTEN INSTALLATION INSTRUCTIONS



LMHA Collingwood Green, Phase III



THE ARRANGEMENTS DEPICTED HEREIN ARE THE SOLE PROPERTY OF BERARDI + PARTNERS, INC., ARCHITECTS AND ENGINEERS, AND MAY NOT BE REPRODUCED WITHOUT ITS WRITTEN PERMISSION

NOTE:

1. ALL BIDDERS SHALL VISIT THE SITE AND BECOME FAMILIAR W/
THE EXISTING CONDITIONS AND REQUIREMENTS OF THE PROJECT
AND SHALL NOTIFY THE ARCHITECT OF ANY ERRORS AND OMISSIONS
SUBSEQUENTLY DISCOVERED IN THE CONTRACT DOCUMENTS.

2. THE CONTRACT DOCUMENTS ARE COMPRISED OF THE DRAWINGS AND THE PROJECT MANUAL IN THEIR ENTIRETY. THE INFORMATION IN THESE DOCUMENTS IS DEPENDENT UPON AND COMPLEMENTARY OF EACH OTHER. SEPARATION OF THE CONTRACT DOCUMENTS SHALL NOT BE PERMITTED. IF THE CONTRACTOR CHOOSES TO SEPARATE THE DOCUMENTS, THEY DO SO AT THEIR OWN RISK AND EXPENSE.

3. ADDITIONALLY, SEE GENERAL INFORMATION ON "AO" SHEETS 4. THE CLIENT ACKNOWLEDGES THE CONSULTANT'S (ARCHITECT) DRAWINGS AND SPECIFICATION, INCLUDING ALL DOCUMENTS ON ELECTRONIC MEDIA AS INSTRUMENTS OF THE CONSULTANTS (ARCHITECT) PROFESSIONAL SERVICE. THE CLIENT SHALL NOT REUSE OR MAKE OR PERMIT TO BE MADE ANY MODIFICATION TO THE DRAWINGS AND SPECIFICATIONS WITHOUT THE PRIOR WRITTEN AUTHORIZATION OF THE CONSULTANT (ARCHITECT). THE CLIENT AGREES TO WAIVE ANY CLAIM AGAINST THE CONSULTANT (ARCHITECT) ARISING FROM ANY UNAUTHORIZED TRANSFER, REUSE OR

5. ARCHITECT CANNOT WARRANT THE ACCURACY OF DATA CONTAINED HEREIN, ANY USE OR REUSE OF ORIGINAL OR ALTERED CADD DESIGN MATERIALS BY THE USER OR OTHER PARTIES WITHOUT THE REVIEW AND WRITTEN APPROVAL OF THE ARCHITECT SHALL BE AT THE SOLE RISK OF THE USER. FURTHERMORE, USER AGREES T DEFEND, INDEMNIFY, AND HOLD ARCHITECT HARMLESS FROM ALL CLAIMS, INJURIES, DAMAGES, LOSSES, EXPENSES, AND ATTORNEYS FEES ARISING OUT OF THE MODIFICATION OR REUSE OF THESE MATERIALS.

MODIFICATION OF THE DRAWINGS AND SPECIFICATIONS.

6. THESE DRAWINGS AS PART OF THE CONTRACT DOCUMENTS ARE DIAGRAMMATIC AND ARE NOT INTENDED TO DEFINE EXACT QUANTITIES, LOCATIONS OR CODIFIED REQUIREMENTS. THE DRAWINGS SHALL NOT BE SCALED, EXACT STATE AND LOCAL CODE REQUIREMENTS AND OTHER APPLICABLE CODE REQUIREMENTS SHALL BE VERIFIED BY AND ARE THE SOLE RESPONSIBILITY OF THIS CONTRACTOR. ANY INFORMATION WHICH DIRECTLY CONFLICTS WITH ANY OF THESE CODES OR ANY DISCREPANCIES FOUND IN THE CONTRACT DOCUMENTS SHALL BE BROUGHT TO THE ATTENTION OF THE PROJECT ARCHITECT.

Bid Set

PROJECT DATE 09/06/2017 14105 PROJECT #:

ADDENDUM 2 09/18/17

**BUILDING H** FOUNDATION PLAN

S101H



1/2" Φ X 18" ANCHOR BOLTS 48" O.C. W/ 2" HOOK - NO GREATER THAN 12" FROM INSIDE OR OUTSIDE CORNER

OPENINGS AND THEN SPACED 48" OC

ALL EXTERIOR CONCRETE JOINTS TO

SOIL BEARING PRESSURE IS 3000 PSI SOILS ENGINEER TO INSPECT FOOTING

EXCAVATIONS PRIOR TO PLACEMENT

OF CONCRETE AND REINFORCING


BEYOND. IF INBED ANCHOR BOLT

CONFLICTS W/ WD POST, INSTALL 8"

AND WITHIN 8" OF ALL DOOR

WEDGE ANCHOR.

BE TOOLED.

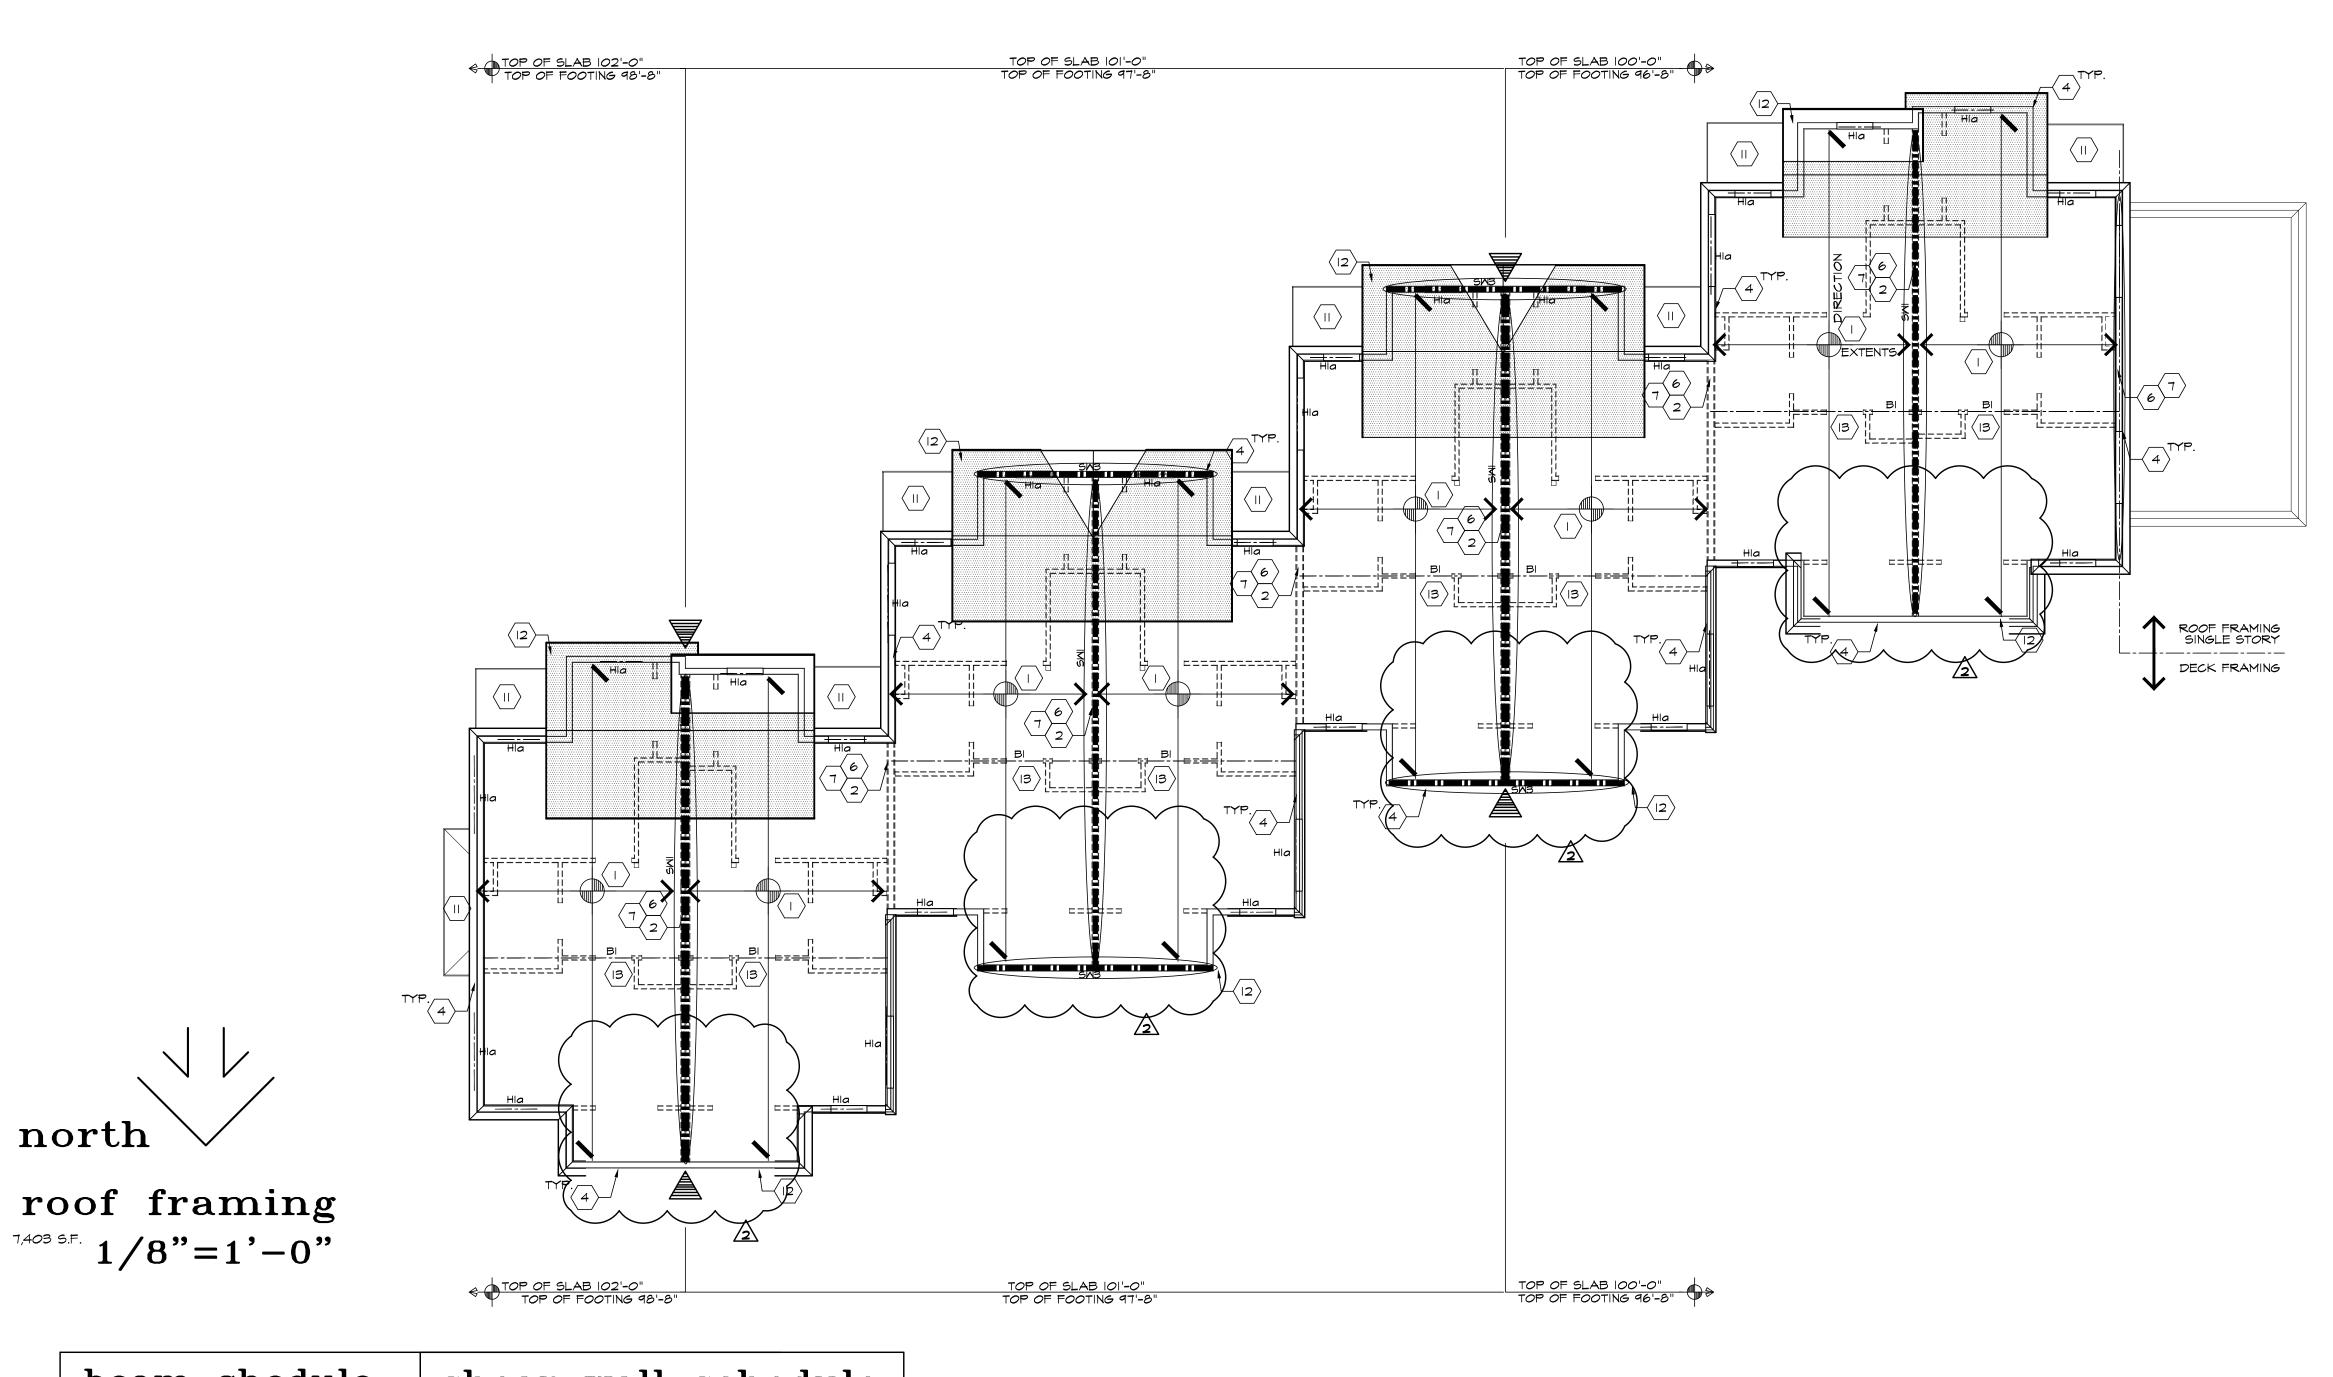

SHOP DRAWINGS, FABRICATION AND INSTALLATION TO ENSURE THE PROPOSED LAYOUT PROVIDES NECESSARY CLEARANCES FOR THE HVAC, PLBG

CONTRACTOR TO COORDINATE ADDITIONAL LOADING FOR BUILDING EQUIPMENT SYSTEMS TO FLOOR JOISTS - ROOF TRUSSES WITH MANUFACTURERS.

EXACT FRAMING LAYOUT SHALL BE COORDINATED WITH ALL OTHER TRADE SUBCONTRACTORS PRIOR TO INSTALLATION FOR ITEMS INCLUDING, BUT NOT LIMITED TO, THE ELECTRIC PANEL, ELECTRIC FIXTURES (INCLUDING CAN LIGHTS), MEDICINE CABINETS, CONTROL JOINTS, DOOR FRAMING AND

IF THE LAYOUT IS CHANGED SUCH THAT THE LOADING ON HEADERS/BEAMS IS INCREASED, THE FRAMING SUBCONTRACTOR SHALL SUBMIT A REVISED

SCHEDULE OF THOSE HEADERS/BEAMS STAMPED BY AN ENGINEER REGISTERED WITH THE STATE IN WHICH THE PROJECT IS TO BE LOCATED.

DO NOT CENTER TRUSSES ON CEILING RECESSES OR WITHIN 6" OF CENTERLINE OF DWELLING UNIT BEDROOM WINDOWS.

EXTEND ALL POSTS AND COLUMNS TO FOUNDATION. PROVIDE SOLID BLOCKING WITHIN FLOOR FRAMING SPACES.

AND ELECTRICAL TRADE ELEMENTS, FIXTURES, DUCTING AND PIPING.

HVAC DUCTS / SOFFITS.

	] beam shedu	ıle	shear	wall s	chedule									
$\bigcirc$ ${f coded}$ ${f notes}$ see deck framing on sid2	KING ST	TUDS EA END M	ARK END STUDS	WALL CONSTRU SIMPSON HOLDOWN	UCTION SHEATHING	SOLE IP ATTACHMENT	EDGE NAILING							
I. PRE-ENGINEERED WOOD ROOF TRUSSES @ 24" O.C. MAX. TYPICAL U.N.O. REFER TO TRUSS ENGINIEER'S LAYOUT FOR SPECIFIC TRUSS	BI (3)   3/4" x  4" LVL 3 B2 (2) 2 x  2 W/  /2" FILLER 2		(2) 2X'5	NONE	5/8" GYPSUM SHEATHING (E.S.)	16d NAILS @ 16" O.C.		6d 7" O.C.	hea	der	schedu	le		NOTES:
PROFILES AND SPACING.  PROVIDE 8d NAILS @ 8" O.C. FULL HEIGHT FOR MULTIPLE STUDS	B3 (2) 2 × IO 2 B4 (2)   3/4" × 9  /4" LVL 2		(2) 2X'5	NONE	5/8" GYPSUM SHEATHING (E.S.)	1/2"¢ @ 16" O.C.	6d 7" O.C.	6d 7" O.C.	MARK SIZE		JACK STUDS EA. END		IDS EA END	CODED NOTES APPLY TO THE ENTIRE BUILDING. INDIVIDUAL IDENTIFICATION IS FOR REFERENCE ONLY.
PROVIDE COMPRESSION/TENSION METAL "T" BRACING AT ALL INTERIOR TENANT COMMON WALLS NOT DESIGNATED AS SHEAR WALLS. PROVIDE & INSTALL ONE BRACE EACH SIDE OF WALL TO	B5 (2)   3/4" x    1/4" LVL 2 B6 (4)   3/4" x 9  /4" LVL 3		(2) 2X'5	NONE	7/16" OSB SHEATHING (O.S.) 5/8" GYPSUM SHEATHING (I.S.)	16d NAILS @ 6" O.C.	6d 7" O.C.	8d   12" O.C.   6d   7" O.C.		W/W I/2" FILLER	ı	ROOF FRAMING	2ND FRAMING 2	MULTIPLE MICROLAMS SECURED TOGETHER IN ACCORDANCE W/ MANUFACTURERS INSTRUCTIONS
MAKE & "X" AT EACH LOCATION. BUILDING EXTERIOR TO RECEIVE A FULL SHEETS OF 7/16" O.S.B.	B7 (2) 2 × 8 2		(2) 2X'5	NONE	7/16" OSB SHEATHING (O.S.) 5/8" GYPSUM SHEATHING (I.S.)	1/2"Ф @ 16" O.C.	6d 7" O.C.			W/ W I/2" FILLER W/ I/2" FILLER	2	2	3	ALL GIRDER TRUSSES SHALL HAVE MINIMUM 2x6 TOP \$
SHEATHING. SECTION OF RAISED BOTTOM CHORD / REFER TO REFLECTED CEILING PLAN, BUILDING SECTIONS AND DETAILS.	B8       (2) 2 × IO PT       2         B9       (2) 2 × IO PT       2		(2) 2X'5	DTT2Z	7/16" OSB SHEATHING (O.S.) 5/8" GYPSUM SHEATHING (I.S.)	/2"Φ @  6" O.C.	6d 7" O.C.	8d   12" O.C.   6d   7" O.C.	H4 (2) 2×13	W/ I/2" FILLER	2	2	4	BOTTOM CHORDS TO FACILITATE FRAMING CONNECTIONS BETWEEN ADJOINING MEMBERS. PROVIDE GREATER AS NEEDED. COORDINATE W/
RATED BEARING WALLS EXTENDING TIGHT TO ROOF SHEATHING UN-INTERUPTED, SEE WALL SECTIONS PROVIDE \$ INSTALL 1/2"	BIO (2) 2 × 8 W/ I/2" FILLER 2 BII (2) I 3/4 × I6" LVL 3		(2) 2X'5	HDU2-SDS2.5	7/16" OSB SHEATHING (O.S.) 5/8" GYPSUM SHEATHING (I.S.)	/2"Φ @  6" O.C.	6d 7" O.C.		H6 (2)   3/	× 9 1/4" LVL	2	2	3	SUPPORTED MEMBER HANGER REQUIREMENTS
SMB OR 3/8" MIN. OSB DRAFTSTOPPING SHEAR WALL, SEE DETAILS E/A601 \$ H/S202	BI2 (2)   3/4 x  4" LVL 3		(2) 2X'5	C522	7/16" OSB SHEATHING (O.S.) 5/8" GYPSUM SHEATHING (I.S.)	16d NAILS @ 8" O.C.		8d 12" O.C. 6d 7" O.C.		· ×     /4" LVL  / CONT. 3/8" ×	2 1/2" PL	-	-	THE ROOF TRUSS AND FRAMING LAYOUT DEPICTED HERE IS CONCEPTUAL ONLY TO DEFINE THE DESIGN INTENT.
ONE HOUR ATTIC ACCESS PANEL 'BABCOCK-DAVIS' MODEL # B-IM 12x36	I. HOLDOWNS SHOWN ON 2ND FLOOR DECK FRA HARDWARE AT FIRST FLOOR FRAMING BASE	PLATE LEVEL.	(2) 2X'5	HDU4-SDS2.5	7/16" OSB SHEATHING (O.S.) 5/8" GYPSUM SHEATHING (I.S.)	1/2"¢ @ 16" O.C.	8d 6" O.C. 6d 7" O.C.			W/ (2)  /2" F LLEf W/ (2)  /2" F LLEf		- I	I	EXACT ROOF TRUSS LAYOUT AND FRAMING DESIGN SHALL BE THE RESPONSIBILITY OF THE TRUSS SUPPLIER; WHO SHALL SUBMIT ENGINEERED AND SEALED TRUSS SHOP
DO NOT OPEN ROOF SHEATHING 2'-O" EITHER SIDE OF FIREWALLS/SMOKE WALLS.	2. HOLDOWNS BRIDGING FRAMING ON ONE LEVE ON ANOTHER TO BE COORDINATED WITH DET. \$202.		(2) 2X'5	CSI8	7/16" OSB SHEATHING (O.S.) 5/8" GYPSUM SHEATHING (I.S.)	16d NAILS @ 8" O.C.	8d 6" O.C. 6d 7" O.C.	8d 12" O.C. 6d 7" O.C.	H3a (3) 2×10	W/ (2) I/2" FILLE W/ (2) I/2" FILLE	R 2	-	I	DRAWINGS FOR APPROVAL TO THE ARCHITECT. SHOULD ROOF FRAMING BEARING LOCATIONS CHANGE FROM THAT
CLEARSPAN 2-PLY GIRDER TRUSS 2x6 RAFTERS @ 24" O.C TYPICAL @ ENTRY PORCH ROOFS.	holdown sche	dule	(2) 2X'5	HDU8-SDS2.5	7/16" OSB SHEATHING (O.S.) 5/8" GYPSUM SHEATHING (I.S.)	· 1/2"¢ @ 12" O.C.	8d 6" O.C. 6d 7" O.C.	8d 12" O.C. 6d 7" O.C.	n+a (5/ 2x12	7 V (2/ 1/2 1 1LLL	2	_	ı	DEPICTED, NOTIFY THE ARCHITECT IMMEDIATELY SO THAT ANY NECESSARY COORDINATION CAN BE IMPLEMENTED.
EXTEND PLYWOOD SHEATHING OVER TOP CHORDS OF TRUSSES.  OVERLAY TRUSSES @ 24" O.C. BY TRUSS SUPPLIER  BEARING WALL SUPPORTED BY BEAM IN 2ND FLOOR DECK SYSTEM  BELOW		END POST	ADDITIONAL ST 2. SHEAR WALL SH	ST BE CUT DUE TO THE PLACEM JD SHALL BE INSERTED ALONG HEATHING SHALL BE A.P.A. RATE SHALL BE SOLID BLOCKED WITH	D SHEATHING, EXPOSURE I.	CTS, AN		O.S.) OUTSIDE (I.S.) INSIDE S.) EACH SIDE	EXACT FLOOTRUSS/JOIST	LAYOUT SHAL	LAYOUT AND DIMENS LBE COORDINATED M	SIONS ARE 1 NITH THE HV/	THE RESPONS AC, PLUMBING	LANS  SIBILITY OF THE TRUSS FABRICATOR AND FRAMING SUBCONTRA  S AND ELECTRICAL SUBCONTRACTORS PRIOR TO SUBMISSION OF

6. SOLE PLATE ATTACHMENT BASED ON 1/2" ♥ TITEN HD ANCHORS W/ 4 1/2" MINIMUM EMBEDMENT.

5. #6 SCREWS  $\times$  I 3/4" LG. TYPE S MAY BE SUBSTITUTED FOR 6d NAILS.

4. WALLS REFERRED TO SHALL BE FULL LENGTH COMMON WALLS.

north

HDI

(I) MST 27

(2) 2x

HD2

CODED NOTES APPLY TO THE ENTIRE STRUCTURE. INDIVIDUALLY

IDENTIFIED LOCATIONS ARE FOR REFERENCE ONLY.

CD ₩

a ×

ЧX

D.
BERARDI
6400

LMHA Collingwood Green, Phase III

Collingwood Freen
"Quality affordable living within a green community."



THE ARRANGEMENTS DEPICTED HEREIN ARE THE SOLE PROPERTY OF BERARDI + PARTNERS, INC., ARCHITECTS AND ENGINEERS, AND MAY NOT BEREPRODUCED WITHOUT ITS WRITTEN PERMISSION

1. ALL BIDDERS SHALL VISIT THE SITE AND BECOME FAMILIAR W/
THE EXISTING CONDITIONS AND REQUIREMENTS OF THE PROJECT
AND SHALL NOTIFY THE ARCHITECT OF ANY ERRORS AND OMISSIONS
SUBSEQUENTLY DISCOVERED IN THE CONTRACT DOCUMENTS.

2. THE CONTRACT DOCUMENTS ARE COMPRISED OF THE DRAWINGS AND THE PROJECT MANUAL IN THEIR ENTIRETY. THE INFORMATION IN THESE DOCUMENTS IS DEPENDENT UPON AND COMPLEMENTARY OF EACH OTHER. SEPARATION OF THE CONTRACT DOCUMENTS SHALL NOT BE PERMITTED. IF THE CONTRACTOR CHOOSES TO SEPARATE THE DOCUMENTS, THEY DO SO AT THEIR OWN RISK AND EXPENSE.

3. ADDITIONALLY, SEE GENERAL INFORMATION ON "AO" SHEETS. 4. THE CLIENT ACKNOWLEDGES THE CONSULTANT'S (ARCHITECT) DRAWINGS AND SPECIFICATION, INCLUDING ALL DOCUMENTS ON ELECTRONIC MEDIA AS INSTRUMENTS OF THE CONSULTANTS (ARCHITECT) PROFESSIONAL SERVICE. THE CLIENT SHALL NOT REUSE OR MAKE OR PERMIT TO BE MADE ANY MODIFICATION TO THE DRAWINGS AND SPECIFICATIONS WITHOUT THE PRIOR WRITTEN AUTHORIZATION OF THE CONSULTANT (ARCHITECT). THE CLIENT AGREES TO WAIVE ANY CLAIM AGAINST THE CONSULTANT (ARCHITECT ARISING FROM ANY UNAUTHORIZED TRANSFER, REUSE OR

5. ARCHITECT CANNOT WARRANT THE ACCURACY OF DATA CONTAINED HEREIN. ANY USE OR REUSE OF ORIGINAL OR ALTERED CADD DESIGN MATERIALS BY THE USER OR APPROVAL OF THE ARCHITECT SHALL BE AT THE SOLE RISK OF THE USER. FURTHERMORE, USER AGREES TO DEFEND INDEMNIFY AND HOLD ARCHITECT HARMLESS FROM ALL CLAIMS, INJURIES, DAMAGES, LOSSES, EXPENSES, AND ATTORNEY'S FEES ARISING OUT OF THE MODIFICATION OR REUSE OF THESE MATERIALS.

MODIFICATION OF THE DRAWINGS AND SPECIFICATIONS.

6. THESE DRAWINGS AS PART OF THE CONTRACT DOCUMENTS ARE DIAGRAMMATIC AND ARE NOT INTENDED TO DEFINE EXACT QUANTITIES, LOCATIONS OR CODIFIED REQUIREMENTS. THE DRAWINGS SHALL NOT BESCALED, EXACT STATE AND LOCAL CODE REQUIREMENTS AND OTHER APPLICABLE CODE REQUIREMENTS SHALL BE VERIFIED BY AND ARE THE SOLE RESPONSIBILITY OF THIS CONTRACTOR. CODES OR ANY DISCREPANCIES FOUND IN THE CONTRACT DOCUMENTS SHALL BE BROUGHT TO THE ATTENTION OF THE PROJECT ARCHITECT.

Bid Set

PROJECT DATE 09/06/2017 PROJECT #:


ADDENDUM 2 09/18/17


14105

**BUILDING B** ROOF FRAMING

S103B



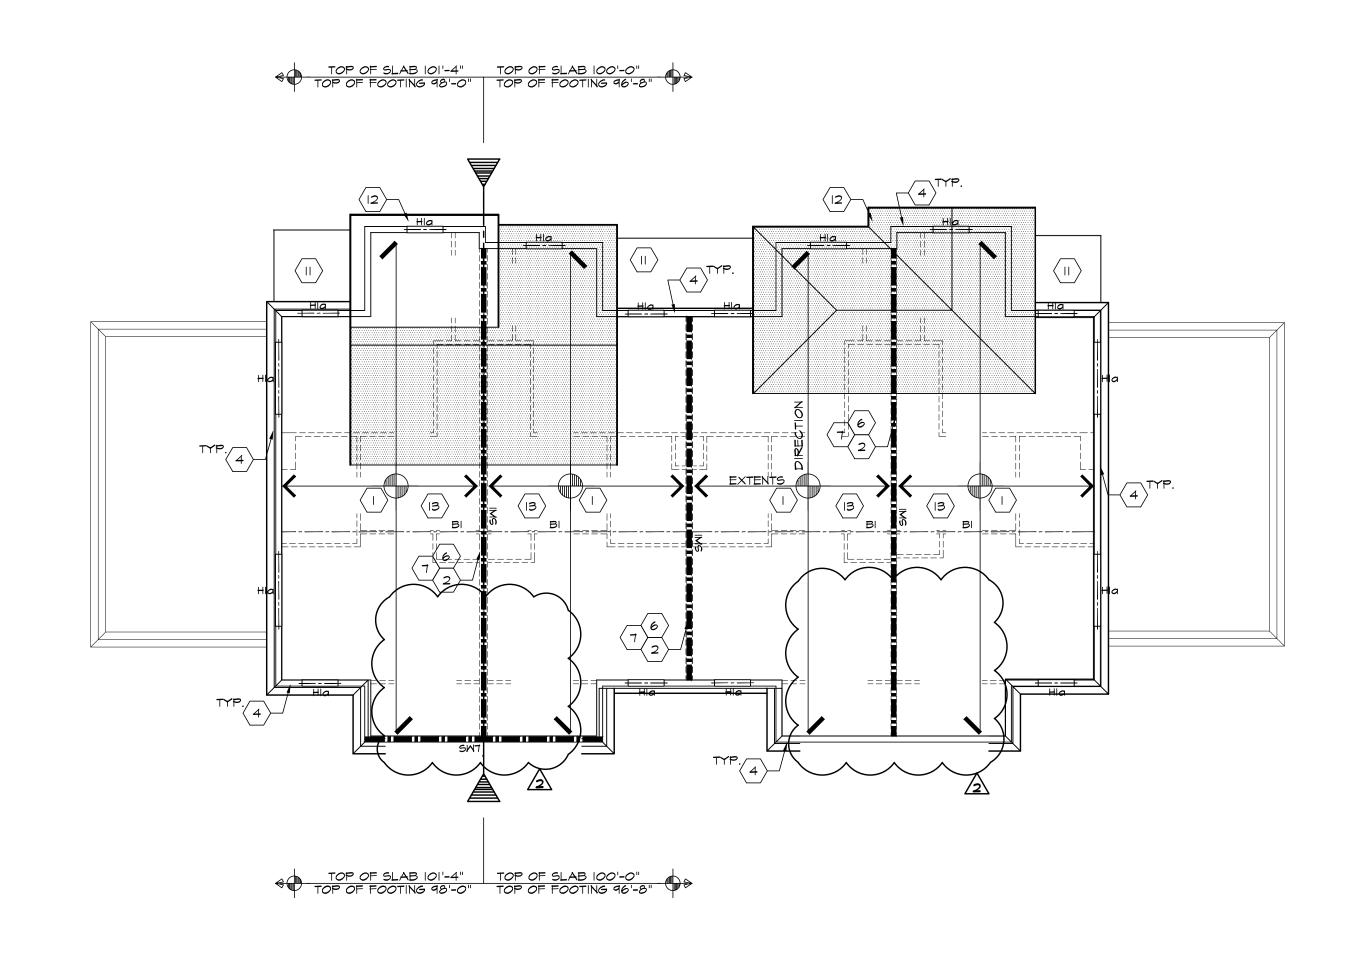

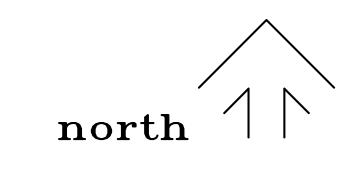

HOLDOWN MARK

HDI

ANCHOR TYPE

(I) MST 27

END POST

(2) 2x

roof framing 1/8"=1'-0"

					1
	,	Γ			
		b	eam she	edule	(2
	$\bigcirc$ $\mathbf{coded}$ $\mathbf{notes}$ see deck framing on sio2			KING STUDS EA END	(3
	PRE-ENGINEERED WOOD ROOF TRUSSES @ 24" O.C. MAX. TYPICAL	ВІ	(3)   3/4" ×  4" LVL	3	(4
	U.N.O. REFER TO TRUSS ENGINIEER'S LAYOUT FOR SPECIFIC TRUSS	B2	(2) 2 × 12 W/ 1/2" FILLER	2	
,	PROFILES AND SPACING. PROVIDE 8d NAILS @ 8" O.C. FULL HEIGHT FOR MULTIPLE STUDS	B3	(2) 2 × 10	2	
·· }.	PROVIDE COMPRESSION/TENSION METAL "T" BRACING AT INTERIOR	B4	(2)   3/4" × 9  /4" LVL	2	
	TENANT COMMON WALLS NOT DESIGNATED AS SHEAR WALLS.	B5	(2)   3/4" ×     /4" LVL	2	(6
	PROVIDE & INSTALL ONE BRACE EACH SIDE OF WALL TO MAKE & "X" AT EACH LOCATION.	В6	(4)   3/4" x 9  /4" LVL	Э	G
	BUILDING EXTERIOR TO RECEIVE A FULL SHEETS OF 7/16" O.S.B.	B7	(2) 2 × 8	2	
	SHEATHING.	B8	(2) 2 × 10 PT	2	(2
۰.	SECTION OF RAISED BOTTOM CHORD / REFER TO REFLECTED CEILING PLAN, BUILDING SECTIONS AND DETAILS.	B9	(2) 2 × 10 PT	2	
	RATED BEARING WALLS EXTENDING TIGHT TO ROOF SHEATHING	BIO	(2) 2 x 8 W/ I/2" FILLER	2	
	UN-INTERUPTED, SEE WALL SECTIONS PROVIDE \$ INSTALL 1/2"  GWB OR 3/8" MIN. OSB DRAFTSTOPPING	BII	(2)   3/4 ×  6" LVL	3	([c
	SHEAR WALL, SEE DETAILS E/A601 \$ H/S202	Bl2	(2)   3/4 ×  4" LVL	3	
•			DOWNS SHOWN ON 2ND FLOOR		NOT
•	ONE HOUR ATTIC ACCESS PANEL 'BABCOCK-DAVIS' MODEL # B-IW 22x36	l	DWARE AT FIRST FLOOR FRAM		
•	DO NOT OPEN ROOF SHEATHING 2'-O" EITHER SIDE OF FIREWALLS/SMOKE WALLS.		DOWNS BRIDGING FRAMING ON NOTHER TO BE COORDINATED 2.		
2.	CLEARSPAN 2-PLY GIRDER TRUSS	1_	-1.1	- l J l -	
	2x6 RAFTERS @ 24" O.C TYPICAL @ ENTRY PORCH ROOFS.	n	oldown s	cneaule	$\vdash$

12. EXTEND PLYWOOD SHEATHING OVER TOP CHORDS OF TRUSSES.

3. BEARING WALL SUPPORTED BY BEAM IN 2ND FLOOR DECK SYSTEM

CODED NOTES APPLY TO THE ENTIRE STRUCTURE. INDIVIDUALLY

OVERLAY TRUSSES @ 24" O.C. BY TRUSS SUPPLIER

IDENTIFIED LOCATIONS ARE FOR REFERENCE ONLY.

MARK		MALL CONSTRUC	EDG	E NAILING	FIELD	NAILING		
MAKK	END STUDS	SIMPSON HOLDOWN	SHEATHING	SOLE IZ ATTACHMENT	SIZE	SPACING	SIZE	SPACING
	(2) 2X'S	NONE	5/8" GYPSUM SHEATHING (E.S.)	16d NAILS @ 16" O.C.	6d	7" O.C.	6d	7" O.C.
2	(2) 2X'5	NONE	5/8" GYPSUM SHEATHING (E.S.)	1/2"Φ @ 16" O.C.	6d	7" O.C.	6d	7" O.C.
(3)	(2) 2X'S	NONE	7/16" OSB SHEATHING (O.S.)	16d NAILS @ 6" O.C.	8d	6" O.C.	8d	12" O.C.
9		5/8" GYPSUM SHEATHING (I.S.)	6d	7" O.C.	6d	7" 0.0.		
(4)	(2) 2X'S	NONE	7/16" OSB SHEATHING (O.S.)	 	8d	6" O.C.	8d	12" O.C.
4		NONE	5/8" GYPSUM SHEATHING (I.S.)	- 1/2 Ψ @ 16 O.C.	6d	7" O.C.	6d	T" O.C.
(5)	(2) 2X'S	DTT2Z	7/16" OSB SHEATHING (O.S.)	   /2"Φ @  6" Ο.C.	8d	6" O.C.	8d	12" O.C.
		D1122	5/8" GYPSUM SHEATHING (I.S.)	- 1/2 Ψ @ 16 O.C.	6d	7" O.C.	6d	T" O.C.
6	(2) 2X'S		7/16" OSB SHEATHING (O.S.)	1/2"¢ @ 16" O.C.	8d	6" O.C.	8d	12" O.C.
	(2/2/5	HDU2-SDS2.5	5/8" GYPSUM SHEATHING (I.S.)	1/2 4 @ 16 O.C.	6d	7" O.C.	6d	T" O.C.
			7/16" OSB SHEATHING (OS)		84	6"00	84	12" 0.0

shear wall schedule

	(4)	(2) 2X'5	NONE	7/16" OSB SHEATHING (O.S.)	1/2"¢ @ 16" O.C.	8d	6" O.C.	8d	12" 0.0.	
	4	(2/2/5	NONE	5/8" GYPSUM SHEATHING (I.S.)	1/2 4 @ 10 O.C.	6	7" O.C.	6d	T" O.C.	
	(5)	(2) 2X'S	DTT2Z	7/16" OSB SHEATHING (O.S.)	1/2"Φ @ 16" O.C.	8d	6" O.C.	8d	12" 0.0.	
	9	(2) 2 > 5	D1122	5/8" GYPSUM SHEATHING (I.S.)		6	T" O.C.	6d	T" O.C.	
	(6)	(2) 2X'S	UPUD CDCDE	7/16" OSB SHEATHING (O.S.)	1/2"¢ @ 16" O.C.	8d	6" O.C.	8d	12" 0.0.	
		(2) 2	HDU2-SDS2.5	5/8" GYPSUM SHEATHING (I.S.)	1/2 4 @ 16 0.0.	6d	7" O.C.	6d	7" O.C.	
	(7)	(2) 2X'S		7/16" OSB SHEATHING (O.S.)	 	8d	6" O.C.	8d	12" 0.0.	
	$\neg \cup \mid \cup \mid \cdot \mid$	(2) 2	C522	5/8" GYPSUM SHEATHING (I.S.)	160 NAILS @ 6 O.C.	6d	7" O.C.	6d	7" O.C.	
	(8)	(2) 2X'S	HDU4-SDS2.5	7/16" OSB SHEATHING (O.S.)		8d	6" O.C.	8d	12" 0.0.	
	0	(2) 2		5/8" GYPSUM SHEATHING (I.S.)	1/2 Ψ @ 16 O.C.	6d	7" O.C.	6d	7" O.C.	
	(q)	(2) 2X'S	5510	7/16" OSB SHEATHING (O.S.)	16d NAILS @ 8" O.C.	8d	6" O.C.	8d	12" 0.0.	
	9	(2) 2	CSI8	5/8" GYPSUM SHEATHING (I.S.)	160 NAILS @ 6 O.C.	6d	7" O.C.	6d	T" O.C.	
	(0)	(2) 2X'S	UPUS SPSSE	7/16" OSB SHEATHING (O.S.)	1/2"4 9 12" 0 6	8d	6" O.C.	8d	12" 0.0.	
		(2) 2	HDU8-SDS2.5	5/8" GYPSUM SHEATHING (I.S.)		6d	7" O.C.	6d	T" O.C.	
CATE	NOTES:	I. WHERE STUD M	UST BE CUT DUE TO THE PLACEMEN	NT OF ANCHORS BOLTS OR OTHER PRODUC	TS, AN		(	0.5.)	OUTSIDE	
VEL.										

ADDITIONAL STUD SHALL BE INSERTED ALONG SIDE.

2. SHEAR MALL SHEATHING SHALL BE A.P.A. RATED SHEATHING, EXPOSURE I (E.S.) EACH SID 3. PANEL EDGES SHALL BE SOLID BLOCKED WITH 2 x FRAMING MEMBER. 4. WALLS REFERRED TO SHALL BE FULL LENGTH COMMON WALLS. 5. #6 SCREWS x | 3/4" LG. TYPE S MAY BE SUBSTITUTED FOR 6d NAILS. 6. SOLE PLATE ATTACHMENT BASED ON 1/2" ♥ TITEN HD ANCHORS W 4 1/2" MINIMUM EMBEDMENT.

(2) 2x6 W/ W I/2" FILLER	JACK STUDS EA. END	KING STUI	OS EA END	CODED NOTES APPLY TO THE ENTIRE BUILDING. INDIVIDUAL IDENTIFICATION IS FOR REFERENCE ONLY.			
(2) 2x6 W/ W I/2" FILLER	EA. END	ROOF FRAMING					
(2) 2x6 W/ W I/2" FILLER		1.22	2ND FRAMING	MULTIPLE MICROLAMS SECURED TOGETHER IN			
		2	2	ACCORDANCE			
(2) 2×8 W/ W I/2" FILLER	ı	2	2	W/ MANUFACTURERS INSTRUCTIONS			
(2) 2×IO W/ I/2" FILLER	2	2	3	GIRDER TRUSSES SHALL HAVE MINIMUM 2x6 TOP \$			
(2) 2xl2 W/ I/2" FILLER	2	2	4	BOTTOM CHORDS TO FACILITATE FRAMING			
NOT USED				CONNECTIONS BETWEEN ADJOINING MEMBERS.  PROVIDE GREATER AS NEEDED. COORDINATE W/			
(2)   3/4 × 9  /4" LVL	2	2	3	SUPPORTED MEMBER HANGER REQUIREMENTS			
(2)   3/4 ×     /4" LVL	2	2	4				
M8x2  W/ CONT. 3/8" X  O  /2" PL.	-	-	-	THE ROOF TRUSS AND FRAMING LAYOUT DEPICTED HER IS CONCEPTUAL ONLY TO DEFINE THE DESIGN INTENT.			
(3) 2x6 W/(2) I/2" FILLER	I	ı	l	EXACT ROOF TRUSS LAYOUT AND FRAMING DESIGN SH			
(3) 2x8 W (2) 1/2" FILLER	ı	-	I	BE THE RESPONSIBILITY OF THE TRUSS SUPPLIER; WHO SHALL SUBMIT ENGINEERED AND SEALED TRUSS SHOP			
(3) 2xIO W/ (2) I/2" FILLER	2	-	1	DRAWINGS FOR REVIEW TO THE ARCHITECT. SHOULD R			
(3) 2x12 W/(2) 1/2" FILLER	2	-	l	<ul> <li>FRAMING BEARING LOCATIONS CHANGE FROM THAT</li> <li>DEPICTED, NOTIFY THE ARCHITECT IMMEDIATELY SO THE</li> </ul>			
				ANY NECESSARY COORDINATION CAN BE IMPLEMENTED			
	(2) 2×12 W/ 1/2" FILLER  NOT USED  (2)   3/4 × 9  /4" LVL  (2)   3/4 × 11  /4" LVL  W8×21 W CONT. 3/8" × IO 1/2" PL.  (3) 2×6 W/ (2) 1/2" FILLER  (3) 2×8 W/ (2) 1/2" FILLER  (3) 2×10 W/ (2) 1/2" FILLER	(2) 2×12 W/ 1/2" FILLER 2  NOT USED  (2) 1 3/4 × 9 1/4" LVL 2  (2) 1 3/4 × 11 1/4" LVL 2  W8×21 W/ CONT. 3/8" × 10 1/2" PL  (3) 2×6 W/ (2) 1/2" FILLER 1  (3) 2×6 W/ (2) 1/2" FILLER 1  (3) 2×6 W/ (2) 1/2" FILLER 2  (3) 2×10 W/ (2) 1/2" FILLER 2	(2) 2×12 W/ 1/2" FILLER 2 2  NOT USED  (2)   3/4 × 9   1/4" LVL 2 2  (2)   3/4 ×    1/4" LVL 2 2  (2)   3/4 ×    1/4" LVL 3 2  (3) 2×6 W/ (2)   1/2" FILLER	(2) 2×12 W 1/2" FILLER 2 2 4  NOT USED  (2) 1 3/4 × 9 1/4" LVL 2 2 3  (2) 1 3/4 × 11 1/4" LVL 2 2 4  W8×21 W CONT. 3/8" × 10 1/2" PL			

header schedule

MING	MULTIPLE MICROLAMS SECURED TOGETHER IN ACCORDANCE W/ MANUFACTURERS INSTRUCTIONS	
	GIRDER TRUSSES SHALL HAVE MINIMUM 2x6 TOP \$ BOTTOM CHORDS TO FACILITATE FRAMING CONNECTIONS BETWEEN ADJOINING MEMBERS. PROVIDE GREATER AS NEEDED. COORDINATE W/ SUPPORTED MEMBER HANGER REQUIREMENTS	
	THE ROOF TRUSS AND FRAMING LAYOUT DEPICTED HERE IS CONCEPTUAL ONLY TO DEFINE THE DESIGN INTENT. EXACT ROOF TRUSS LAYOUT AND FRAMING DESIGN SHALL BE THE RESPONSIBILITY OF THE TRUSS SUPPLIER; WHO SHALL SUBMIT ENGINEERED AND SEALED TRUSS SHOP DRAWINGS FOR REVIEW TO THE ARCHITECT. SHOULD ROOF FRAMING BEARING LOCATIONS CHANGE FROM THAT DEPICTED, NOTIFY THE ARCHITECT IMMEDIATELY SO THAT ANY NECESSARY COORDINATION CAN BE IMPLEMENTED.	

NOTES:

# LMHA Collingwood Green, Phase III

Collingwood Freen
"Quality affordable living within a green community."



THE ARRANGEMENTS DEPICTED HEREIN ARE THE SOLE PROPERTY OF BERARDI + PARTNERS, INC., ARCHITECTS AND ENGINEERS, AND MAY NOT BEREPRODUCED WITHOUT ITS WRITTEN PERMISSION

1. ALL BIDDERS SHALL VISIT THE SITE AND BECOME FAMILIAR W/
THE EXISTING CONDITIONS AND REQUIREMENTS OF THE PROJECT
AND SHALL NOTIFY THE ARCHITECT OF ANY ERRORS AND OMISSIONS
SUBSEQUENTLY DISCOVERED IN THE CONTRACT DOCUMENTS.

 THE CONTRACT DOCUMENTS ARE COMPRISED OF THE DRAWINGS AND
THE PROJECT MANUAL IN THEIR ENTIRETY. THE INFORMATION IN THESE
DOCUMENTS IS DEPENDENT UPON AND COMPLEMENTARY OF EACH OTHER, SEPARATION OF THE CONTRACT DOCUMENTS SHALL NOT BE PERMITTED. IF THE CONTRACTOR CHOOSES TO SEPARATE THE DOCUMENTS, THEY DO SO AT THEIR OWN RISK AND EXPENSE.

3. ADDITIONALLY, SEE GENERAL INFORMATION ON "AO" SHEETS.

4. THE CLIENT ACKNOWLEDGES THE CONSULTANT'S (ARCHITECT) DRAWINGS AND SPECIFICATION, INCLUDING ALL DOCUMENTS ON ELECTRONIC MEDIA AS INSTRUMENTS OF THE CONSULTANTS (ARCHITECT) PROFESSIONAL SERVICE. THE CLIENT SHALL NOT REUSE OR MAKE OR PERMIT TO BE MADE ANY MODIFICATION TO THE DRAWINGS AND SPECIFICATIONS WITHOUT THE PRIOR WRITTEN AUTHORIZATION OF THE CONSULTANT (ARCHITECT). THE CLIENT AGREES TO WAIVE ANY CLAIM AGAINST THE CONSULTANT (ARCHITECT ARISING FROM ANY UNAUTHORIZED TRANSFER, REUSE OR MODIFICATION OF THE DRAWINGS AND SPECIFICATIONS.

5. ARCHITECT CANNOT WARRANT THE ACCURACY OF DATA CONTAINED HEREIN. ANY USE OR REUSE OF ORIGINAL OR ALTERED CADD DESIGN MATERIALS BY THE USER OR APPROVAL OF THE ARCHITECT SHALL BE AT THE SOLE RISK OF THE USER. FURTHERMORE, USER AGREES TO DEFEND INDEMNIFY AND HOLD ARCHITECT HARMLESS FROM ALL CLAIMS, INJURIES, DAMAGES, LOSSES, EXPENSES, AND ATTORNEY'S FEES ARISING OUT OF THE MODIFICATION OR REUSE OF THESE MATERIALS.

6. THESE DRAWINGS AS PART OF THE CONTRACT DOCUMENTS ARE DIAGRAMMATIC AND ARE NOT INTENDED TO DEFINE EXACT QUANTITIES, LOCATIONS OR CODIFIED REQUIREMENTS. THE DRAMINGS SHALL NOT BESCALED.EXACT STATE AND LOCAL CODE REQUIREMENTS AND OTHER APPLICABLE CODE REQUIREMENTS SHALL BE VERIFIED BY AND ARE THE SOLE RESPONSIBILITY OF THIS CONTRACTOR. CODES OR ANY DISCREPANCIES FOUND IN THE CONTRACT DOCUMENTS SHALL BE BROUGHT TO THE ATTENTION OF THE PROJECT ARCHITECT

## Bid Set

14105

PROJECT DATE 09/06/2017 PROJECT #:

ADDENDUM 2 09/18/17

**BUILDING D** ROOF FRAMING

S103D



EXACT FLOOR TRUSS/JOIST LAYOUT AND DIMENSIONS ARE THE RESPONSIBILITY OF THE TRUSS FABRICATOR AND FRAMING SUBCONTRACTOR. TRUSS/JOIST LAYOUT SHALL BE COORDINATED WITH THE HVAC, PLUMBING AND ELECTRICAL SUBCONTRACTORS PRIOR TO SUBMISSION OF TRUSS SHOP DRAWINGS, FABRICATION AND INSTALLATION TO ENSURE THE PROPOSED LAYOUT PROVIDES NECESSARY CLEARANCES FOR THE HVAC, PLBG AND ELECTRICAL TRADE ELEMENTS, FIXTURES, DUCTING AND PIPING.


DO NOT CENTER TRUSSES ON CEILING RECESSES OR WITHIN 6" OF CENTERLINE OF DWELLING UNIT BEDROOM WINDOWS.


CONTRACTOR TO COORDINATE ADDITIONAL LOADING FOR BUILDING EQUIPMENT SYSTEMS TO FLOOR JOISTS - ROOF TRUSSES WITH MANUFACTURERS. EXACT FRAMING LAYOUT SHALL BE COORDINATED WITH OTHER TRADE SUBCONTRACTORS PRIOR TO INSTALLATION FOR ITEMS INCLUDING, BUT NOT LIMITED TO, THE ELECTRIC PANEL, ELECTRIC FIXTURES (INCLUDING CAN LIGHTS), MEDICINE CABINETS, CONTROL JOINTS, DOOR FRAMING AND HVAC DUCTS / SOFFITS.

IF THE LAYOUT IS CHANGED SUCH THAT THE LOADING ON HEADERS/BEAMS IS INCREASED, THE FRAMING SUBCONTRACTOR SHALL SUBMIT A REVISED SCHEDULE OF THOSE HEADERS/BEAMS STAMPED BY AN ENGINEER REGISTERED WITH THE STATE IN WHICH THE PROJECT IS TO BE LOCATED. EXTEND POSTS AND COLUMNS TO FOUNDATION. PROVIDE SOLID BLOCKING WITHIN FLOOR FRAMING SPACES.

C D ₩

∃ X

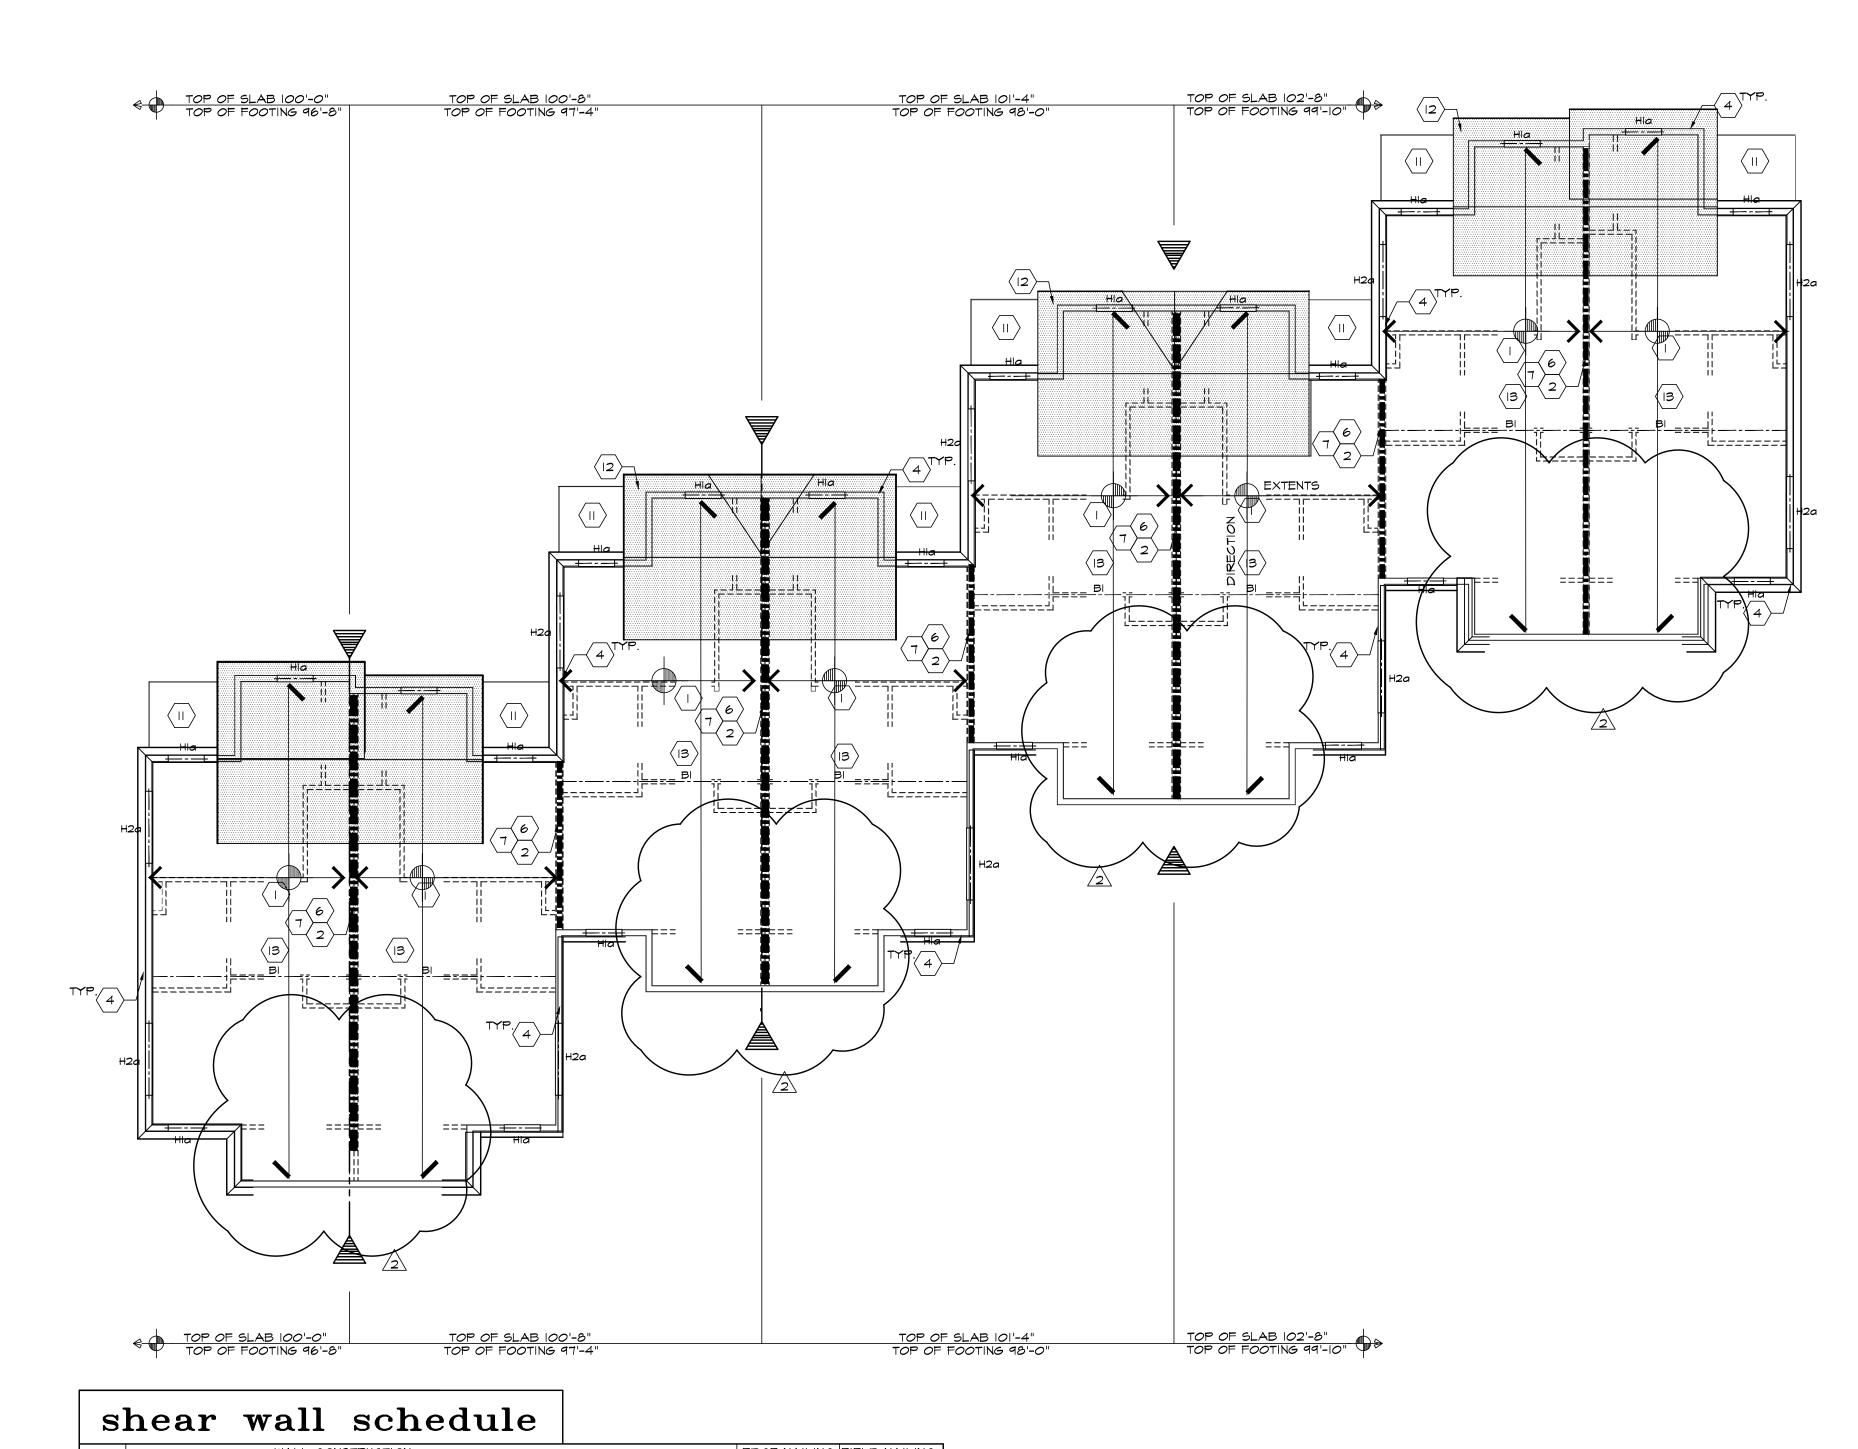

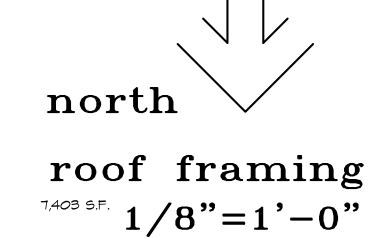

HOLDOWN MARK

HDI

ANCHOR TYPE

(I) MST 27

(2) 2x

Ooded notes of peck FRAMING ON				MARK WALL CONSTRUCTION		EDGE NAILING FIELD NAILING		,							
$igl  igcolon \mathbf{coded} \ \mathbf{notes} \ $ see deck framing on sio2			11/3/2/2	END STUDS	SIMPSON HOLDOWN	SHEATHING	SOLE E ATTACHMENT	T SIZE SPACING	S SIZE SPACING	<del>2</del>					
I. PRE-ENGINEERED WOOD ROOF TRUSSES @ 24" O.C. MAX. TYPICAL	beam	shedule		(2) 2'5	NONE	5/8" GYPSUM SHEATHING (E.S.)	16d NAILS @ 16" O.C.	. 6d 7" O.C.	6d 7" O.C.	header sc	hedu	ما		NOTES:	
U.N.O. REFER TO TRUSS ENGINIEER'S LAYOUT FOR SPECIFIC TRUSS PROFILES AND SPACING.		KING STUDS EA END	(2)	(2) 2'5	MSTC28	7/16" OSB SHEATHING (O.S.)	16d NAILS @ 8" O.C.	8d 6" O.C. 8d 12" O.C. 6d 7" O.C. M			neuu	10		CODED NOTES APPLY TO THE ENTIRE BUILDING.	
2. PROVIDE 8d NAILS @ 8" O.C. FULL HEIGHT FOR MULTIPLE STUDS	BI (3)   3/4" ×	/4" LVL 3				5/8" GYPSUM SHEATHING (I.S.)				MARK SIZE	JACK STUDS	KING STUE	S EA END	INDIVIDUAL IDENTIFICATION IS FOR REFERENCE ONLY.	
3. PROVIDE COMPRESSION/TENSION METAL "T" BRACING AT INTERIOR	B2 (2) 2x12 W/ 1/2		3	(2) 2'5	HDU2-SDS2.5 W/ 5/8" $\phi$ $ imes$ 14" LG. THREADED ROD	7/16" OSB SHEATHING (O.S.)	1/2"Φ @ 48" O.C.		8d 12" O.C. 6d 7" O.C.	_	EA. END	ROOF FRAMING	2ND FRAMING	MULTIPLE MICROLAMS SECURED TOGETHER IN	
TENANT COMMON WALLS NOT DESIGNATED AS SHEAR WALLS.  PROVIDE & INSTALL ONE BRACE EACH SIDE OF WALL TO MAKE &	(2)					7/16" OSB SHEATHING (I.S.)	<u>'</u>		8d 12" O.C.	HI (2) 2×6 W/ W I/2" FILLER	1	2	2	ACCORDANCE W/ MANUFACTURERS INSTRUCTIONS	
"X" AT EACH LOCATION.			(4)	(2) 2'5	HDU4-SDS2.5 W/ 5/8" $\phi$ × I4" L $g$ . THREADED R $\phi$ D	5/8" GYPSUM SHEATHING (I.S.)	- 1/2"Φ @ 48" <i>O.</i> C.	6d 7" O.C.	6d 7" O.C.	H2 (2) 2×8 W/ W I/2" FILLER	1	2	2	W MANUFACTURERS INSTRUCTIONS	
4. BUILDING EXTERIOR TO RECEIVE A FULL SHEETS OF 1/16" O.S.B.	B4 (2)   3/4" x 9				HDU5-SDS2.5 W/ 5/8" Ø	, ,			8d 12" O.C.		2	2	3	ALL GIRDER TRUSSES SHALL HAVE MINIMUM 2x6 TOP \$	
SHEATHING.	B5 (2)   3/4" ×	/4" LVL 2	(5)	(2) 2'5	× 14" LG. THREADED ROL	5/8" GYPSUM SHEATHING (I.S.)	1/2"Φ @ 32" <i>O.C.</i>		6d 7" O.C.		2	2	4	BOTTOM CHORDS TO FACILITATE FRAMING	
5. SECTION OF RAISED BOTTOM CHORD / REFER TO REFLECTED CEILING PLAN, BUILDING SECTIONS AND DETAILS.	B6 (4)   3/4" ×	/4" LVL 3			LIDUA COCO E MIZZZALIA		5)		8d 12" O.C.		_	_	·	CONNECTIONS BETWEEN ADJOINING MEMBERS.	
6. RATED BEARING WALLS EXTENDING TIGHT TO ROOF SHEATHING	B7 (2) 2 x 8	2	6	(3) 2'5		5/8" GYPSUM SHEATHING (I.S.)	- 1/2"Φ @ 24" <i>O.</i> C.		6d 7" O.C.		2	2	3	PROVIDE GREATER AS NEEDED. COORDINATE W/ SUPPORTED MEMBER HANGER REQUIREMENTS	
UN-INTERUPTED, SEE WALL SECTIONS PROVIDE & INSTALL 1/2"	B8 (2) 2 x 10 PT	2			HDUII-SDS2.5 W/ I" Ø	7/16" OSB SHEATHING (O.S.)	1/2   4 0 12   0 6	8d 6" O.C.	<del></del>	110 (2) 1 3) 4 X 1 1/4 EVE		2			
GWB OR 3/8" MIN. OSB DRAFTSTOPPING						OD 5/8" GYPSUM SHEATHING (I.S	//1.S.) 1/2"Φ @ 12" O.C.	6d 7" O.C. 6d 7" O.C.	H7 (2)   3/4 ×    1/4" LVL	2	2	<del></del>	THE ROOF TRUSS AND FRAMING LAYOUT DEPICTED HERE		
7. SHEAR WALL. SEE DETAILS E/A601 \$ H/S202			NOTES. I	I WHERE STIP MII	IST RE CUT DUE TO THE RI ACEME	NT OF ANCHORS BOLTS OR OTHER PRODU	CTS AN		(O.S.) OUTSIDE	LI W8x21 W/ CONT. 3/8" X 10 1/2" PL	· -	-	-	IS CONCEPTUAL ONLY TO DEFINE THE DESIGN INTENT.	
8. ONE HOUR ATTIC ACCESS PANEL 'BABCOCK-DAVIS' MODEL # B-IW		2ND FLOOR DECK FRAMING INDICATE FLOOR FRAMING BASE PLATE LEVEL.	NOTES: 1		UD SHALL BE INSERTED ALONG S		015, AN		(1.5.) INSIDE	HIa (3) 2×6 W/(2) I/2" FILLER	ı	I	ı	EXACT ROOF TRUSS LAYOUT AND FRAMING DESIGN SHALL BE THE RESPONSIBILITY OF THE TRUSS SUPPLIER; WHO	
22x36		FRAMING ON ONE LEVEL TO FRAMING	2		LL SHEATHING SHALL BE A.P.A. R			(E	E.S.) EACH SIDE	H2a (3) 2×8 W/ (2) I/2" FILLER	1	-	I	SHALL SUBMIT ENGINEERED AND SEALED TRUSS SHOP	
9. DO NOT OPEN ROOF SHEATHING 2'-O" EITHER SIDE OF	ON ANOTHER TO BE COORDINATED WITH DETAILS ON SHEET			3. ALL PANEL EDGES SHALL BE SOLID BLOCKED WITH 2 x FRAMING MEMBER.						H3a (3) 2x10 W (2) 1/2" FILLER	2	-	1	DRAWINGS FOR APPROVAL TO THE ARCHITECT. SHOULD	
FIREWALLS/SMOKE WALLS.	5202.		4. ALL MALLS REFERRED TO SHALL BE FULL LENGTH COMMON MALLS. 5. #6 SCREWS x   3/4" LG. TYPE S OR W MAY BE SUBSTITUTED FOR 6d NAILS.						H4a (3) 2×12 W/ (2) 1/2" FILLER	2	-	I	ROOF FRAMING BEARING LOCATIONS CHANGE FROM THAT DEPICTED, NOTIFY THE ARCHITECT IMMEDIATELY SO THAT		
O. CLEARSPAN 2-PLY GIRDER TRUSS	halda	n schodula				N HD ANCHORS W/ 40" EMBEDMENT.								ANY NECESSARY COORDINATION CAN BE IMPLEMENTED.	
II. 2x6 RAFTERS @ 24" O.C TYPICAL @ ENTRY PORCH ROOFS.	holdow	n schedule	CENE		ING NOTES, TYPIC AL	OF ALL GIBMITTED PLA	NG.					1			

12. EXTEND PLYWOOD SHEATHING OVER TOP CHORDS OF TRUSSES.

3. BEARING WALL SUPPORTED BY BEAM IN 2ND FLOOR DECK SYSTEM

CODED NOTES APPLY TO THE ENTIRE STRUCTURE. INDIVIDUALLY

OVERLAY TRUSSES @ 24" O.C. BY TRUSS SUPPLIER

IDENTIFIED LOCATIONS ARE FOR REFERENCE ONLY.

O D a ×

∃ X


GENERAL FRAMING NOTES: TYPICAL OF ALL SUBMITTED PLANS

EXACT FLOOR TRUSS/JOIST LAYOUT AND DIMENSIONS ARE THE RESPONSIBILITY OF THE TRUSS FABRICATOR AND FRAMING SUBCONTRACTOR. TRUSS/JOIST LAYOUT SHALL BE COORDINATED WITH THE HVAC, PLUMBING AND ELECTRICAL SUBCONTRACTORS PRIOR TO SUBMISSION OF TRUSS SHOP DRAWINGS, FABRICATION AND INSTALLATION TO ENSURE THE PROPOSED LAYOUT PROVIDES NECESSARY CLEARANCES FOR THE HVAC, PLBG AND ELECTRICAL TRADE ELEMENTS, FIXTURES, DUCTING AND PIPING.

DO NOT CENTER TRUSSES ON CEILING RECESSES OR WITHIN 6" OF CENTERLINE OF DWELLING UNIT BEDROOM WINDOWS.

CONTRACTOR TO COORDINATE ADDITIONAL LOADING FOR BUILDING EQUIPMENT SYSTEMS TO FLOOR JOISTS - ROOF TRUSSES WITH MANUFACTURERS. EXACT FRAMING LAYOUT SHALL BE COORDINATED WITH ALL OTHER TRADE SUBCONTRACTORS PRIOR TO INSTALLATION FOR ITEMS INCLUDING, BUT NOT LIMITED TO, THE ELECTRIC PANEL, ELECTRIC FIXTURES (INCLUDING CAN LIGHTS), MEDICINE CABINETS, CONTROL JOINTS, DOOR FRAMING AND HVAC DUCTS / SOFFITS.

IF THE LAYOUT IS CHANGED SUCH THAT THE LOADING ON HEADERS/BEAMS IS INCREASED, THE FRAMING SUBCONTRACTOR SHALL SUBMIT A REVISED SCHEDULE OF THOSE HEADERS/BEAMS STAMPED BY AN ENGINEER REGISTERED WITH THE STATE IN WHICH THE PROJECT IS TO BE LOCATED. EXTEND ALL POSTS AND COLUMNS TO FOUNDATION. PROVIDE SOLID BLOCKING WITHIN FLOOR FRAMING SPACES.

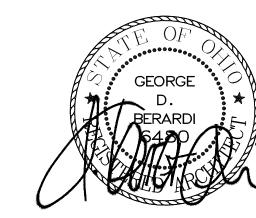

# LMHA Collingwood Green, Phase III

Collingwood Freen
"Quality affordable living within a green community."



THE ARRANGEMENTS DEPICTED HEREIN ARE THE SOLE PROPERTY OF BERARDI + PARTNERS, INC., ARCHITECTS AND ENGINEERS, AND MAY NOT BEREPRODUCED WITHOUT ITS WRITTEN PERMISSION

1. ALL BIDDERS SHALL VISIT THE SITE AND BECOME FAMILIAR W/
THE EXISTING CONDITIONS AND REQUIREMENTS OF THE PROJECT
AND SHALL NOTIFY THE ARCHITECT OF ANY ERRORS AND OMISSIONS
SUBSEQUENTLY DISCOVERED IN THE CONTRACT DOCUMENTS.

2. THE CONTRACT DOCUMENTS ARE COMPRISED OF THE DRAWINGS AND THE PROJECT MANUAL IN THEIR ENTIRETY. THE INFORMATION IN THESE DOCUMENTS IS DEPENDENT UPON AND COMPLEMENTARY OF EACH OTHER. SEPARATION OF THE CONTRACT DOCUMENTS SHALL NOT BE PERMITTED. IF THE CONTRACTOR CHOOSES TO SEPARATE THE DOCUMENTS, THEY DO SO AT THEIR OWN RISK AND EXPENSE

3. ADDITIONALLY, SEE GENERAL INFORMATION ON "AO" SHEETS.

4. THE CLIENT ACKNOWLEDGES THE CONSULTANT'S (ARCHITECT) DRAWINGS AND SPECIFICATION, INCLUDING ALL DOCUMENTS ON ELECTRONIC MEDIA AS INSTRUMENTS OF THE CONSULTANTS (ARCHITECT) PROFESSIONAL SERVICE. THE CLIENT SHALL NOT REUSE OR MAKE OR PERMIT TO BE MADE ANY MODIFICATION TO THE DRAWINGS AND SPECIFICATIONS WITHOUT THE PRIOR WRITTEN AUTHORIZATION OF THE CONSULTANT (ARCHITECT). THE CLIENT AGREES TO WAIVE ANY CLAIM AGAINST THE CONSULTANT (ARCHITECT ARISING FROM ANY UNAUTHORIZED TRANSFER, REUSE OR MODIFICATION OF THE DRAWINGS AND SPECIFICATIONS.

5. ARCHITECT CANNOT WARRANT THE ACCURACY OF DATA CONTAINED HEREIN. ANY USE OR REUSE OF ORIGINAL OR ALTERED CADD DESIGN MATERIALS BY THE USER OR APPROVAL OF THE ARCHITECT SHALL BE AT THE SOLE RISK OF THE USER. FURTHERMORE, USER AGREES TO DEFEND INDEMNIFY AND HOLD ARCHITECT HARMLESS FROM ALL CLAIMS, INJURIES, DAMAGES, LOSSES, EXPENSES, AND ATTORNEY'S FEES ARISING OUT OF THE MODIFICATION OR REUSE OF THESE MATERIALS.

6. THESE DRAWINGS AS PART OF THE CONTRACT DOCUMENTS ARE DIAGRAMMATIC AND ARE NOT INTENDED TO DEFINE EXACT QUANTITIES, LOCATIONS OR CODIFIED REQUIREMENTS. THE DRAWINGS SHALL NOT BE SCALED. EXACT STATE AND LOCAL CODE REQUIREMENTS AND OTHER APPLICABLE CODE REQUIREMENTS SHALL BE VERIFIED BY AND ARE THE SOLE RESPONSIBILITY OF THIS CONTRACTOR. CODES OR ANY DISCREPANCIES FOUND IN THE CONTRACT DOCUMENTS SHALL BE BROUGHT TO THE ATTENTION OF THE PROJECT ARCHITECT.

## Bid Set

PROJECT DATE 09/06/2017 PROJECT #:


ADDENDUM 2 09/18/17

**BUILDING E** ROOF FRAMING

S103E



Phone (614)221-1110) Fax (614)221-0831 www.berardipartners.com

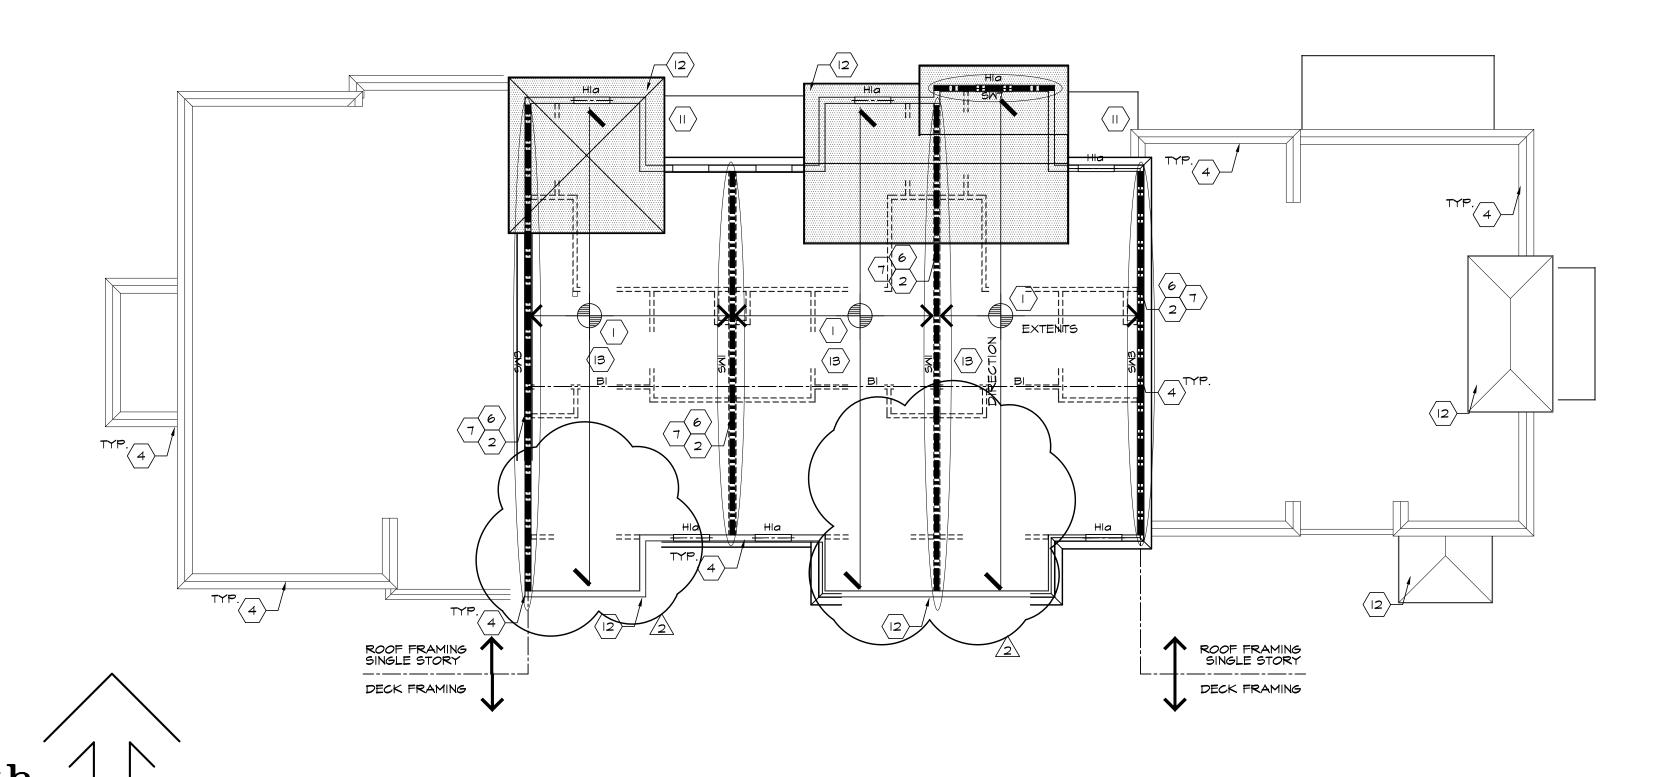

roof framing 1/8"=1'-0"

shear	wall	schedule

MARK END STUDS SIMPSON HOLDOWN

WALL CONSTRUCTION

				(2) 2X'S	NONE	5/8" GYPSUM SHEATHING (E.S.)	16d NAILS @ 16" O.C.	6d	7" O.C.	6d	7" O.C.			
			2	(2) 2X'S	NONE	5/8" GYPSUM SHEATHING (E.S.)	1/2"¢ @ 16" O.C.	6d	7" O.C.	6d	7" O.C.			
			(3)	(2) 2X'S	NONE	7/16" OSB SHEATHING (O.S.)	16d NAILS @ 6" O.C.	8d	6" O.C.	8d	12" O.C.			
1_			9	(2) 285	NONE	5/8" GYPSUM SHEATHING (I.S.)	160 NAILS @ 6 O.C.	6d	7" O.C.	6d	7" O.C.			
D	eam she	eaure	4	(2) 2X'S	NONE	7/16" OSB SHEATHING (O.S.)	1/2"¢ @ 16" O.C.	8d	6" O.C.	8d	12" O.C.			
	T		<del>1</del> )	(2) 2×5	NONE	5/8" GYPSUM SHEATHING (I.S.)		6d	7" O.C.	6d	7" O.C.			
		KING STUDS EA END	(b)	(2) 2X'S	DTT2Z	7/16" OSB SHEATHING (O.S.)	1/2"¢ @ 16" O.C.	8d	6" O.C.	8d	12" 0.0.			
 31	(3)   3/4" ×     /4" LVL	3	n)	(2) 2 2 3	D1122	5/8" GYPSUM SHEATHING (I.S.)	1/2 4 @ 10 O.C.	6d	7" O.C.	6d	7" O.C.			
э. В2	(2) 2x12 W/ 1/2" FILLER	2	6	(2) 2X'S	UDUO CDCOE	7/16" OSB SHEATHING (O.S.)	 	8d	6" O.C.	8d	12" O.C.			
	(3)   3/4 × 9  /4" LVL		0	(2/2/3	HDU2-SDS2.5	5/8" GYPSUM SHEATHING (I.S.)		6d	7" O.C.	6d	T" O.C.			
33		2	7	(2) 28/6		7/16" OSB SHEATHING (O.S.)	16 d NAIL 6 6 8" 0 6	8d	6" O.C.	8d	12" O.C.			
34	(2)   3/4" × 9  /4" LVL	2		(2) 2X'S	C522	5/8" GYPSUM SHEATHING (I.S.)	16d NAILS @ 8" O.C.	6d	7" O.C.	6d	7" O.C.			
35	(2)   3/4" ×     /4" LVL	2	8	(2) 22/6	UDUA CDCOT	7/16" OSB SHEATHING (O.S.)	1/2"¢ @ 16" O.C.	8d	6" O.C.	8d	12" O.C.			
36	(4)   3/4" ×     /4" LVL	3	9)	(2) 2X'S	HDU4-SDS2.5	5/8" GYPSUM SHEATHING (I.S.)	1/2 4 @ 16 O.C.	6d	T" O.C.	6d	7" O.C.			
37	(2) 2 × 8	2	(q	(2) 2X'S	6618	7/16" OSB SHEATHING (O.S.)	16d NAILS @ 8" O.C.	ø	6" O.C.	8d	12" O.C.			
38 38	(2) 2 × 10 PT	2	5)	(2/2/5	CSI8	5/8" GYPSUM SHEATHING (I.S.)	I BU NAILS @ 0 O.C.	6d	7" O.C.	6d	7" O.C.			
	(2/ 2 × 10 1 1		(2)	(2) 2X'S	LIDUA CDCOT	7/16" OSB SHEATHING (O.S.)	1/2"Φ @ 12" <i>O.</i> C.	8d	6" O.C.	8d	12" O.C.			
			<u>)</u>	(2) 2/3	HDU8-SDS2.5	5/8" GYPSUM SHEATHING (I.S.)		6d	7" O.C.	6d	7" O.C.			
HOLI	DOWNS SHOWN ON 2ND FLOOR	DECK FRAMING INDICATE	NOTES:	I. WHERE STUD MI	UST BE CUT DUE TO THE PLACEM	ENT OF ANCHORS BOLTS OR OTHER PRODUC	TS, AN	(O.S.) OUTSIDE						
	DWARE AT FIRST FLOOR FRAM				TUD SHALL BE INSERTED ALONG					(1.5.)	INSIDE			
HOLDOWNS BRIDGING FRAMING ON ONE LEVEL TO FRAMING				2. SHEAR WALL SHEATHING SHALL BE A.P.A. RATED SHEATHING, EXPOSURE I.						(E.S.) EACH SIDE				

7" O.C.	нз	(2) 2×IO W/ I/2" FILLER	2
12" O.C. 7" O.C.	H4	(2) 2xl2 W/ I/2" FILLER	2
1 0.C. 12" 0.C.	H5	NOT USED	
7" O.C.	H6	(2)   3/4 × 9  /4" LVL	2
12" O.C.	H7	(2)   3/4 ×     /4" LVL	2
7" O.C.	LI	W8x2  W/ CONT. 3/8" X  0  /2" PL.	-
UTSIDE	Hla	(3) 2×6 W/ (2) I/2" FILLER	I
INSIDE H SIDE	H2a	(3) 2×8 W/ (2) I/2" FILLER	I
711 31DL	НЗа	(3) 2×IO W/ (2) I/2" FILLER	2
	Н4а	(3) 2×12 W/ (2) I/2" FILLER	2

MARK SIZE

HI (2) 2×6 W/ W I/2" FILLER

H2 (2) 2x8 W/ W I/2" FILLER

header schedule

EA. END

2

2

2

2

3

3

4

EDGE NAILING FIELD NAILING

TSOLE IL ATTACHMENT SIZE SPACING SIZE SPACING

CODED NOTES APPLY TO THE ENTIRE BUILDING. INDIVIDUAL IDENTIFICATION IS FOR REFERENCE ONLY. JACK STUDS KING STUDS EA END MULTIPLE MICROLAMS SECURED TOGETHER IN ROOF FRAMING 2ND FRAMING ACCORDANCE W/ MANUFACTURERS INSTRUCTIONS GIRDER TRUSSES SHALL HAVE MINIMUM 2x6 TOP \$ BOTTOM CHORDS TO FACILITATE FRAMING

CONNECTIONS BETWEEN ADJOINING MEMBERS. PROVIDE GREATER AS NEEDED. COORDINATE W/ SUPPORTED MEMBER HANGER REQUIREMENTS

THE ROOF TRUSS AND FRAMING LAYOUT DEPICTED HERE IS CONCEPTUAL ONLY TO DEFINE THE DESIGN INTENT. EXACT ROOF TRUSS LAYOUT AND FRAMING DESIGN SHALL BE THE RESPONSIBILITY OF THE TRUSS SUPPLIER; WHO SHALL SUBMIT ENGINEERED AND SEALED TRUSS SHOP DRAWINGS FOR review TO THE ARCHITECT. SHOULD ROOF FRAMING BEARING LOCATIONS CHANGE FROM THAT DEPICTED, NOTIFY THE ARCHITECT IMMEDIATELY SO THAT ANY NECESSARY COORDINATION CAN BE IMPLEMENTED.

	PROVIDE & INSTALL ONE BRACE EACH SIDE OF WALL TO MAKE &	B3	(3)   3/4 ×
4	"X" AT EACH LOCATION. BUILDING EXTERIOR TO RECEIVE A FULL SHEETS OF 7/16" O.S.B.	B4	(2)   3/4" x
٦.	SHEATHING.	B5	(2)   3/4" ×
5.	SECTION OF RAISED BOTTOM CHORD / REFER TO REFLECTED	B6	(4)   3/4" ×
	CEILING PLAN BUILDING SECTIONS AND DETAILS		

CEILING PLAN, BUILDING SECTIONS AND DETAILS.

PROFILES AND SPACING.

占 X

coded notes see deck framing on

PRE-ENGINEERED WOOD ROOF TRUSSES @ 24" O.C. MAX. TYPICAL

U.N.O. REFER TO TRUSS ENGINIEER'S LAYOUT FOR SPECIFIC TRUSS

PROVIDE 8d NAILS @ 8" O.C. FULL HEIGHT FOR MULTIPLE STUDS

TENANT COMMON WALLS NOT DESIGNATED AS SHEAR WALLS.

PROVIDE COMPRESSION/TENSION METAL "T" BRACING AT INTERIOR

- RATED BEARING WALLS EXTENDING TIGHT TO ROOF SHEATHING UN-INTERUPTED, SEE WALL SECTIONS PROVIDE \$ INSTALL 1/2" GWB OR 3/8" MIN. OSB DRAFTSTOPPING
- SHEAR WALL. SEE DETAILS E/A601 & H/S202 . ONE HOUR ATTIC ACCESS PANEL 'BABCOCK-DAVIS' MODEL # B-II
- DO NOT OPEN ROOF SHEATHING 2'-O" EITHER SIDE OF FIREWALLS/SMOKE WALLS.
- O. CLEARSPAN 2-PLY GIRDER TRUSS 2x6 RAFTERS @ 24" O.C. - TYPICAL @ ENTRY PORCH ROOFS.

IDENTIFIED LOCATIONS ARE FOR REFERENCE ONLY.

12. EXTEND PLYWOOD SHEATHING OVER TOP CHORDS OF TRUSSES. OVERLAY TRUSSES @ 24" O.C. BY TRUSS SUPPLIER 3. BEARING WALL SUPPORTED BY BEAM IN 2ND FLOOR DECK SYST CODED NOTES APPLY TO THE ENTIRE STRUCTURE. INDIVIDUALLY

	B8	(2) 2 × 10	PT	2	2									
-IM		I. HOLDOWNS SHOWN ON 2ND FLOOR DECK FRAMING INDICATION HARDWARE AT FIRST FLOOR FRAMING BASE PLATE LEVEL												
		NOTHER TO B	NG FRAMING ON E COORDINATED											
	$\mathbf{h}$	oldo	wn s	che	dule									
TEM	HOLD	OWN MARK	ANCHOR TYP	E	END POST									
, I <b>–</b> I · · I		HDI	(I) MST 27		(2) 2x									

HARDWARE AT FIRST FLOOR FRAMING BASE PLATE LEVEL.  2. HOLDOWNS BRIDGING FRAMING ON ONE LEVEL TO FRAMING ON ANOTHER TO BE COORDINATED WITH DETAILS ON SHEET \$202.							
holdown schedule							
HOLDOWN MARK	ANCHOR TYPE	END POST					
HDI	(I) MST 27 (2) 2x						

6. SOLE PLATE ATTACHMENT BASED ON 1/2" TITEN HD ANCHORS W/ 4 1/2" MINIMUM EMBEDMENT. GENERAL FRAMING NOTES: TYPICAL OF SUBMITTED PLANS

3. PANEL EDGES SHALL BE SOLID BLOCKED WITH 2 x FRAMING MEMBER.

5. #6 SCREWS x | 3/4" LG. TYPE S MAY BE SUBSTITUTED FOR 6d NAILS.

4. WALLS REFERRED TO SHALL BE FULL LENGTH COMMON WALLS.

EXACT FLOOR TRUSS/JOIST LAYOUT AND DIMENSIONS ARE THE RESPONSIBILITY OF THE TRUSS FABRICATOR AND FRAMING SUBCONTRACTOR. TRUSS/JOIST LAYOUT SHALL BE COORDINATED WITH THE HVAC, PLUMBING AND ELECTRICAL SUBCONTRACTORS PRIOR TO SUBMISSION OF TRUSS SHOP DRAWINGS, FABRICATION AND INSTALLATION TO ENSURE THE PROPOSED LAYOUT PROVIDES NECESSARY CLEARANCES FOR THE HVAC, PLBG AND ELECTRICAL TRADE ELEMENTS, FIXTURES, DUCTING AND PIPING.

DO NOT CENTER TRUSSES ON CEILING RECESSES OR WITHIN 6" OF CENTERLINE OF DWELLING UNIT BEDROOM WINDOWS.

SHEATHING

CONTRACTOR TO COORDINATE ADDITIONAL LOADING FOR BUILDING EQUIPMENT SYSTEMS TO FLOOR JOISTS - ROOF TRUSSES WITH MANUFACTURERS. EXACT FRAMING LAYOUT SHALL BE COORDINATED WITH OTHER TRADE SUBCONTRACTORS PRIOR TO INSTALLATION FOR ITEMS INCLUDING, BUT NOT LIMITED TO, THE ELECTRIC PANEL, ELECTRIC FIXTURES (INCLUDING CAN LIGHTS), MEDICINE CABINETS, CONTROL JOINTS, DOOR FRAMING AND HVAC DUCTS / SOFFITS.

F THE LAYOUT IS CHANGED SUCH THAT THE LOADING ON HEADERS/BEAMS IS INCREASED, THE FRAMING SUBCONTRACTOR SHALL SUBMIT A REVISED SCHEDULE OF THOSE HEADERS/BEAMS STAMPED BY AN ENGINEER REGISTERED WITH THE STATE IN WHICH THE PROJECT IS TO BE LOCATED. EXTEND POSTS AND COLUMNS TO FOUNDATION. PROVIDE SOLID BLOCKING WITHIN FLOOR FRAMING SPACES.

# LMHA Collingwood Green, Phase III

Collingwood Green
"Quality affordable living within a green community."



THE ARRANGEMENTS DEPICTED HEREIN ARE THE SOLE PROPERTY OF BERARDI + PARTNERS, INC., ARCHITECTS AND ENGINEERS, AND MAY NOT BE REPRODUCED WITHOUT ITS WRITTEN PERMISSION

1. ALL BIDDERS SHALL VISIT THE SITE AND BECOME FAMILIAR W/
THE EXISTING CONDITIONS AND REQUIREMENTS OF THE PROJECT
AND SHALL NOTIFY THE ARCHITECT OF ANY ERRORS AND OMISSIONS
SUBSEQUENTLY DISCOVERED IN THE CONTRACT DOCUMENTS.

 THE CONTRACT DOCUMENTS ARE COMPRISED OF THE DRAWINGS AND THE PROJECT MANUAL IN THEIR ENTIRETY. THE INFORMATION IN THESE DOCUMENTS IS DEPENDENT UPON AND COMPLEMENTARY OF EACH OTHER, SEPARATION OF THE CONTRACT DOCUMENTS SHALL NOT BE PERMITTED. IF THE CONTRACTOR CHOOSES TO SEPARATE THE DOCUMENTS, THEY DO SO AT THEIR OWN RISK AND EXPENSE

3. ADDITIONALLY, SEE GENERAL INFORMATION ON "AO" SHEETS. 4. THE CLIENT ACKNOWLEDGES THE CONSULTANT'S (ARCHITECT) DRAWINGS AND SPECIFICATION, INCLUDING ALL DOCUMENTS ON ELECTRONIC MEDIA AS INSTRUMENTS OF THE CONSULTANTS (ARCHITECT) PROFESSIONAL SERVICE. THE CLIENT SHALL NOT REUSE OR MAKE OR PERMIT TO BE MADE ANY MODIFICATION TO THE DRAWINGS AND SPECIFICATIONS WITHOUT THE PRIOR WRITTEN AUTHORIZATION OF THE CONSULTANT (ARCHITECT). THE CLIENT AGREES TO WAIVE ANY CLAIM AGAINST THE CONSULTANT (ARCHITECT ARISING FROM ANY UNAUTHORIZED TRANSFER, REUSE OR MODIFICATION OF THE DRAWINGS AND SPECIFICATIONS.

5. ARCHITECT CANNOT WARRANT THE ACCURACY OF DATA CONTAINED HEREIN. ANY USE OR REUSE OF ORIGINAL OR ALTERED CADD DESIGN MATERIALS BY THE USER OR APPROVAL OF THE ARCHITECT SHALL BE AT THE SOLE RISK OF THE USER. FURTHERMORE, USER AGREES TO DEFEND, INDEMNIFY, AND HOLD ARCHITECT HARMLESS FROM ALL CLAIMS, INJURIES, DAMAGES, LOSSES, EXPENSES, AND ATTORNEY'S FEES ARISING OUT OF THE MODIFICATION OR REUSE OF THESE MATERIALS

6. THESE DRAWINGS AS PART OF THE CONTRACT DOCUMENTS ARE DIAGRAMMATIC AND ARE NOT INTENDED TO DEFINE EXACT QUANTITIES, LOCATIONS OR CODIFIED REQUIREMENTS. THE DRAWINGS SHALL NOT BE SCALED. EXACT STATE AND LOCAL CODE REQUIREMENTS AND OTHER APPLICABLE CODE REQUIREMENTS SHALL BE VERIFIED BY AND ARE THE SOLE RESPONSIBILITY OF THIS CONTRACTOR. CODES OR ANY DISCREPANCIES FOUND IN THE CONTRACT DOCUMENTS

### Bid Set

14105

SHALL BE BROUGHT TO THE ATTENTION OF THE PROJECT ARCHITECT


PROJECT DATE 09/06/2017 PROJECT #:

ADDENDUM 2 09/18/17

**BUILDING F** ROOF FRAMING

S103F



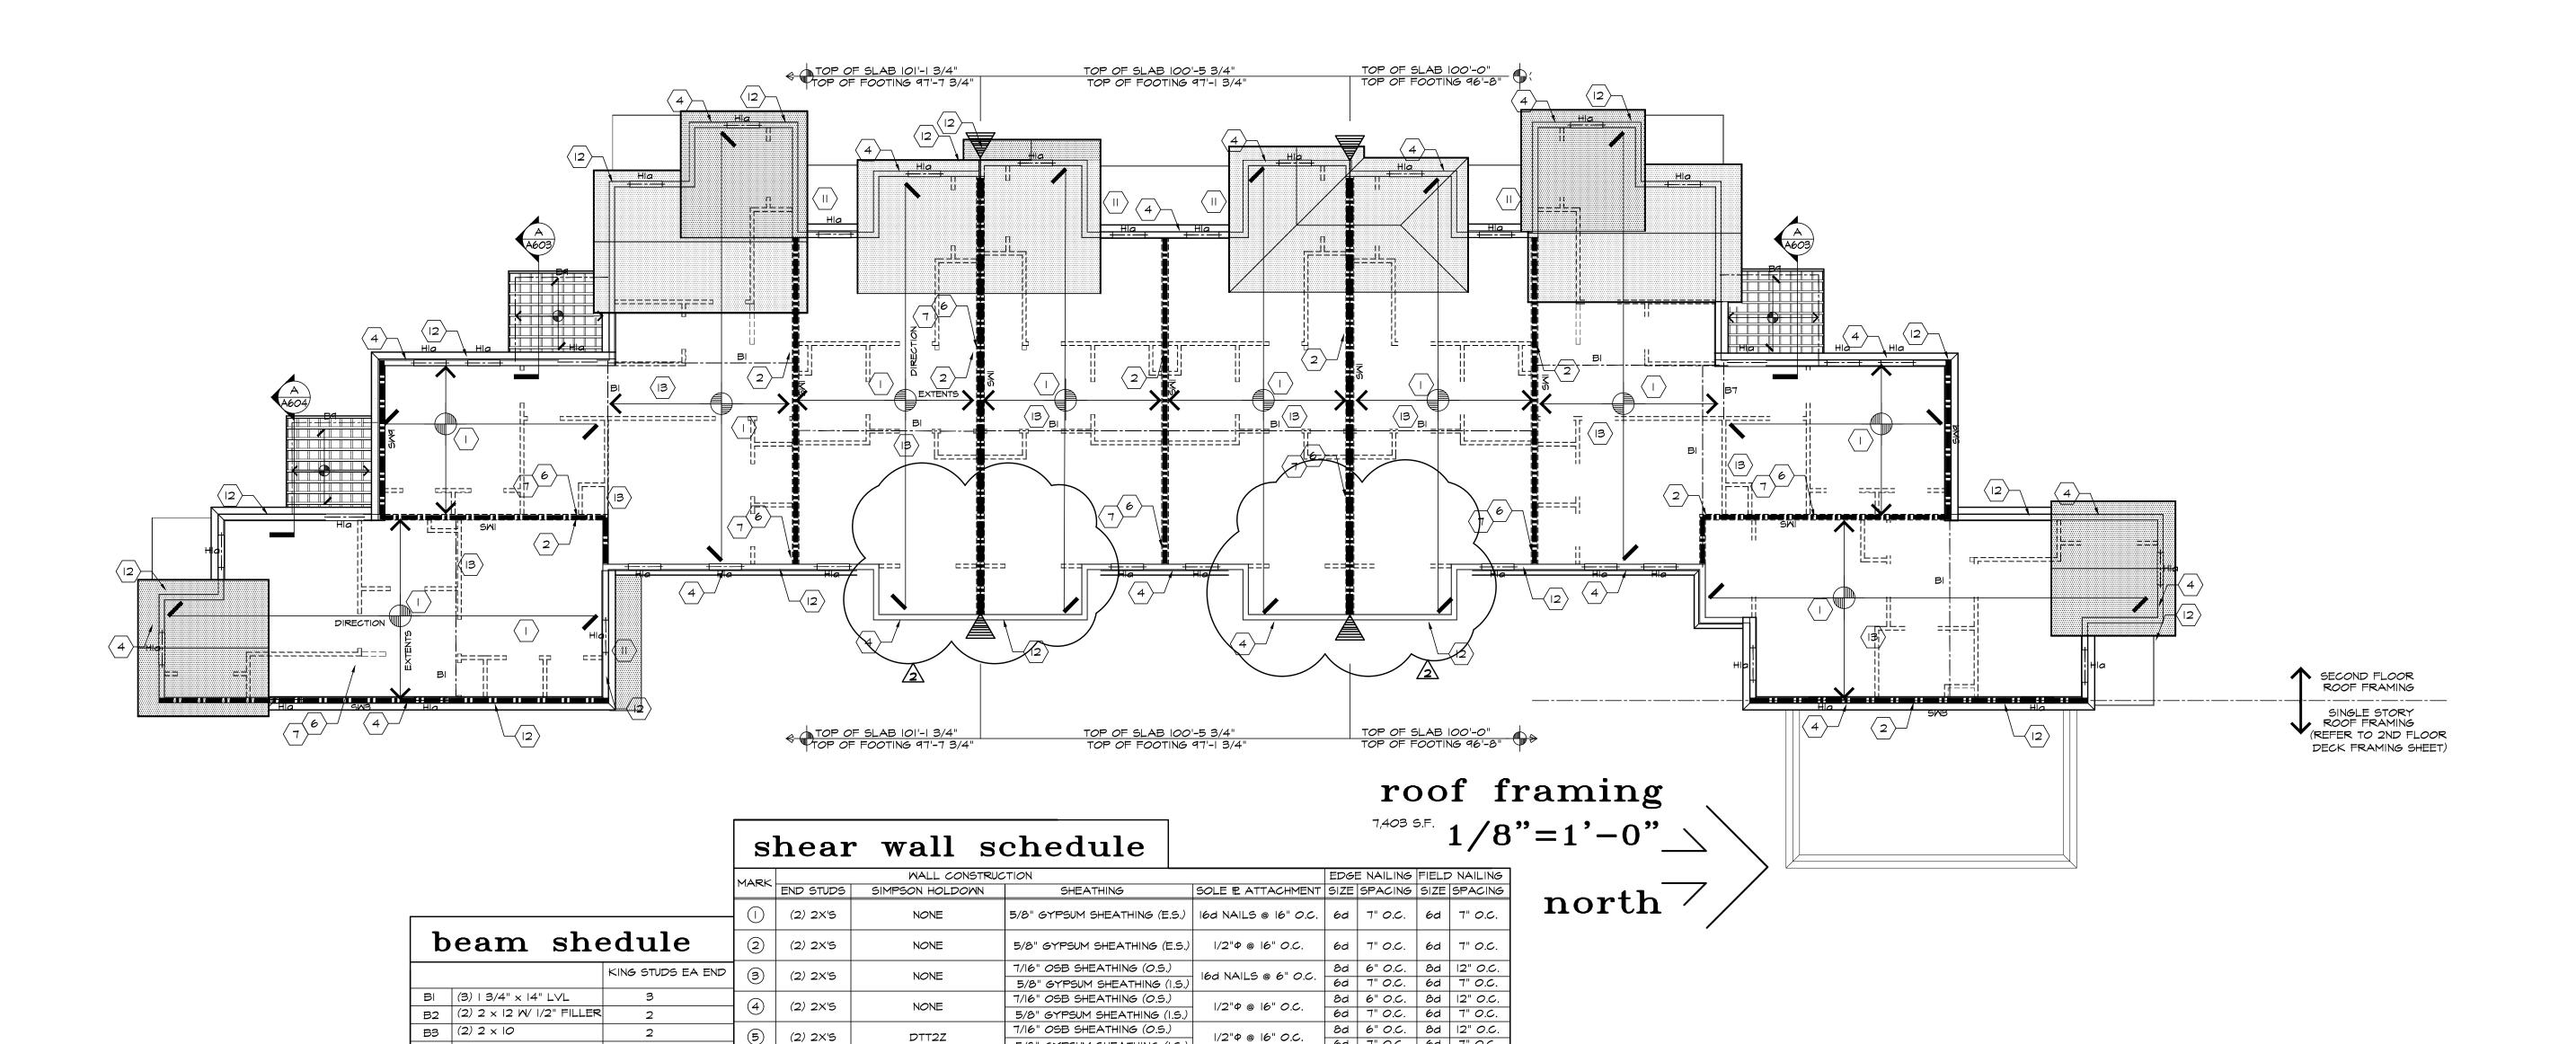

6d 7" O.C. 6d 7" O.C.

8d | 6" O.C. | 8d | 12" O.C.

6d 7" O.C. 6d 7" O.C.

8d | 6" O.C. | 8d | 12" O.C.

6d 7" O.C. 6d 7" O.C.

(O.S.) OUTSIDE

(E.S.) EACH SIDE

(I.S.) INSIDE

LMHA Collingwood Green, Phase III

Collingwood Green



THE ARRANGEMENTS DEPICTED HEREIN ARE THE SOLE PROPERTY OF BERARDI + PARTNERS, INC., ARCHITECTS AND ENGINEERS
AND MAY NOT BE REPRODUCED WITHOUT ITS WRITTEN PERMISSION

ALL BIDDERS SHALL VISIT THE SITE AND BECOME FAMILIAR W/
THE EXISTING CONDITIONS AND REQUIREMENTS OF THE PROJECT
AND SHALL NOTIFY THE ARCHITECT OF ANY ERRORS AND OMISSIONS
SUBSEQUENTLY DISCOVERED IN THE CONTRACT DOCUMENTS.

2. THE CONTRACT DOCUMENTS ARE COMPRISED OF THE DRAWINGS AND THE PROJECT MANUAL IN THEIR ENTIRETY. THE INFORMATION IN THESE DOCUMENTS IS DEPENDENT UPON AND COMPLEMENTARY OF EACH OTHER, SEPARATION OF THE CONTRACT DOCUMENTS SHALL NOT BE PERMITTED. IF THE CONTRACTOR CHOOSES TO SEPARATE THE DOCUMENTS, THEY DO SO AT THEIR OWN RISK AND EXPEN

3. ADDITIONALLY, SEE GENERAL INFORMATION ON "AO" SHEET 4. THE CLIENT ACKNOWLEDGES THE CONSULTANT'S (ARCHITECT) DRAWINGS AND SPECIFICATION, INCLUDING ALL DOCUMENTS ON ELECTRONIC MEDIA AS INSTRUMENTS OF THE CONSULTANTS (ARCHITECT) PROFESSIONAL SERVICE THE CLIENT SHALL NOT REUSE OR MAKE OR PERMIT TO BE MADE ANY MODIFICATION TO THE DRAWINGS AND SPECIFICATIONS WITHOUT THE PRIOR WRITTEN AUTHORIZATION OF THE CONSULTANT (ARCHITECT). THE CLIENT AGREES TO WAIVE ANY CLAIM AGAINST THE CONSULTANT (ARCHITECT ARISING FROM ANY UNAUTHORIZED TRANSFER, REUSE OR MODIFICATION OF THE DRAWINGS AND SPECIFICATIONS. 5. ARCHITECT CANNOT WARRANT THE ACCURACY OF DATA

CONTAINED HEREIN. ANY USE OR REUSE OF ORIGINAL OR ALTERED CADD DESIGN MATERIALS BY THE USER OR APPROVAL OF THE ARCHITECT SHALL BE AT THE SOLE RISK OF THE USER. FURTHERMORE, USER AGREES TO DEFEND INDEMNIEY AND HOLD ARCHITECT HARMLESS FROM ALL CLAIMS, INJURIES, DAMAGES, LOSSES EXPENSES. AND ATTORNEY'S FEES ARISING OUT OF THE MODIFICATION OR REUSE OF THESE MATERIALS

6. THESE DRAWINGS AS PART OF THE CONTRACT DOCUMENTS ARE DIAGRAMMATIC AND ARE NOT INTENDED TO DEFINE EXACT QUANTITIES CATIONS OR CODIFIED REQUIREMENTS. THE DRAWINGS SHALL NO BE SCALED, EXACT STATE AND LOCAL CODE REQUIREMENTS AND OTHER APPLICABLE CODE REQUIREMENTS SHALL BE VERIFIED BY AND ARE THE SOLE RESPONSIBILITY OF THIS CONTRACTOR CODES OR ANY DISCREPANCIES FOUND IN THE CONTRACT DOCUMENT

Bid Set

09/06/2017

PROJECT DATE PROJECT #:

ADDENDUM 2 09/18/17

**BUILDING H** ROOF FRAMING

S103H

architecture + interior design + engineering 1398 Goodale Blvd. Columbus, Ohio 43212 Phone (614)221-1110) Fax (614)221-0831

www.berardipartners.com

(I) MST 27 (2) 2× HD2

HARDWARE AT FIRST FLOOR FRAMING BASE PLATE LEVEL.

2. HOLDOWNS BRIDGING FRAMING ON ONE LEVEL TO FRAMING ON ANOTHER TO BE COORDINATED WITH DETAILS ON SHEET

holdown schedule

ANCHOR TYPE

2

PRE-ENGINEERED WOOD ROOF TRUSSES @ 24" O.C. MAX. TYPICAL U.N.O. REFER TO TRUSS ENGINIEER'S LAYOUT FOR SPECIFIC TRUSS PROFILES AND SPACING.

coded notes see deck framing on

B4 (2) | 3/4" × 9 |/4" LVL

B5 (2) | 3/4" x || |/4" LVL

B6 (4) | 3/4" × 9 |/4" LVL

BIO (2) 2 x 8 W/ I/2" FILLER

(2) | 3/4 × |6" LVL

BI2 (2) | 3/4 x |4" LVL

B7 (2) 2 x 8

HOLDOWN MARK

B8 (2) 2 x 10 PT

B9 (2) 2 x 10 PT

- PROVIDE 8d NAILS @ 8" O.C. FULL HEIGHT FOR MULTIPLE STUDS PROVIDE COMPRESSION/TENSION METAL "T" BRACING AT INTERIOR TENANT COMMON WALLS NOT DESIGNATED AS SHEAR WALLS.
- "X" AT EACH LOCATION. BUILDING EXTERIOR TO RECEIVE A FULL SHEETS OF 7/16" O.S.B. SHEATHING.
- SECTION OF RAISED BOTTOM CHORD / REFER TO REFLECTED CEILING PLAN, BUILDING SECTIONS AND DETAILS.
- RATED BEARING WALLS EXTENDING TIGHT TO ROOF SHEATHING UN-INTERUPTED, SEE WALL SECTIONS PROVIDE & INSTALL 1/2" GWB OR 3/8" MIN. OSB DRAFTSTOPPING
- SHEAR WALL. SEE DETAILS E/A601 \$ H/S202
- ONE HOUR ATTIC ACCESS PANEL 'BABCOCK-DAVIS' MODEL # B-IW
- DO NOT OPEN ROOF SHEATHING 2'-O" EITHER SIDE OF
- FIREMALLS/SMOKE WALLS.

占 X

- 2. CLEARSPAN 2-PLY GIRDER TRUSS 2x6 RAFTERS @ 24" O.C. - TYPICAL @ ENTRY PORCH ROOFS.
- . EXTEND PLYWOOD SHEATHING OVER TOP CHORDS OF TRUSSES. OVERLAY TRUSSES @ 24" O.C. BY TRUSS SUPPLIER
- BEARING WALL SUPPORTED BY BEAM IN 2ND FLOOR DECK SYSTEM
- CODED NOTES APPLY TO THE ENTIRE STRUCTURE. INDIVIDUALLY IDENTIFIED LOCATIONS ARE FOR REFERENCE ONLY.

#### END POST CODED NOTES APPLY TO THE ENTIRE BUILDING. INDIVIDUAL IDENTIFICATION IS FOR REFERENCE ONLY. 1ARK SIZE KING STUDS EA END MULTIPLE MICROLAMS SECURED TOGETHER IN ACCORDANCE HI (2) 2×6 W/ W I/2" FILLER 2 2 W/ MANUFACTURERS INSTRUCTIONS (2) 2×8 W/ W I/2" FILLER 2 (2) 2×10 W/ 1/2" FILLER 2 2 GIRDER TRUSSES SHALL HAVE MINIMUM 2x6 TOP \$ BOTTOM CHORDS TO FACILITATE FRAMING 2 (2) 2x12 W/ 1/2" FILLER 2 CONNECTIONS BETWEEN ADJOINING MEMBERS. NOT USED PROVIDE GREATER AS NEEDED. COORDINATE W/ SUPPORTED MEMBER HANGER REQUIREMENTS H6 (2) | 3/4 × 9 |/4" LVL 2 (2) | 3/4 × || |/4" LVL 2 2 | W8x2| W/ CONT. 3/8" X |O |/2" PL PROVIDE & INSTALL ONE BRACE EACH SIDE OF WALL TO MAKE & HIa (3) 2×6 W/(2) I/2" FILLER H2a (3) 2×8 W (2) 1/2" FILLER H3a (3) 2x10 W/(2) 1/2" FILLER H4a (3) 2×12 W/ (2) 1/2" FILLER

HDU2-SDS2.5

HDU4-SDS2.5

HDU8-SDS2.5

2. SHEAR WALL SHEATHING SHALL BE A.P.A. RATED SHEATHING, EXPOSURE 1.

6. SOLE PLATE ATTACHMENT BASED ON 1/2" OTITEN HD ANCHORS W 4 1/2" MINIMUM EMBEDMENT.

3. PANEL EDGES SHALL BE SOLID BLOCKED WITH 2 x FRAMING MEMBER.

4. WALLS REFERRED TO SHALL BE FULL LENGTH COMMON WALLS. 5. #6 SCREMS x | 3/4" LG. TYPE S MAY BE SUBSTITUTED FOR 6d NAILS.

header schedule

ADDITIONAL STUD SHALL BE INSERTED ALONG SIDE.

(6) (2) 2X'5

(7) | (2) 2X'S

(8) (2) 2X'5

(9) | (2) 2X'S

(o) (2) 2x'5

HOLDOWNS SHOWN ON 2ND FLOOR DECK FRAMING INDICATE NOTES: I. WHERE STUD MUST BE CUT DUE TO THE PLACEMENT OF ANCHORS BOLTS OR OTHER PRODUCTS, AN

THE ROOF TRUSS AND FRAMING LAYOUT DEPICTED HERE IS CONCEPTUAL ONLY TO DEFINE THE DESIGN INTENT. EXACT ROOF TRUSS LAYOUT AND FRAMING DESIGN SHALL BE THE RESPONSIBILITY OF THE TRUSS SUPPLIER; WHO SHALL SUBMIT ENGINEERED AND SEALED TRUSS SHOP DRAWINGS FOR REVIEW TO THE ARCHITECT. SHOULD ROOF FRAMING BEARING LOCATIONS CHANGE FROM THAT DEPICTED, NOTIFY THE ARCHITECT IMMEDIATELY SO THAT ANY NECESSARY COORDINATION CAN BE IMPLEMENTED.

16d NAILS @ 8" O.C.

16d NAILS @ 8" O.C.

l/2"Φ @ l2" *O.*C.

#### GENERAL FRAMING NOTES: TYPICAL OF SUBMITTED PLANS

EXACT FLOOR TRUSS/JOIST LAYOUT AND DIMENSIONS ARE THE RESPONSIBILITY OF THE TRUSS FABRICATOR AND FRAMING SUBCONTRACTOR. TRUSS/JOIST LAYOUT SHALL BE COORDINATED WITH THE HVAC, PLUMBING AND ELECTRICAL SUBCONTRACTORS PRIOR TO SUBMISSION OF TRUSS SHOP DRAWINGS, FABRICATION AND INSTALLATION TO ENSURE THE PROPOSED LAYOUT PROVIDES NECESSARY CLEARANCES FOR THE HVAC, PLBG AND ELECTRICAL TRADE ELEMENTS, FIXTURES, DUCTING AND PIPING.

DO NOT CENTER TRUSSES ON CEILING RECESSES OR WITHIN 6" OF CENTERLINE OF DWELLING UNIT BEDROOM WINDOWS.

5/8" GYPSUM SHEATHING (I.S

7/16" OSB SHEATHING (O.S.)

5/8" GYPSUM SHEATHING (I.S

7/16" OSB SHEATHING (O.S.)

5/8" GYPSUM SHEATHING (I.S

5/8" GYPSUM SHEATHING (I.S

7/16" OSB SHEATHING (O.S.)

5/8" GYPSUM SHEATHING (I.S.


5/8" GYPSUM SHEATHING (I.S.)

7/16" OSB SHEATHING (O.S.)

7/16" OSB SHEATHING (O.S.)

CONTRACTOR TO COORDINATE ADDITIONAL LOADING FOR BUILDING EQUIPMENT SYSTEMS TO FLOOR JOISTS - ROOF TRUSSES WITH MANUFACTURERS. EXACT FRAMING LAYOUT SHALL BE COORDINATED WITH OTHER TRADE SUBCONTRACTORS PRIOR TO INSTALLATION FOR ITEMS INCLUDING, BUT NOT LIMITED TO, THE ELECTRIC PANEL, ELECTRIC FIXTURES (INCLUDING CAN LIGHTS), MEDICINE CABINETS, CONTROL JOINTS, DOOR FRAMING AND HVAC DUCTS / SOFFITS.

THE LAYOUT IS CHANGED SUCH THAT THE LOADING ON HEADERS/BEAMS IS INCREASED, THE FRAMING SUBCONTRACTOR SHALL SUBMIT A REVISED SCHEDULE OF THOSE HEADERS/BEAMS STAMPED BY AN ENGINEER REGISTERED WITH THE STATE IN WHICH THE PROJECT IS TO BE LOCATED. EXTEND POSTS AND COLUMNS TO FOUNDATION. PROVIDE SOLID BLOCKING WITHIN FLOOR FRAMING SPACES.

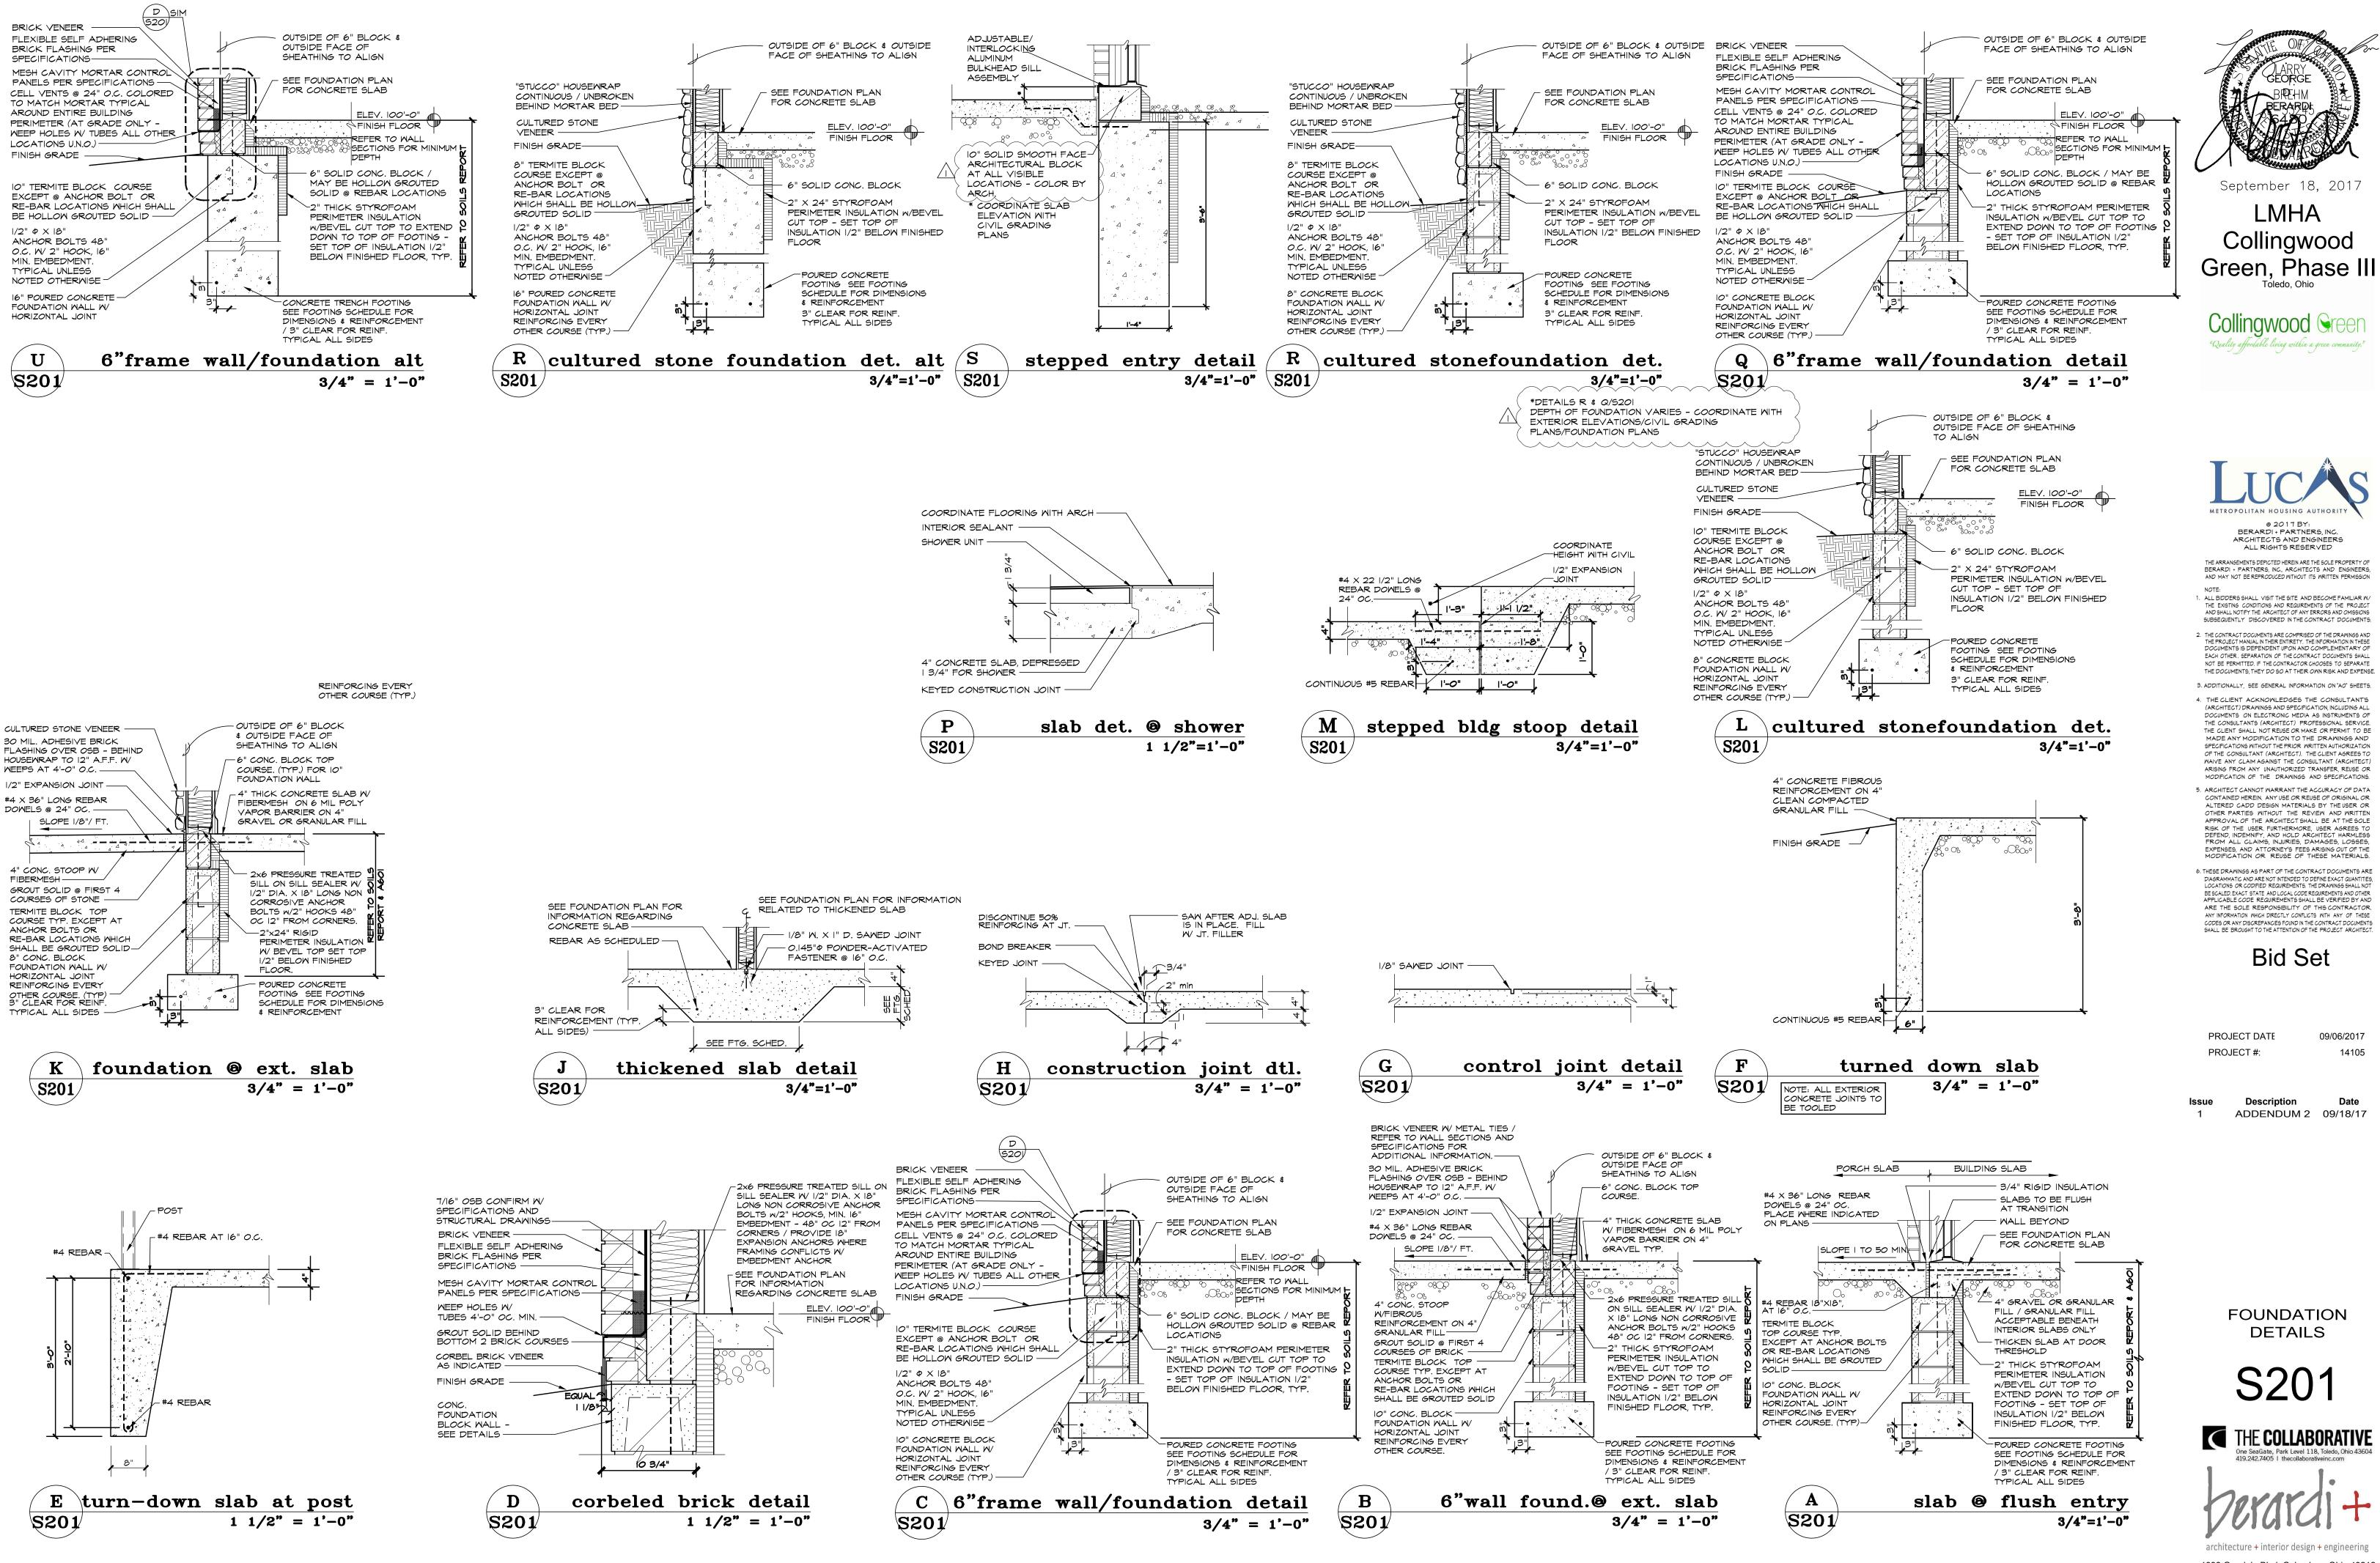

B X

BPF+HM BERARDL

September 18, 2017 **LMHA** Collingwood

BERARDI + PARTNERS, INC ARCHITECTS AND ENGINEERS ALL RIGHTS RESERVED

THE ARRANGEMENTS DEPICTED HEREIN ARE THE SOLE PROPERTY OF BERARDI + PARTNERS, INC., ARCHITECTS AND ENGINEERS AND MAY NOT BE REPRODUCED WITHOUT ITS WRITTEN PERMISSION

. ALL BIDDERS SHALL VISIT THE SITE AND BECOME FAMILIAR WARRY AND STREET SHALL VISIT THE SITE AND BECOME FAMILIAR WARRY AND STREET SHALL VISIT THE SITE AND BECOME FAMILIAR WARRY AND STREET SHALL VISIT THE SITE AND BECOME FAMILIAR WARRY AND STREET SHALL VISIT THE SITE AND BECOME FAMILIAR WARRY AND STREET SHALL VISIT THE SITE AND STREET SHALL VISIT WARRY AND STREET SHALL VISIT THE SITE AND STREET SHALL VISIT WARRY AND STREET SHALL VISIT THE SITE AND STREET SHALL VISIT WARRY WA THE EXISTING CONDITIONS AND REQUIREMENTS OF THE PROJEC AND SHALL NOTIFY THE ARCHITECT OF ANY ERRORS AND OMISSIONS SUBSEQUENTLY DISCOVERED IN THE CONTRACT DOCUMENTS

2. THE CONTRACT DOCUMENTS ARE COMPRISED OF THE DRAWINGS AND THE PROJECT MANUAL IN THEIR ENTIRETY. THE INFORMATION IN THESE DOCUMENTS IS DEPENDENT UPON AND COMPLEMENTARY OF EACH OTHER, SEPARATION OF THE CONTRACT DOCUMENTS SHALL NOT BE PERMITTED. IF THE CONTRACTOR CHOOSES TO SEPARATI

THE DOCUMENTS, THEY DO SO AT THEIR OWN RISK AND EXPENS 3. ADDITIONALLY, SEE GENERAL INFORMATION ON "AO" SHEETS 4. THE CLIENT ACKNOWLEDGES THE CONSULTANT'S (ARCHITECT) DRAWINGS AND SPECIFICATION, INCLUDING ALL DOCUMENTS ON ELECTRONIC MEDIA AS INSTRUMENTS OF THE CONSULTANTS (ARCHITECT) PROFESSIONAL SERVICE THE CLIENT SHALL NOT REUSE OR MAKE OR PERMIT TO BE MADE ANY MODIFICATION TO THE DRAWINGS AND SPECIFICATIONS WITHOUT THE PRIOR WRITTEN AUTHORIZATION

OF THE CONSULTANT (ARCHITECT). THE CLIENT AGREES TO WAIVE ANY CLAIM AGAINST THE CONSULTANT (ARCHITECT ARISING FROM ANY UNAUTHORIZED TRANSFER, REUSE OF MODIFICATION OF THE DRAWINGS AND SPECIFICATIONS 5. ARCHITECT CANNOT WARRANT THE ACCURACY OF DATA CONTAINED HEREIN. ANY USE OR REUSE OF ORIGINAL OR ALTERED CADD DESIGN MATERIALS BY THE USER OR APPROVAL OF THE ARCHITECT SHALL BE AT THE SOLE RISK OF THE USER, FURTHERMORE, USER AGREES T DEFEND INDEMNIFY AND HOLD ARCHITECT HARMLESS

FROM ALL CLAIMS, INJURIES, DAMAGES, LOSSES EXPENSES, AND ATTORNEY'S FEES ARISING OUT OF THE MODIFICATION OR REUSE OF THESE MATERIALS 6. THESE DRAWINGS AS PART OF THE CONTRACT DOCUMENTS ARE DIAGRAMMATIC AND ARE NOT INTENDED TO DEFINE EXACT QUANTITIE OCATIONS OR CODIFIED REQUIREMENTS. THE DRAWINGS SHALL NO BE SCALED, EXACT STATE AND LOCAL CODE REQUIREMENTS AND OTHER APPLICABLE CODE REQUIREMENTS SHALL BE VERIFIED BY AND ARE THE SOLE RESPONSIBILITY OF THIS CONTRACTOR.

Bid Set

CODES OR ANY DISCREPANCIES FOUND IN THE CONTRACT DOCUMENT

SHALL BE BROUGHT TO THE ATTENTION OF THE PROJECT ARCHITEC


PROJECT DATE 09/06/2017

PROJECT #:


Description ADDENDUM 2 09/18/17

14105

**FOUNDATION DETAILS** 

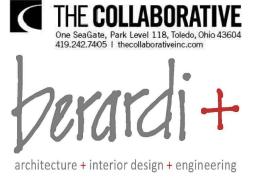

1398 Goodale Blvd. Columbus, Ohio 43212 Phone (614)221-1110) Fax (614)221-0831 www.berardipartners.com

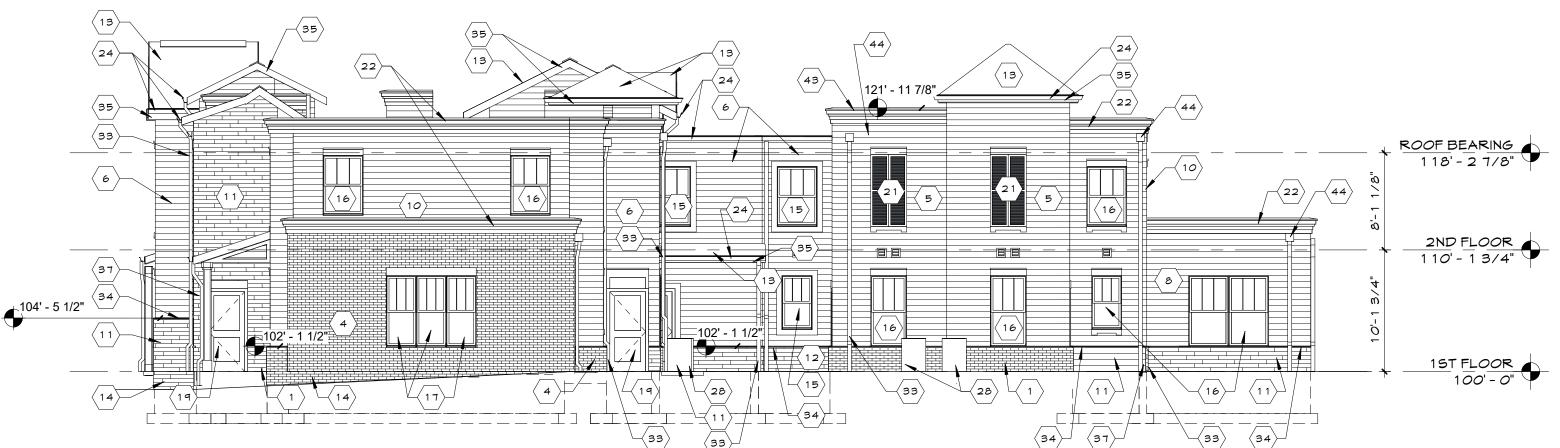

**BUILDING 'A' EAST ELEVATION** 

102' - 1 1/2



general notes: air leakage

IN ACCORDANCE WITH ASHRAE 90.1-04 (5.4.3.1)

BUILDING ENVELOPE SEALING, THE FOLLOWING AREAS OF THE BUILDING ENVELOPE SHALL BE SEALED, CAULKED, GASKETED, OR WEATHER-STRIPPED TO MINIMIZE AIR LEAKAGE: (A) JOINTS AROUND FENESTRATION AND

DOOR FRAMES. (B) JUNCTIONS BETWEEN WALLS AND FOUNDATIONS, BETWEEN WALLS AT BUILDING CORNERS, BETWEEN WALLS AND BETWEEN WALLS AND ROOF OR WALL PANELS. (C) OPENINGS AT PENETRATIONS OF UTILITY SERVICES THROUGH ROOFS, WALLS, AND

(D) SITE-BUILT FENESTRATION AND DOORS. (E) BUILDING ASSEMBLIES USED AS DUCTS OR

(F) JOINTS, SEAMS, AND PENETRATIONS OF VAPOR RETARDERS. DRYWALL TO BE SEALED

SEAL RECESSED CAN LIPS, UTILITY BOXES AND DOOR JAMBS.

FRAMING RETURN AIR CAVITIES WILL BE IN INTERIOR WALLS WITH DRYWALL GLUED ON EIGHT FACES.

TUBS/SHOWERS, STAIRS AND FIREPLACE ENCLOSURES REQUIRE EXTERIOR WALLS TO BE PRE-INSULATED AND BOARDED BEFORE BEING BUILT AGAINST.

OTHER OPENINGS IN THE BUILDING ENVELOPE.

### general notes: building envelope


- OPENINGS SUCH AS DOORS AND WINDOWS (INCLUDING ALL SILL PANNING AS REQUIRED) TO BE FLASHED.
- GRADING TO BE SLOPED AWAY FROM BUILDING/ FOUNDATION (GRADE - SLOPE AWAY GUARANTEED FOR ON (1)
- EXTERIOR WINDOWS TO BE PROVIDED WITH TEMPERED GLAZING. EXTERIOR DOORS AND FRAMES TO BE INSULATED HOLLOW METAL
- DOORS WITH HOLLOW METAL FRAMES. FOOTING TILE (BELOW TOP OF FOOTING DAYLIGHT OR TO INTERIOR
- FOUNDATION INSULATION TO EXTEND TO TOP OF FOOTING
- INSTALL WALL AND CEILING INSULATION AGAINST CONDITIONED SURFACES (FACE STAPLE BATTS).
- ENCLOSE WALL INSULATION ON SIX SIDES PROTECT FROMAIR WASH. CEILING INSULATION TO BE EVEN DEPTH AND TO BE MINIMUM R- 38. SOFFIT CHUTES ARE TO BE FULL CAVITY WITH TABS TO PROTECT EDGE OF PERIMETER INSULATION

## general notes: elevation

- ELEVATION REFERENCES SHOWN ON THESE DRAWINGS ARE USED ONLY AS REFERENCE. SEE CIVIL DRAWINGS FOR ACTUAL FINISH FLOOR ELEVATIONS.
- DOWNSPOUTS SHALL BE AS LOCATED ON FLOOR PLANS. PROVIDE SPECIFIED BOOTS AND RUNS FROM BUILDING AS DETAILED ON CIVIL DRAWINGS. PROVIDE POSITIVE
- DRAINAGE AWAY FROM BUILDING. EXTERIOR FINISH MATERIALS TO BE INSTALLED AS PER THE MANUFACTURER'S
- DIRECTIVES. EXPOSED CONCRETE MASONRY UNITS OR EXPOSED CONCRETE TO BE PARGED
- SEE ROOF PLANS FOR FLASHING AND
- PENETRATION REQUIREMENTS. FINISH COLORS AND TEXTURES NOT
- SPECIFIED TO BE SELECTED BY ARCHITECT. SEE SHEET A 201G FOR PROPOSED EXTERIOR FINISH SCHEDULE

## Exterior Elevation Coded Notes

- 1 BRICK VENEER (COLOR 'A')
- 2 BRICK VENEER (COLOR 'B') 3 BRICK VENEER (COLOR 'C')
- 4 BRICK YENEER (COLOR 'D')
- 5 SIDING (COLOR 'A')
- 6 SIDING (COLOR 'B')
- 7 SIDING (COLOR 'C') 8 SIDING (COLOR 'D')
- 10 SIDING (COLOR 'F')
- 11 ADHERED MANUFACTURED CONCRETE MASONRY VENEER (COLOR 'A')
- 12 ADHERED MANUFACTURED CONCRETE MASONRY VENEER (COLOR 'B')
- 13 ROOFING SHINGLES
- 14 EXPOSED FOUNDATION CONDITION EXTEND EXTERIOR FINISH MATERIAL. COORDINATE WITH FOUNDATION PLAN AND WALL SECTIONS/DETAILS
- 15 VINYL SINGLE HUNG MINDOW MITH 5/4" HARDIE TRIM, 5-1/2" MIDE - SEE WINDOW SCHEDULE
- 16 VINYL SINGLE HUNG WINDOW WITH FYPON HEAD AND SILL TRIM -SEE MINDOM SCHEDULE
- 17 VINYL SINGLE HUNG WINDOW WITH LIMESTONE HEAD AND SILL TRIM - SEE MINDOM SCHEDULE
- 18 VINYL SINGLE CLERESTORY WINDOW SEE WINDOW SCHEDULE 19 INSULATED STEEL DOOR - SEE DOOR SCHEDULE
- 20 18" X 72" DECORATIVE SHUTTERS WITH LIMESTONE HEAD AND SILL TRIM
- 21 18" X 72" DECORATIVE SHUTTERS WITH FYPON HEAD AND SILL
- 22 PRE-MANUFACTURED EPS CORNICE SEE DETAIL
- 23 PRE-MANUFACTURED EPS PARAPET WALL SEE DETAIL
- 24 ALUMINUM GUTTER AND DRIP EDGE TYPICAL
- 26 PRE-MANUFACTURED FYPON GABLE VENT SEE MECHANICAL
- DOCUMENTS 27 PRE-MANUFACTURED, PRE-FINISHED ALUMINUM RAILING
- 28 AIR CONDITIONER CONDENSING UNIT SEE MECHANICAL DOCUMENTS
- 29 CONTINUOUS HIP/RIDGE VENT SEE ROOF PLAN FOR DETAILS
- 30 WOOD FRAME BALCONY SEE WALL SECTIONS 31 WOOD TRELLIS WITH CLEAR CORRUGATED FIBERGLASS
- ROOFING PANELS SEE DETAILS
- 32 DECORATIVE SHUTTER
- 33 ALUMINUM DOWNSPOUT AS LOCATED ON FLOOR PLANS. 34 CONTINUOUS AUTOCLAYED WATERTABLE SILL - SEE DETAIL
- 35 2X ALUMINUM WRAPPED FASCIA TYPICAL, SEE WALL SECTIONS FOR DETAILS
- 36 DECORATIVE TRIM ELEMENT 37 STRUCTURAL COLUMN WITH DECORATIVE WRAP - SEE DETAILS 38 STEP IN ELEVATION FROM FOUNDATION THROUGH ROOF - SEE
- STRUCTURAL DOCUMENTS 39 ROOF VENTS - SEE MECHANICAL DOCUMENTS
- 40 DRYER VENT AND BATHROOM EXHAUST VENTS COORDINATE LOCATIONS WITH MECHANICAL DOCUMENTS 41 ALUMINUM WRAPPED PARAPET CAP - SEE WALL SECTIONS
- 42 CEMENTITOUS SHAKES
- 43 LIMESTONE PARAPET CAP
- 44 ALUMINUM SCUPPER BOX 45 18" X 60" DECORATIVE SHUTTERS WITH FYPON HEAD AND SILL
- 46 18" X 72" DECORATIVE SHUTTERS WITH 5/4 X 5 1/2" HARDIE
- 47 FYPON DOOR HEAD TRIM WITH TRANSOM PANEL
- 48 ENTRY LIGHT FIXTURE TYP.
- 49 ADDRESS MARKER LOCATION NUMERALS PER HARDWARE SCHEDULE; INSTALL ON 1X8 AZEK WHITE TRIM BOARD W/ S.S. SCREMS (2 LOCATIONS/UNIT)
- 50 LIMESTONE HEAD TRIM

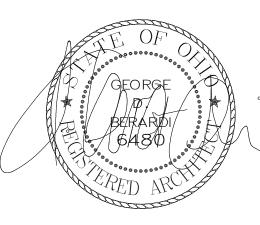

GEORGE D. BERARDI, LICENSE #6480 EXPIRATION DATE: 12/31/2015

LMHA Collingwood Green, Phase III





THE ARRANGEMENTS DEPICTED HEREIN ARE THE SOLE PROPERTY OF BERARDI + PARTNERS, INC., ARCHITECTS AND ENGINEERS, AND MAY NOT BE REPRODUCED WITHOUT ITS WRITTEN PERMISSION

ALL RIGHTS RESERVED

ALL BIDDERS SHALL VISIT THE SITE AND BECOME FAMILIAR W/ THE EXISTING CONDITIONS AND REQUIREMENTS OF THE PROJECT AND SHALL NOTIFY THE ARCHITECT OF ANY ERRORS AND OMISSIONS SUBSEQUENTLY DISCOVERED IN THE CONTRACT DOCUMENTS. 2. THE CONTRACT DOCUMENTS ARE COMPRISED OF THE DRAWINGS AND THE PROJECT MANUAL IN THEIR ENTIRETY. THE INFORMATION IN THESE DOCUMENTS IS DEPENDENT UPON AND COMPLEMENTARY OF EACH OTHER. SEPARATION OF THE CONTRACT DOCUMENTS SHALL NOT BE PERMITTED. IF THE CONTRACTOR CHOOSES TO SEPARATE

3. ADDITIONALLY, SEE GENERAL INFORMATION ON "AO" SHEETS 4. THE CLIENT ACKNOWLEDGES THE CONSULTANT'S (ARCHITECT) DRAWINGS AND SPECIFICATION, INCLUDING AL DOCUMENTS ON ELECTRONIC MEDIA AS INSTRUMENTS OF THE CONSULTANTS (ARCHITECT) PROFESSIONAL SERVICE. THE CLIENT SHALL NOT REUSE OR MAKE OR PERMIT TO BE MADE ANY MODIFICATION TO THE DRAWINGS AND SPECIFICATIONS WITHOUT THE PRIOR WRITTEN AUTHORIZATION OF THE CONSULTANT (ARCHITECT). THE CLIENT AGREES TO WAIVE ANY CLAIM AGAINST THE CONSULTANT (ARCHITECT, ARISING FROM ANY UNAUTHORIZED TRANSFER, REUSE OR MODIFICATION OF THE DRAWINGS AND SPECIFICATIONS.

CONTAINED HEREIN. ANY USE OR REUSE OF ORIGINAL OR ALTERED CADD DESIGN MATERIALS BY THE USER OR OTHER PARTIES WITHOUT THE REVIEW AND WRITTEN RISK OF THE USER, FURTHERMORE, USER AGREES TO DEFEND, INDEMNIFY, AND HOLD ARCHITECT HARMLESS FROM ALL CLAIMS, INJURIES, DAMAGES, LOSSES EXPENSES, AND ATTORNEY'S FEES ARISING OUT OF THE MODIFICATION OR REUSE OF THESE MATERIALS.

6.THESE DRAWINGS AS PART OF THE CONTRACT DOCUMENTS ARE DIAGRAMMATIC AND ARE NOT INTENDED TO DEFINE EXACT QUANTITIES LOCATIONS OR CODIFIED REQUIREMENTS. THE DRAWINGS SHALL NOT BE SCALED. EXACT STATE AND LOCAL CODE REQUIREMENTS AND OTHER APPLICABLE CODE REQUIREMENTS SHALL BE VERIFIED BY AND ARE THE SOLE RESPONSIBILITY OF THIS CONTRACTOR. CODES OR ANY DISCREPANCIES FOUND IN THE CONTRACT DOCUMENTS

Bid Set

SHALL BE BROUGHT TO THE ATTENTION OF THE PROJECT ARCHITECT

PROJECT DATE: 01/26/2017

PROJECT #:

14105

09/18/2017

**BUILDING 'A' EXTERIOR ELEVATIONS** 

A201A

THE COLLABORATIVE
One SeaGate, Park Level 118, Toledo, Ohio 43604

architecture + interior design + engineerinį 1398 Goodale Blvd. Columbus, Ohio 43212

Phone (614)221-1110) Fax (614)221-0831 www.berardipartners.com



15T FLOOR

BUILDING 'A' NORTH **ELEVATION** 

1/8'' = 1'-0''




BUILDING 'A' SOUTH **ELEVATION** 

#### unit general notes:

- SEE SHEET AOO 1 FOR MOUNTING HEIGHTS, SYMBOLS AND ADDITIONAL INFORMATION SEE SHEET A002 FOR WALL AND FLOOR TYPES
- ALL INTERIOR WALL THICKNESSES ARE 3 1/2" (TYPE M5) UNLESS INDICATED OTHERWISE
- 4. SEE STRUCTURAL DRAWINGS FOR ALL SHEAR
- WALL CONDITIONS AND DETAILING SEE INDEXED SHEET FOR CODE REQUIRED
- GRAB BAR BLOCKING COORDINATE ALL SHOWER DIMENSIONS WITH FINAL SELECTION OF MANUFACTURER PRIOR
- TO CONSTRUCTION ALL RATED WALL ASSEMBLIES MUST BE COMPLETE BEHIND ALL SIDES OF SHOWERS
- AND TUBS 8. WASHER/DRYER CLOSET SIZED AND EQUIPPED TO ACCEPT SEPERATE WASHER/ DRYER -CENTERED CONDENSING WASHER/DRYER REQIURED FOR FULL VISITABILITY
- SEE REFLECTED CEILING PLAN/MECHANICAL DRAWINGFS FOR UNITI PLAN SOFFIT LOCATIONS 10. SEE BUILDING FLOOR PLANS (SHEET SERIES A 100'S) FOR COMMON PARTITION WALL TYPE
- DESIGNATIONS 1 1. EXTERIOR DOORS AND FRAMES TO BE INSULATED HOLLOW METAL. DOORS WITH HOLLOW METAL FRAMES. 12. SEE BELOW DIAGRAM FOR DOOR LOCATIONS. CLOSET

DOORS SHOULD BE CENTERED IN OPENING UNLESS

NOTE: 2X6 WALLS INCLUDE BUT ARE NOT LIMITED TO EXTERIOR WALLS, DEMISING WALLS AND PLUMBING WALLS

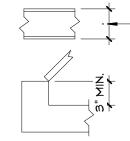

6'-4 7/8"

FINISH DIMENSION

M3330

B30 MITH

FRONT

REGFRIG.

 $\langle A301 \rangle$ 

\A301

 $\overline{A301}$ 

REMOVABLE 30" DROP-IN B21

RANGE

~3" FILLER

10'-2 1/8"

FINISH DIMENSION

3BR FLAT KITCHEN

3BR FLAT KITCHEN

SB36 REMOVABLE B9

FRONT

3BR FLAT KITCHEN

ELEVATION A

3/8" = 1'-0"

6'-4 7/8"

ENERGY

STAR 24" D.M. ELEVATION B

3/8" = 1'-0"

ELEVATION C

3/8" = 1'-0"

\A301

kitchen elevation

M3012 N2130

3/8" = 1'-0"

OTHERWISE NOTED.

INDICATES A 2X4 MALL (3 1/2") UNLESS NOTED OTHERWISE - 3" IS THE MINIMUM DISTANCE FROM A ROUGH FRAMED CORNER TO A

ROUGH FRAMED DOOR JAMB

- THIS SYMBOL IN A DIMENSION STRING

#### general notes

- SEE SHEET A001 FOR MOUNTING HEIGHTS, SYMBOLS, AND
- ADDITIONAL NOTES. SEE DETAILS 1 AND 2 A401 FOR REQUIRED GRAB BAR REINFORCEMENT LOCATION FOR DWELLING UNITS.

GRAB BAR STRENGTH BENDING STRESS IN A GRAB BAR OR A SEAT INDUCED BY THE MAXIMUM BENDING MOMENT FROM THE APPLICATION OF 250 LF-FT (112 Nm) SHALL BE LESS THAN THE ALLOWABLE STRESS FOR THE MATERIAL OF THE GRAB BAR OR SEAT.

SHEAR STRESS INDUCED IN A GRAB BAR OR A SEAT BY THE APPLICATION OF 250 LB-FT (112 Nm) SHALL BE LESS THAN THE ALLOWABLE SHEAR STRESS FOR THE MATERIAL OF THE GRAB BAR OR SEAT. IF THE CONNECTION BETWEEN THE GRAB BAR OR SEAT AND ITS MOUNTING BRACKET OR OTHER SUPPORT IS CONSIDERED TO BE FULLY RESTRAINED, THEN DIRECT AND TORSIONAL SHEAR STRESSES SHALL BE TOTALED FOR THE COMBINED SHEAR STRESS, WHICH SHALL NOT EXCEED THE ALLOWABLE SHEAR STRESS.

SHEAR FORCE INDUCED IN A FASTENER BY A DIRECT TENSION FORCE OF 250 LB-FT (112 Nm) SHALL BE LESS THAN THE ALLOWABLE LATERAL LOAD OF EITHER THE FASTENER OR MOUNTING DEVICE OF THE SUPPORTING STRUCTURE, WHICHEVER IS THE SMALLER ALLOWABLE LOAD.

TENSILE FORCE INDUCED IN A FASTENER BY A DIRECT TENSION FORCE OF 250 LB-FT (112 Nm) PLUS THE MAXIMUM MOMENT FROM THE APPLICATION OF 250 LB-FT (112 Nm) SHALL BE LESS THAN THE ALLOWABLE WITHDRAWL AND THE SUPPORTING STRUCTURE.

GRAB BARS SHALL NOT ROTATEL WITHIN THEIR FITTINGS.

CABINETS NOTED TO HAVE REMOVABLE FRONTS TO INCLUDE REMOVABLE SIDES AND BOTTOM SHELVES..

NOTE:

BLOCKING FOR GRAB BARS NOT REQUIRED AT TUB/SHOWER IF ENCLOSURES ARE FACTORY REINFORCED TO ACCEPT GRAB BARS.

THE GENERAL CONTRACTOR IS RESPONSIBLE FOR THIS COORDINATION.

# 13'-11 7/8" 12'-8 1/2" BEDROOM 3 BEDROOM 1 4'-0 5/8" 7'- 1" 5'-4" 4'-6 5/8"/ 2'-0 3/4'. PORCH 6'-8 3/4" BATHROOM-LIVING ROOM CLOSET 3'-05/8" 57/8" 6'-0" / 8 // 19 // 9 PATIO BEI O OOM 2 9'-7 1/8" 6'-5" 10'-1 1/4" 26'-8 3/8"

#### unit general notes: unit guidelines

- ALL INTERIOR DWELLING UNITS COMPLY WITH THE "FAIR HOUSING ACCESSIBILITY GUIDELINES" (FHAG),
- AND ALL FEDERAL, STATE AND LOCAL ACCESSIBILITY CODES. FIVE PERCENT (5%) OF THE TOTAL NUMBER OF UNITS (4 DWELLING UNITS CONSISTING OF (3) - TWO BEDROOM AND (1) THREEBEDROOM) ARE 'TYPE A' FULLY ACCESSIBLE AS REQUIRED BY CODE. (LABELED HC) AND MUST BE CONSTRUCTED FOR ACCESSIBILITY IN ACCORDANCE WITH THE LOCAL JURISDICTION AND THE PROVISIONS FOR TYPE A UNIT AS DEFINED BY ANSI - A 1 1 7.1. THE REMAINDER OF ALL UNITS MUST BE CONSTRUCTED FOR ACCESSIBILITY IN ACCORDANCE WITH THE LOCAL

JURISDICTION AND THE PROVISIONS FOR TYPE B UNITS AS DEFINED BY ANSI - A 1 1 7.1. ALL DWELLING UNITS MEET AND EXCEED THE MINIMUM REQUIREMENTS FOR "OHFTYPE UNITS (ONE-BEDROOM SQUARE FOOTAGE OF 650 S.F. + / TWO-BEDROOM SQUARE FOOTAGE OF

ALL DWELLING UNITS SHALL BE EQUIPPED WITH THE FOLLOWING APPLIANCES:

-REFRIGERATOR -30" RANGE

- -DISHMASHER -ALL APPLIANCES MEET CLEAR FLOOR SPACE REQUIREMENTS
- ALL DWELLING UNIT BEDROOMS MEET AND EXCEED THE MINIMUM REQUIREMENTS FOR UNIT BEDROOMS (MINIMUM REQUIREMENT OF 7'-0" IN EACH DIRECTION AND MINIMUM OF 100 S.F.). ALL DWELLING UNIT ENTRY DOORS SHALL BE A 36" WIDE SOLID CORE DOOR (NO UNIT HAS A STEP
- ALL DOOR HARDWARE SHALL HAVE A LEVER DESIGN.
- ALL CARPET TO BE LOW (LESS THAN ½" HIGH PILE) DENSITY WITH FIRM PAD NO PAD AT ANSI TYPE
- 'A' DWELLING UNITS. THRESHOLD REQUIREMENTS:
- -EXTERIOR MAXIMUM OF 1/2" BEVEL -INTERIOR MAXIMUM OF 1/4" BEVEL
- ALL INTERIOR DOORS SHALL BE 32" (CLEAR WIDTH) OR GREATER.
- ALL DWELLING UNITS ARE EQUIPPED WITH A MIN. OF ONE (1) FULL BATHROOM. ALL EXPOSED PLUMBING (AT BATHROOMS AND KITCHENS), SUPPLY AND DRAIN/SANITARY LINES,
- TO PROTECT AGAINST SCALDING/BURNS AND BUMPS. ALL TOILETS TO BE 2 ½" ("ADA" COMPLIANT) HIGHER THAN STANDARD TOILETS (17"-19") OR BE
- HEIGHT ADJUSTABLE. 14. ALL INSTALLED GRAB BARS AND REQUIRED BLOCKING (FOR FUTURE INSTALLATION) SHALL MEET
- OR EXCEED THE ABILITY TO SUPPORT 250-300 LBS. BATHROOMS TO MEET OR EXCEED 60" TURNING RADIUS/T-TURN SPACE.
- KITCHENS TO HAVE A FAUCET WITH LEVERED HANDLES. ALL DRAMER PULLS TO HAVE "LOOPED" HANDLES FOR EASY GRIP AND PULL.
- ALL MORK SURFACES TO HAVE TASK LIGHTING (SEE "ELECTRICAL DRAMINGS"). ROCKER TYPE LIGHT SMITCHED THROUGHOUT UNIT
- CARBON MONOXIDE DETECTORS TO BE INSTALLED ON EACH FLOOR OF DWELLING UNIT.
- COMBUSTION EQUIPMENT TO BE VENTED TO EXTERIOR. BATHROOM & KITCHEN TO BE EXHAUSTED TO EXTERIOR
- 23. ALL COUNTERTOPS TO HAVE RADIUSED CORNERS (2"R)

#### unit durability notes:


- CONTRACTOR TO USE LEED FOR HOMES DURABILITY CHECKLIST DURING CONSTRUCTION: DURABILITY ITEMS ARE LISTED BELOW ARE NOT LIMITED TO THESE ITEMS.
- MATER RESISTANT FLOORING AT KITCHENS/BATHROOMS/LAUNDRIES AND ENTRY MAYS.
- INSTALL DRAIN & DRAIN PAN AT WATER HEATER. MASHER BOX TO HAVE SINGLE THROW VALVE.
- CLOTHES DRYER TO BE EXHAUSTED TO EXTERIOR.
- SEAL ALL EXTERNAL CRACK JOINTS, ETC. WITH CAULKING OR PEST=PROOF SCREEN.
- ALL FLOORING IN BATHROOMS AND KITCHENS TO BE RUN WALL-TO-WALL (UNDER ALL REMOVABLE ACABINETS AND APPLIANCES).
- ALL DRYWALL TO BE SEALED. USE NON-PAPER FACED BACKER BOARD AT ALL BATHROOM WALLS, TUB/SHOWER ENCLOSURES
- AND LAUNDRY AREAS INCLUDING CEILINGS.
- SEAL ALL RECESSED CAN LIPS, UTILITY BOXES AND DOOR JAMBS.
- TUBS/SHOWERS, STAIRS AND FIREPLACE ENCLOSURES REQUIRE EXTERIOR WALLS TO BE PRE-INSULATED AND BOARDED PRIOR TO BEING BUILT AGAINST.
- ALL INTERIOR DOORS TO BE FILLIED CORE.
- KEEP ALL STORED MATERIALS DRY ON SITE PROVIDE POSITIVE DRAINAGE AWAY FROM WALLS.
- RAISE PAPER COVERED GYPSUM BOARD 1/2" ABOVE CONCRETE SLAB.
- PRIME AND PAINT ALL EXTERIOR WOOD TRIM ON ALL 6 SIDES. CEMENTITIOUS SIDING TO BE SEALED AND INSTALLED PER MANUFACTURERS INSTRUCTIONS.

#### unit plan coded notes

- 1 (5) 15" DEEP SHELVES
- 2 SOFFIT LOCATION COORDINATE WITH MECHANICAL DRAWINGS
- 3 30" LENGTH MID-HEIGHT SHELF
- 4 42" ALUMINUM RAILING SEE SPECIFICATIONS
- 5 MEDICINE CABINET
- 6 DRYER NOT IN CONTRACT 7 WASHER - NOT IN CONTRACT
- 8 WATER HEATER WITH DRAIN PAN
- 9 AIR HANDLING UNI
- 10 ADJUSTABLE CLOSET SHELF AND ROD
- 11 STAIR
- 12 BATHTUB
- 13 WATER CLOSET 14 ROOF BELOW
- 15 ANSI / ADA COMPLAINT FIBERGLASS SHOWER
- 16 36" GRAB BAR. 17 42" GRAB BAR.
- BELOW CABINET.
- 19 FLOOR DRAIN 20 ELECTRICAL PANEL
- 21 (5) 9" DEEP SHELVES SEE ACCESSORY LOCATION TABLE ON AOO 1 22 PROVIDE 1 HOUR CEILING AND WALL
- ASSEMBLIES AT METER ROOM. SEE ASSEMBLY DETAIL SHEET A002 23 AT TYPICAL UNITS WITHOUT METER ROOM,
- PROVIDE CLOSET SIMILAR TO 3 BEDROOM TOMNHOUSE 24 MECHANICAL DAMPER LOCATION -CONTRACTOR TO COORDINATE ACCESS
- PANEL SIZE AND LOCATION 25 MECHANICAL CHASE. COORDINATE W/ MECH DMGS
- 26 RAISED FLOOR AREA SEE A/A501

#### unit elevation coded notes

- A PLASTIC LAMINATE COUNTERTOP WITH 4" BACKSPLASH AND SIDE-SPLASH (6" BACKSPLASH
- AND SIDE-SPLASH AT HANDICAP DWELLING UNITS) B PENINSULA COUNTERTOP - SEE DETAIL E/A402
- C COUNTERTOP SUPPORTS TO MATCH CABINET FINISH D FINISHED END PANEL
- E BASE TRIM SEE ROOM FINISH SCHEDULE.
- F INSTALL BASE TRIM BEHIND MOVEABLE EQUIPMENT G DOUBLE SINK BOWL WITH LEVER FAUCET, AND GARBAGE DISPOSAL. PROVIDE SCALD AND ABRASION PROTECTION AT SINK BASE CABINETS
- WITH REMOVABLE FRONTS, SIDES AND BOTTOMS -REFER TO DETAIL SHEET A402 H FULL HEIGHT FIRE RESISTANT BACKSPLASH - 3/8"
- FILLER AT OVERHEAD CABINET FOR 30-3/8" BASE CABINET OPENING FOR FREE-STANDING RANGES J RANGE HOOD WITH LIGHT, FAN AND STOVETOP FIRESTOP CANISTERS. FAN TO BE VENTED TO
- OUTSIDE OF BUILDING REFER TO MECHANICAL DOCUMENTS 18 30"X48" MINIMUM CLEAR FLOOR WORK SPACE K SOFFITS ABOVE CABINETS - REFER TO REFLECTED CEILING PLANS AND MECHANICAL DOCUMENTS FOR
  - EXACT LOCATIONS L NO DRAWER / FLUSH INFILL TO MATCH CABINET FRAME

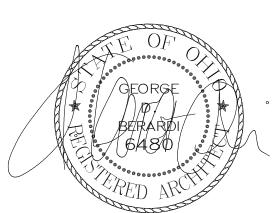

GEORGE D. BERARDI, LICENSE #6480 EXPIRATION DATE: 12/31/2015

LMHA Collingwood Green, Phase III





BERARDI + PARTNERS, INC. ARCHITECTS AND ENGINEERS ALL RIGHTS RESERVED THE ARRANGEMENTS DEPICTED HEREIN ARE THE SOLE PROPERTY OF

BERARDI + PARTNERS, INC., ARCHITECTS AND ENGINEERS,

AND MAY NOT BE REPRODUCED WITHOUT ITS WRITTEN PERMISSION

THE EXISTING CONDITIONS AND REQUIREMENTS OF THE PROJECT AND SHALL NOTIFY THE ARCHITECT OF ANY ERRORS AND OMISSIONS

SUBSEQUENTLY DISCOVERED IN THE CONTRACT DOCUMENTS. 2. THE CONTRACT DOCUMENTS ARE COMPRISED OF THE DRAWINGS AND THE PROJECT MANUAL IN THEIR ENTIRETY. THE INFORMATION IN THESE DOCUMENTS IS DEPENDENT UPON AND COMPLEMENTARY OF EACH OTHER. SEPARATION OF THE CONTRACT DOCUMENTS SHALL

NOT BE PERMITTED. IF THE CONTRACTOR CHOOSES TO SEPARATE THE DOCUMENTS, THEY DO SO AT THEIR OWN RISK AND EXPENSE 3. ADDITIONALLY, SEE GENERAL INFORMATION ON "AO" SHEETS. 4. THE CLIENT ACKNOWLEDGES THE CONSULTANT'S DOCUMENTS ON ELECTRONIC MEDIA AS INSTRUMENTS OF THE CONSULTANTS (ARCHITECT) PROFESSIONAL SERVICE.

THE CLIENT SHALL NOT REUSE OR MAKE OR PERMIT TO BE MADE ANY MODIFICATION TO THE DRAWINGS AND SPECIFICATIONS WITHOUT THE PRIOR WRITTEN AUTHORIZATION OF THE CONSULTANT (ARCHITECT). THE CLIENT AGREES TO WAIVE ANY CLAIM AGAINST THE CONSULTANT (ARCHITECT) ARISING FROM ANY UNAUTHORIZED TRANSFER, REUSE OR MODIFICATION OF THE DRAWINGS AND SPECIFICATIONS. 5. ARCHITECT CANNOT WARRANT THE ACCURACY OF DATA

CONTAINED HEREIN. ANY USE OR REUSE OF ORIGINAL OR ALTERED CADD DESIGN MATERIALS BY THE USER OR OTHER PARTIES WITHOUT THE REVIEW AND WRITTEN RISK OF THE USER. FURTHERMORE, USER AGREES TO DEFEND, INDEMNIFY, AND HOLD ARCHITECT HARMLESS FROM ALL CLAIMS, INJURIES, DAMAGES, LOSSES, EXPENSES, AND ATTORNEY'S FEES ARISING OUT OF THE MODIFICATION OR REUSE OF THESE MATERIALS

6.THESE DRAWINGS AS PART OF THE CONTRACT DOCUMENTS ARE DIAGRAMMATIC AND ARE NOT INTENDED TO DEFINE EXACT QUANTITIES, LOCATIONS OR CODIFIED REQUIREMENTS. THE DRAWINGS SHALL NOT BE SCALED. EXACT STATE AND LOCAL GODE REQUIREMENTS AND OTHER APPLICABLE CODE REQUIREMENTS SHALL BE VERIFIED BY ANI ARE THE SOLE RESPONSIBILITY OF THIS CONTRACTOR. ANY INFORMATION WHICH DIRECTLY CONFLICTS WITH ANY OF THESE CODES OR ANY DISCREPANCIES FOUND IN THE CONTRACT DOCUMENTS SHALL BE BROUGHT TO THE ATTENTION OF THE PROJECT ARCHITECT

Bid Set

PROJECT DATE: 01/26/2017 PROJECT #: 14105

Date 09/06/2017 Bid Set

Addendum 2


09/18/2017


**ENLARGED UNIT PLANS -**3BR FLAT

A301



architecture + interior design + engineerin 1398 Goodale Blvd. Columbus, Ohio 43212 Phone (614)221-1110) Fax (614)221-0831 www.berardipartners.com

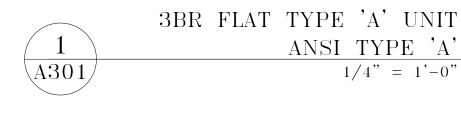

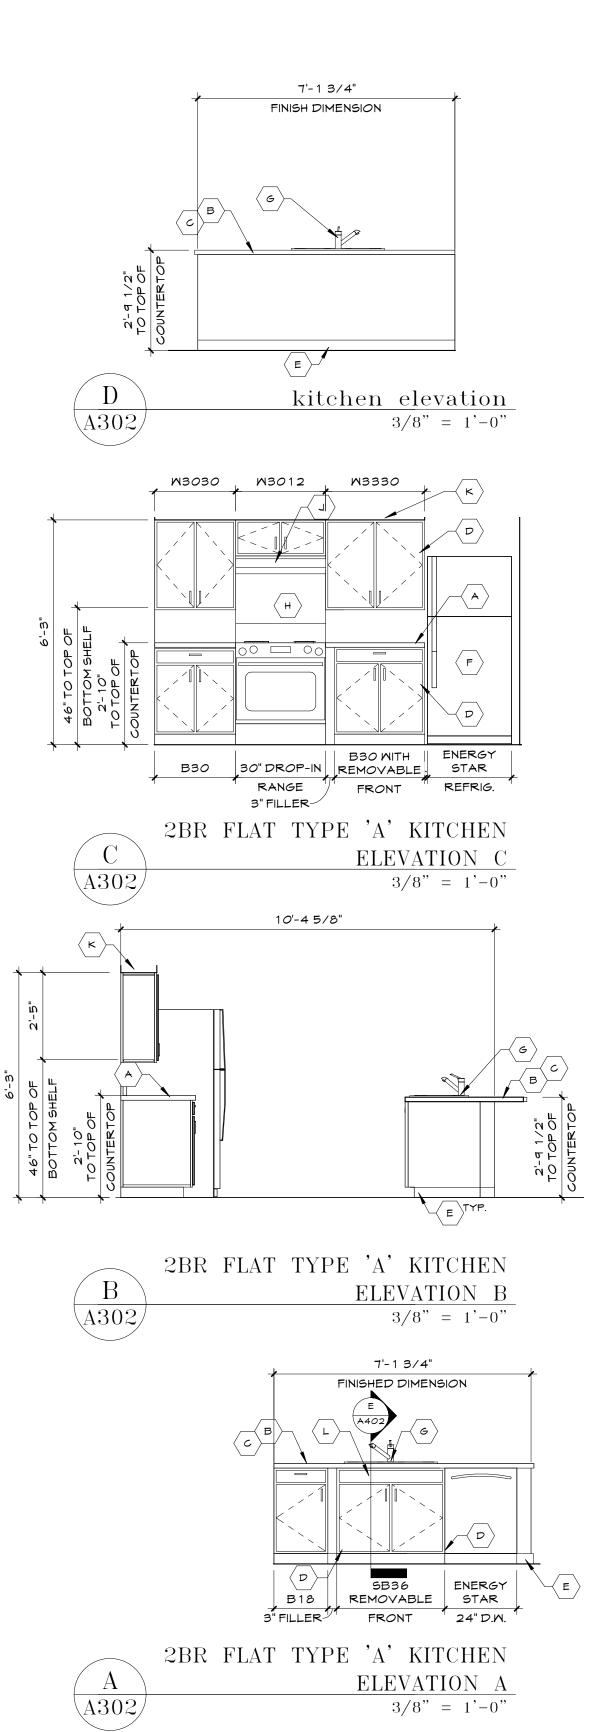


### unit general notes:

- 1. SEE SHEET AOO 1 FOR MOUNTING HEIGHTS, SYMBOLS AND ADDITIONAL INFORMATION
- 2. SEE SHEET A002 FOR WALL AND FLOOR TYPES 3. ALL INTERIOR WALL THICKNESSES ARE 3 1/2" (TYPE M5) UNLESS INDICATED OTHERWISE
- 4. SEE STRUCTURAL DRAWINGS FOR ALL SHEAR WALL CONDITIONS AND DETAILING
- 5. SEE INDEXED SHEET FOR CODE REQUIRED GRAB BAR BLOCKING
- 6. COORDINATE ALL SHOWER DIMENSIONS WITH FINAL SELECTION OF MANUFACTURER PRIOR TO CONSTRUCTION
- 7. ALL RATED WALL ASSEMBLIES MUST BE COMPLETE BEHIND ALL SIDES OF SHOWERS AND TUBS 8. WASHER/DRYER CLOSET SIZED AND EQUIPPED
- TO ACCEPT SEPERATE WASHER/DRYER -CENTERED CONDENSING WASHER/DRYER REQIURED FOR FULL VISITABILITY
- 9. SEE REFLECTED CEILING PLAN/MECHANICAL DRAWINGFS FOR UNITI PLAN SOFFIT LOCATIONS 10. SEE BUILDING FLOOR PLANS (SHEET SERIES A 100'S) FOR COMMON PARTITION WALL TYPE
- DESIGNATIONS 11. EXTERIOR DOORS AND FRAMES TO BE INSULATED HOLLOW METAL. DOORS WITH HOLLOW METAL FRAMES. 12. SEE BELOW DIAGRAM FOR DOOR LOCATIONS. CLOSET

DOORS SHOULD BE CENTERED IN OPENING UNLESS

NOTE: 2X6 WALLS INCLUDE BUT ARE NOT LIMITED TO EXTERIOR WALLS, DEMISING WALLS AND PLUMBING WALLS

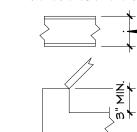

OTHERWISE NOTED.

THIS SYMBOL IN A DIMENSION STRING INDICATES A 2X4 MALL (3 1/2")

UNLESS NOTED OTHERWISE - 3" IS THE MINIMUM DISTANCE FROM A ROUGH FRAMED CORNER TO A ROUGH FRAMED DOOR JAMB

#### general notes

- SEE SHEET A001 FOR MOUNTING HEIGHTS, SYMBOLS, AND ADDITIONAL NOTES.
- SEE DETAILS 1 AND 2 A401 FOR REQUIRED GRAB BAR REINFORCEMENT LOCATION FOR DWELLING UNITS.

GRAB BAR STRENGTH BENDING STRESS IN A GRAB BAR OR A SEAT INDUCED BY THE MAXIMUM BENDING MOMENT FROM THE APPLICATION OF 250 LF-FT (112 Nm) SHALL BE LESS THAN THE ALLOWABLE STRESS FOR THE MATERIAL OF THE GRAB BAR OR SEAT.

SHEAR STRESS INDUCED IN A GRAB BAR OR A SEAT BY THE APPLICATION OF 250 LB-FT (112 Nm) SHALL BE LESS THAN THE ALLOWABLE SHEAR STRESS FOR THE MATERIAL OF THE GRAB BAR OR SEAT. IF THE CONNECTION BETWEEN THE GRAB BAR OR SEAT AND ITS MOUNTING BRACKET OR OTHER SUPPORT IS CONSIDERED TO BE FULLY RESTRAINED, THEN DIRECT AND TORSIONAL SHEAR STRESSES SHALL BE TOTALED FOR THE COMBINED SHEAR STRESS, WHICH SHALL NOT EXCEED THE ALLOWABLE SHEAR STRESS.

SHEAR FORCE INDUCED IN A FASTENER BY A DIRECT TENSION FORCE OF 250 LB-FT (112 Nm) SHALL BE LESS THAN THE ALLOWABLE LATERAL LOAD OF EITHER THE FASTENER OR MOUNTING DEVICE OF THE SUPPORTING STRUCTURE, WHICHEVER IS THE SMALLER ALLOWABLE


TENSILE FORCE INDUCED IN A FASTENER BY A DIRECT TENSION FORCE OF 250 LB-FT (112 Nm) PLUS THE MAXIMUM MOMENT FROM THE APPLICATION OF 250 LB-FT (112 Nm) SHALL BE LESS THAN THE ALLOWABLE WITHDRAWL AND THE SUPPORTING STRUCTURE.

GRAB BARS SHALL NOT ROTATEL WITHIN THEIR FITTINGS.

CABINETS NOTED TO HAVE REMOVABLE FRONTS TO INCLUDE REMOVABLE SIDES AND BOTTOM SHELVES...

BLOCKING FOR GRAB BARS NOT REQUIRED AT TUB/SHOWER IF ENCLOSURES ARE FACTORY REINFORCED TO ACCEPT GRAB BARS.

THE GENERAL CONTRACTOR IS RESPONSIBLE FOR THIS COORDINATION.

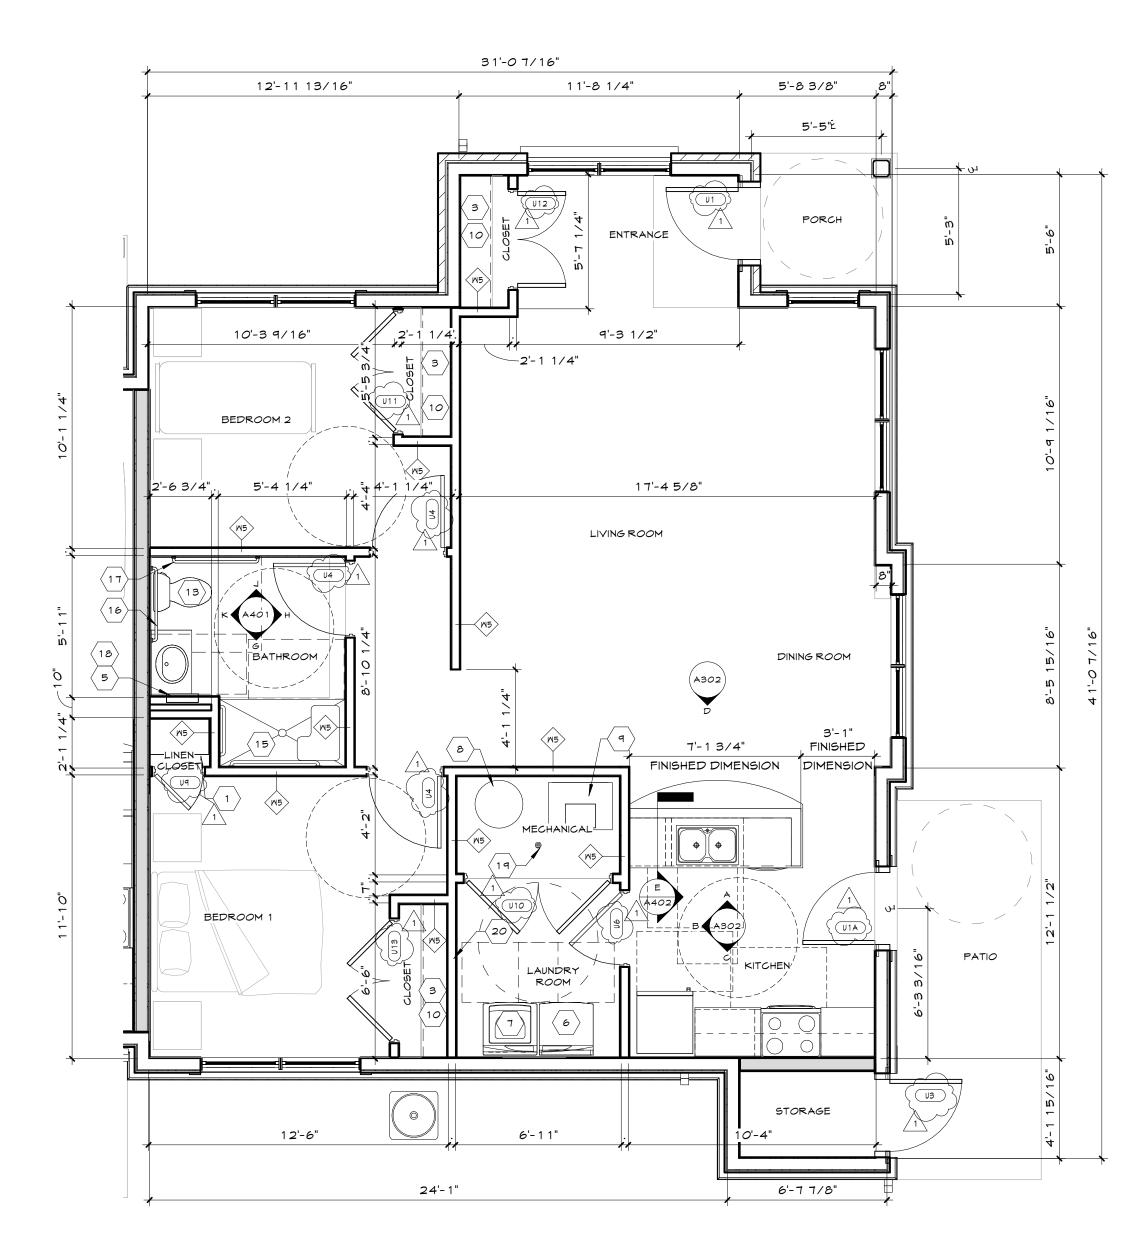

2BR FLAT TYPE 'A' UNIT  $\Lambda 302$ 

ANSI TYPE 'A' 1/4" = 1'-0"

## unit general notes: unit guidelines

- 1. ALL INTERIOR DWELLING UNITS COMPLY WITH THE "FAIR HOUSING ACCESSIBILITY GUIDELINES" (FHAG).
- AND ALL FEDERAL, STATE AND LOCAL ACCESSIBILITY CODES. FIVE PERCENT (5%) OF THE TOTAL NUMBER OF UNITS (4 DWELLING UNITS CONSISTING OF (3) - TWO BEDROOM AND (1) THREEBEDROOM) ARE 'TYPE A' FULLY ACCESSIBLE AS REQUIRED BY CODE. (LABELED HC) AND MUST BE CONSTRUCTED FOR ACCESSIBILITY IN ACCORDANCE WITH THE LOCAL JURISDICTION AND THE PROVISIONS FOR TYPE A UNIT AS DEFINED BY ANSI - A 1 17.1. THE REMAINDER OF ALL UNITS MUST BE CONSTRUCTED FOR ACCESSIBILITY IN ACCORDANCE WITH THE LOCAL

JURISDICTION AND THE PROVISIONS FOR TYPE B UNITS AS DEFINED BY ANSI - A 1 17.1. ALL DWELLING UNITS MEET AND EXCEED THE MINIMUM REQUIREMENTS FOR "OHFTYPE UNITS (ONE-BEDROOM SQUARE FOOTAGE OF 650 S.F. + / TWO-BEDROOM SQUARE FOOTAGE OF

ALL DMELLING UNITS SHALL BE EQUIPPED WITH THE FOLLOWING APPLIANCES: -REFRIGERATOR

-30" RANGE -DISHMASHER

-ALL APPLIANCES MEET CLEAR FLOOR SPACE REQUIREMENTS ALL DWELLING UNIT BEDROOMS MEET AND EXCEED THE MINIMUM REQUIREMENTS FOR UNIT

BEDROOMS (MINIMUM REQUIREMENT OF 7'-0" IN EACH DIRECTION AND MINIMUM OF 100 S.F.). ALL DWELLING UNIT ENTRY DOORS SHALL BE A 36" WIDE SOLID CORE DOOR (NO UNIT HAS A STEP

ALL DOOR HARDWARE SHALL HAVE A LEVER DESIGN.

ALL CARPET TO BE LOW (LESS THAN ½" HIGH PILE) DENSITY WITH FIRM PAD - NO PAD AT ANSI TYPE

'A' DWELLING UNITS. THRESHOLD REQUIREMENTS:

-EXTERIOR MAXIMUM OF 1/2" BEVEL -INTERIOR MAXIMUM OF 1/4" BEVEL

ALL INTERIOR DOORS SHALL BE 32" (CLEAR WIDTH) OR GREATER

ALL DMELLING UNITS ARE EQUIPPED WITH A MIN. OF ONE (1) FULL BATHROOM. ALL EXPOSED PLUMBING (AT BATHROOMS AND KITCHENS), SUPPLY AND DRAIN/SANITARY LINES,

TO PROTECT AGAINST SCALDING/BURNS AND BUMPS. 13. ALL TOILETS TO BE 2 ½" ("ADA" COMPLIANT) HIGHER THAN STANDARD TOILETS (17"-19") OR BE HEIGHT ADJUSTABLE.

ALL INSTALLED GRAB BARS AND REQUIRED BLOCKING (FOR FUTURE INSTALLATION) SHALL MEET OR EXCEED THE ABILITY TO SUPPORT 250-300 LBS.

BATHROOMS TO MEET OR EXCEED 60" TURNING RADIUS/T-TURN SPACE.

KITCHENS TO HAVE A FAUCET WITH LEVERED HANDLES.

ALL DRAMER PULLS TO HAVE "LOOPED" HANDLES FOR EASY GRIP AND PULL ALL WORK SURFACES TO HAVE TASK LIGHTING ( SEE "ELECTRICAL DRAWINGS").

ROCKER TYPE LIGHT SWITCHED THROUGHOUT UNIT

CARBON MONOXIDE DETECTORS TO BE INSTALLED ON EACH FLOOR OF DWELLING UNIT.

COMBUSTION EQUIPMENT TO BE VENTED TO EXTERIOR.

BATHROOM & KITCHEN TO BE EXHAUSTED TO EXTERIOR 23. ALL COUNTERTOPS TO HAVE RADIUSED CORNERS (2"R)

#### unit durability notes:

- CONTRACTOR TO USE LEED FOR HOMES DURABILITY CHECKLIST DURING CONSTRUCTION;
- DURABILITY ITEMS ARE LISTED BELOW ARE NOT LIMITED TO THESE ITEMS. WATER RESISTANT FLOORING AT KITCHENS/BATHROOMS/LAUNDRIES AND ENTRY WAYS.
- INSTALL DRAIN & DRAIN PAN AT WATER HEATER.
- MASHER BOX TO HAVE SINGLE THROW VALVE.
- CLOTHES DRYER TO BE EXHAUSTED TO EXTERIOR. SEAL ALL EXTERNAL CRACK JOINTS, ETC. WITH CAULKING OR PEST=PROOF SCREEN.
  - ALL FLOORING IN BATHROOMS AND KITCHENS TO BE RUN WALL-TO-WALL (UNDER ALL REMOVABLE ACABINETS AND APPLIANCES).

unit elevation coded notes

D FINISHED END PANEL

DOCUMENTS

EXACT LOCATIONS

A PLASTIC LAMINATE COUNTERTOP WITH 4"

E BASE TRIM - SEE ROOM FINISH SCHEDULE.

REFER TO DETAIL SHEET A402

BACKSPLASH AND SIDE-SPLASH (6" BACKSPLASH

AND SIDE-SPLASH AT HANDICAP DWELLING UNITS)

C COUNTERTOP SUPPORTS TO MATCH CABINET FINISH

F INSTALL BASE TRIM BEHIND MOVEABLE EQUIPMENT

ABRASION PROTECTION AT SINK BASE CABINETS

H FULL HEIGHT FIRE RESISTANT BACKSPLASH - 3/8"

J RANGE HOOD WITH LIGHT, FAN AND STOVETOP

L NO DRAWER / FLUSH INFILL TO MATCH CABINET

FIRESTOP CANISTERS. FAN TO BE VENTED TO

OUTSIDE OF BUILDING - REFER TO MECHANICAL

CEILING PLANS AND MECHANICAL DOCUMENTS FOR

WITH REMOVABLE FRONTS, SIDES AND BOTTOMS -

FILLER AT OVERHEAD CABINET FOR 30-3/8" BASE

CABINET OPENING FOR FREE-STANDING RANGES

G DOUBLE SINK BOWL WITH LEVER FAUCET, AND

GARBAGE DISPOSAL. PROVIDE SCALD AND

B PENINSULA COUNTERTOP - SEE DETAIL E/A402


- ALL DRYWALL TO BE SEALED. USE NON-PAPER FACED BACKER BOARD AT ALL BATHROOM WALLS, TUB/SHOWER ENCLOSURES
- AND LAUNDRY AREAS INCLUDING CEILINGS.
- SEAL ALL RECESSED CAN LIPS, UTILITY BOXES AND DOOR JAMBS.
- TUBS/SHOWERS, STAIRS AND FIREPLACE ENCLOSURES REQUIRE EXTERIOR WALLS TO BE PRE-INSULATED AND BOARDED PRIOR TO BEING BUILT AGAINST. ALL INTERIOR DOORS TO BE FILLIED CORE
- KEEP ALL STORED MATERIALS DRY ON SITE 13.
- PROVIDE POSITIVE DRAINAGE AWAY FROM WALLS. RAISE PAPER COVERED GYPSUM BOARD 1/2" ABOVE CONCRETE SLAB.
- PRIME AND PAINT ALL EXTERIOR WOOD TRIM ON ALL 6 SIDES.
- CEMENTITIOUS SIDING TO BE SEALED AND INSTALLED PER MANUFACTURERS INSTRUCTIONS.

## unit plan coded notes

- 1 (5) 15" DEEP SHELVES
- 2 SOFFIT LOCATION COORDINATE WITH MECHANICAL DRAWINGS
- 3 30" LENGTH MID-HEIGHT SHELF
- 4 42" ALUMINUM RAILING SEE SPECIFICATIONS
- 5 MEDICINE CABINET
- 6 DRYER NOT IN CONTRACT 7 WASHER - NOT IN CONTRACT
- 8 WATER HEATER WITH DRAIN PAN
- 9 AIR HANDLING UNI 10 ADJUSTABLE CLOSET SHELF AND ROD
- 11 STAIR
- 12 BATHTUB
- 13 WATER CLOSET
- 14 ROOF BELOW 15 ANSI / ADA COMPLAINT FIBERGLASS SHOWER
- 16 36" GRAB BAR.
- 17 42" GRAB BAR.
- 18 30"X48" MINIMUM CLEAR FLOOR WORK SPACE K SOFFITS ABOVE CABINETS REFER TO REFLECTED
- BELOW CABINET 19 FLOOR DRAIN
- 20 ELECTRICAL PANEL
- 21 (5) 9" DEEP SHELVES SEE ACCESSORY
- LOCATION TABLE ON AOO 1 22 PROVIDE 1 HOUR CEILING AND WALL ASSEMBLIES AT METER ROOM. SEE
- 23 AT TYPICAL UNITS WITHOUT METER ROOM, PROVIDE CLOSET SIMILAR TO 3 BEDROOM TOWNHOUSE
- 24 MECHANICAL DAMPER LOCATION -CONTRACTOR TO COORDINATE ACCESS

ASSEMBLY DETAIL SHEET A002

- PANEL SIZE AND LOCATION 25 MECHANICAL CHASE. COORDINATE W/ MECH
- 26 RAISED FLOOR AREA SEE A/A501

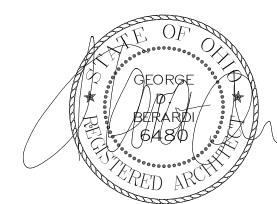

GEORGE D. BERARDI, LICENSE #6480 EXPIRATION DATE: 12/31/2015

LMHA Collingwood



BERARDI + PARTNERS, INC. ARCHITECTS AND ENGINEERS ALL RIGHTS RESERVED

THE ARRANGEMENTS DEPICTED HEREIN ARE THE SOLE PROPERTY OF BERARDI + PARTNERS, INC., ARCHITECTS AND ENGINEERS, AND MAY NOT BE REPRODUCED WITHOUT ITS WRITTEN PERMISSION

ALL BIDDERS SHALL VISIT THE SITE AND BECOME FAMILIAR W/ THE EXISTING CONDITIONS AND REQUIREMENTS OF THE PROJECT AND SHALL NOTIFY THE ARCHITECT OF ANY ERRORS AND OMISSIONS SUBSEQUENTLY DISCOVERED IN THE CONTRACT DOCUMENTS.

THE PROJECT MANUAL IN THEIR ENTIRETY. THE INFORMATION IN THESE DOCUMENTS IS DEPENDENT UPON AND COMPLEMENTARY OF EACH OTHER. SEPARATION OF THE CONTRACT DOCUMENTS SHALL THE DOCUMENTS, THEY DO SO AT THEIR OWN RISK AND EXPENS

3. ADDITIONALLY, SEE GENERAL INFORMATION ON "AO" SHEETS 4. THE CLIENT ACKNOWLEDGES THE CONSULTANT'S DOCUMENTS ON ELECTRONIC MEDIA AS INSTRUMENTS OF THE CONSULTANTS (ARCHITECT) PROFESSIONAL SERVICE THE CLIENT SHALL NOT REUSE OR MAKE OR PERMIT TO BE MADE ANY MODIFICATION TO THE DRAWINGS AND SPECIFICATIONS WITHOUT THE PRIOR WRITTEN AUTHORIZATION OF THE CONSULTANT (ARCHITECT). THE CLIENT AGREES TO WAIVE ANY CLAIM AGAINST THE CONSULTANT (ARCHITECT)

MODIFICATION OF THE DRAWINGS AND SPECIFICATIONS CONTAINED HEREIN. ANY USE OR REUSE OF ORIGINAL OR ALTERED CADD DESIGN MATERIALS BY THE USER OR RISK OF THE USER. FURTHERMORE, USER AGREES TO DEFEND, INDEMNIFY, AND HOLD ARCHITECT HARMLESS FROM ALL CLAIMS, INJURIES, DAMAGES, LOSSES, EXPENSES, AND ATTORNEY'S FEES ARISING OUT OF THE

MODIFICATION OR REUSE OF THESE MATERIALS 6.THESE DRAWINGS AS PART OF THE CONTRACT DOCUMENTS ARE DIAGRAMMATIC AND ARE NOT INTENDED TO DEFINE EXACT QUANTITIES, LOCATIONS OR CODIFIED REQUIREMENTS. THE DRAWINGS SHALL NOT BE SCALED. EXACT STATE AND LOCAL CODE REQUIREMENTS AND OTHE APPLICABLE CODE REQUIREMENTS SHALL BE VERIFIED BY ANI ARE THE SOLE RESPONSIBILITY OF THIS CONTRACTOR. ANY INFORMATION WHICH DIRECTLY CONFLICTS WITH ANY OF THESE

Bid Set

CODES OR ANY DISCREPANCIES FOUND IN THE CONTRACT DOCUMENTS

SHALL BE BROUGHT TO THE ATTENTION OF THE PROJECT ARCHITECT

PROJECT DATE 01/26/2017 PROJECT #: 14105

09/06/2017 Bid Set

Addendum 2

09/18/2017

**ENLARGED UNIT PLANS 2BR FLAT** 


A302




architecture + interior design + engineerin 1398 Goodale Blvd. Columbus, Ohio 43212 Phone (614)221-1110) Fax (614)221-0831 www.berardipartners.com

#### unit elevation coded notes

- A PLASTIC LAMINATE COUNTERTOP WITH 4" BACKSPLASH AND SIDE-SPLASH (6" BACKSPLASH AND SIDE-SPLASH AT HANDICAP DWELLING UNITS)
- B PENINSULA COUNTERTOP SEE DETAIL E/A402 C COUNTERTOP SUPPORTS TO MATCH CABINET FINISH
- D FINISHED END PANEL
- E BASE TRIM SEE ROOM FINISH SCHEDULE.
- F INSTALL BASE TRIM BEHIND MOVEABLE EQUIPMENT G DOUBLE SINK BOWL WITH LEVER FAUCET, AND GARBAGE DISPOSAL. PROVIDE SCALD AND ABRASION PROTECTION AT SINK BASE CABINETS WITH REMOVABLE FRONTS, SIDES AND BOTTOMS -REFER TO DETAIL SHEET A402
- H FULL HEIGHT FIRE RESISTANT BACKSPLASH 3/8" FILLER AT OVERHEAD CABINET FOR 30-3/8" BASE CABINET OPENING FOR FREE-STANDING RANGES J RANGE HOOD WITH LIGHT, FAN AND STOVETOP FIRESTOP CANISTERS. FAN TO BE VENTED TO OUTSIDE OF BUILDING - REFER TO MECHANICAL
- DOCUMENTS K SOFFITS ABOVE CABINETS - REFER TO REFLECTED CEILING PLANS AND MECHANICAL DOCUMENTS FOR EXACT LOCATIONS
- L NO DRAWER / FLUSH INFILL TO MATCH CABINET

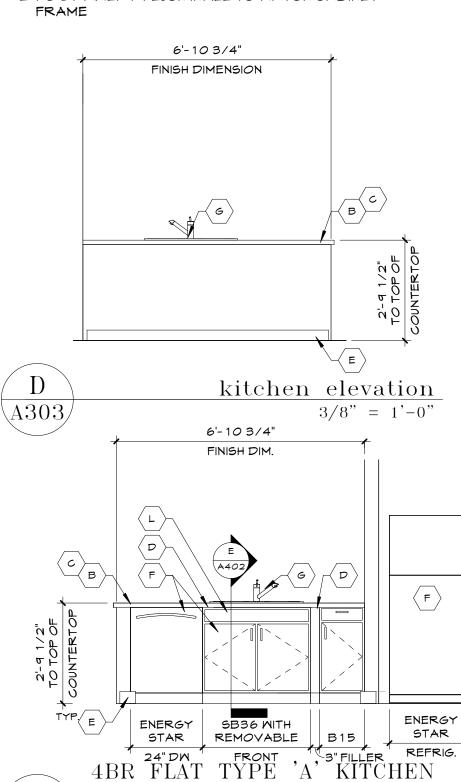

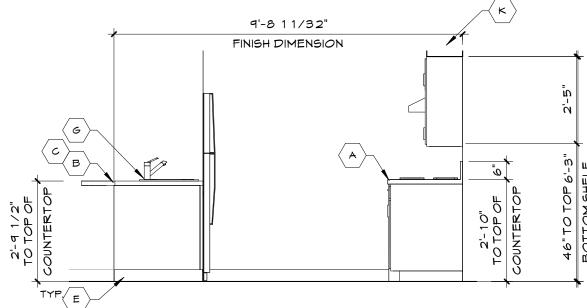


 $\overline{\text{A303}}$ 

 $\langle A303 \rangle$ 

ELEVATION C

3/8" = 1'-0"

3/8" = 1'-0"

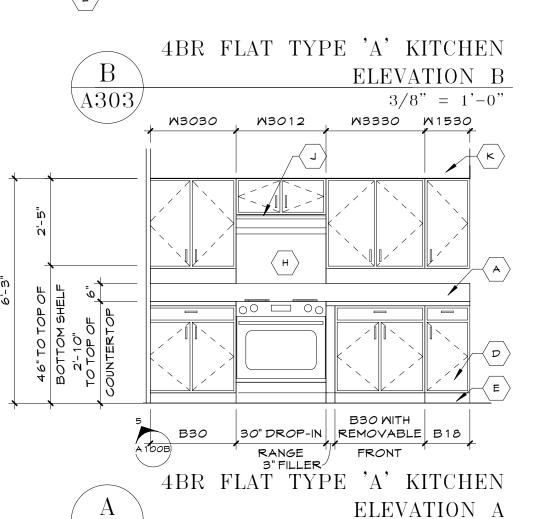

#### unit general notes:

- SEE SHEET AOO 1 FOR MOUNTING HEIGHTS SYMBOLS AND ADDITIONAL INFORMATION
- 2. SEE SHEET A002 FOR WALL AND FLOOR TYPES 3. ALL INTERIOR WALL THICKNESSES ARE 3 1/2"
- (TYPE M5) UNLESS INDICATED OTHERWISE 4. SEE STRUCTURAL DRAWINGS FOR ALL SHEAR
- WALL CONDITIONS AND DETAILING 5. SEE INDEXED SHEET FOR CODE REQUIRED
- GRAB BAR BLOCKING 6. COORDINATE ALL SHOWER DIMENSIONS WITH FINAL SELECTION OF MANUFACTURER PRIOR TO CONSTRUCTION
- 7. ALL RATED WALL ASSEMBLIES MUST BE COMPLETE BEHIND ALL SIDES OF SHOWERS
- 8. WASHER/ DRYER CLOSET SIZED AND EQUIPPED TO ACCEPT SEPERATE WASHER/ DRYER -CENTERED CONDENSING WASHER/DRYER
- REQIURED FOR FULL VISITABILITY 9. SEE REFLECTED CEILING PLAN/MECHANICAL DRAWINGES FOR UNITI PLAN SOFFIT LOCATIONS
- 10. SEE BUILDING FLOOR PLANS (SHEET SERIES A 100'S) FOR COMMON PARTITION WALL TYPE DESIGNATIONS
- 1 1. EXTERIOR DOORS AND FRAMES TO BE INSULATED HOLLOW METAL. DOORS WITH HOLLOW METAL FRAMES.

12. SEE BELOW DIAGRAM FOR DOOR LOCATIONS. CLOSET DOORS SHOULD BE CENTERED IN OPENING UNLESS OTHERWISE NOTED.

NOTE: 2X6 WALLS INCLUDE BUT ARE NOT LIMITED TO

EXTERIOR WALLS, DEMISING WALLS AND PLUMBING WALLS THIS SYMBOL IN A DIMENSION STRING INDICATES A 2X4 MALL (3 1/2") UNLESS NOTED OTHERWISE - 3" IS THE MINIMUM DISTANCE FROM A ROUGH FRAMED CORNER TO A ROUGH FRAMED DOOR JAMB

#### general notes

- SEE SHEET AOO 1 FOR MOUNTING HEIGHTS, SYMBOLS, AND
- ADDITIONAL NOTES. SEE DETAILS 1 AND 2 A401 FOR REQUIRED GRAB BAR REINFORCEMENT LOCATION FOR DWELLING UNITS.

#### GRAB BAR STRENGTH

BENDING STRESS IN A GRAB BAR OR A SEAT INDUCED BY THE MAXIMUM BENDING MOMENT FROM THE APPLICATION OF 250 LF-FT (112 Nm) SHALL BE LESS THAN THE ALLOWABLE STRESS FOR THE MATERIAL OF THE GRAB BAR OR SEAT.

SHEAR STRESS INDUCED IN A GRAB BAR OR A SEAT BY THE APPLICATION OF 250 LB-FT (112 Nm) SHALL BE LESS THAN THE ALLOWABLE SHEAR STRESS FOR THE MATERIAL OF THE GRAB BAR OR SEAT. IF THE CONNECTION BETWEEN THE GRAB BAR OR SEAT AND ITS MOUNTING BRACKET OR OTHER SUPPORT IS CONSIDERED TO BE FULLY RESTRAINED, THEN DIRECT AND TORSIONAL SHEAR STRESSES SHALL BE TOTALED FOR THE COMBINED SHEAR STRESS, WHICH SHALL NOT EXCEED THE ALLOWABLE SHEAR STRESS.

SHEAR FORCE INDUCED IN A FASTENER BY A DIRECT TENSION FORCE OF 250 LB-FT (112 Nm) SHALL BE LESS THAN THE ALLOWABLE LATERAL LOAD OF EITHER THE FASTENER OR MOUNTING DEVICE OF THE SUPPORTING STRUCTURE, WHICHEVER IS THE SMALLER ALLOWABLE


TENSILE FORCE INDUCED IN A FASTENER BY A DIRECT TENSION FORCE OF 250 LB-FT (112 Nm) PLUS THE MAXIMUM MOMENT FROM THE APPLICATION OF 250 LB-FT (112 Nm) SHALL BE LESS THAN THE ALLOWABLE WITHDRAWL AND THE SUPPORTING STRUCTURE.

GRAB BARS SHALL NOT ROTATEL WITHIN THEIR FITTINGS.

CABINETS NOTED TO HAVE REMOVABLE FRONTS TO INCLUDE REMOVABLE SIDES AND BOTTOM SHELVES...

BLOCKING FOR GRAB BARS NOT REQUIRED AT TUB/SHOWER IF ENCLOSURES ARE FACTORY REINFORCED TO ACCEPT GRAB BARS.

THE GENERAL CONTRACTOR IS RESPONSIBLE FOR THIS COORDINATION.

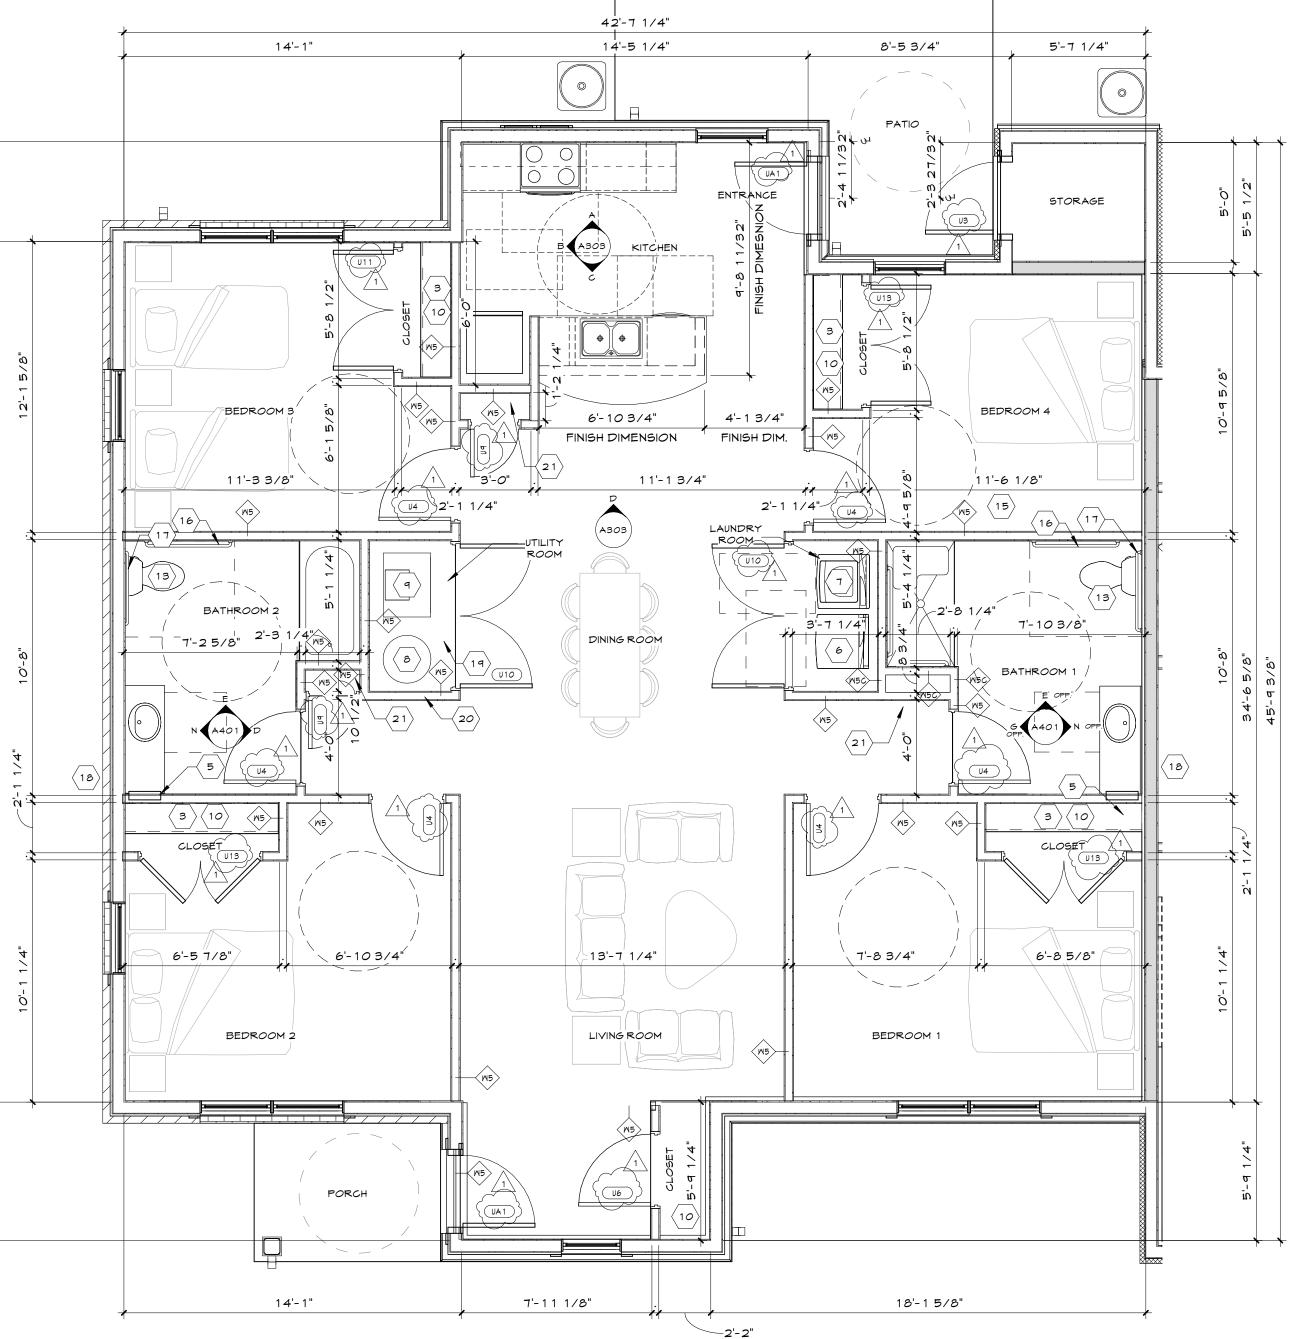

#### unit general notes: unit guidelines


- ALL INTERIOR DWELLING UNITS COMPLY WITH THE "FAIR HOUSING ACCESSIBILITY GUIDELINES" (FHAG),
- AND ALL FEDERAL, STATE AND LOCAL ACCESSIBILITY CODES. FIVE PERCENT (5%) OF THE TOTAL NUMBER OF UNITS (4 DWELLING UNITS CONSISTING OF (3) - TWO BEDROOM AND (1) THREEBEDROOM) ARE 'TYPE A' FULLY ACCESSIBLE AS REQUIRED BY CODE. (LABELED HC) AND MUST BE CONSTRUCTED FOR ACCESSIBILITY IN ACCORDANCE WITH THE LOCAL JURISDICTION AND THE PROVISIONS FOR TYPE A UNIT AS DEFINED BY ANSI - A 1 17.1. THE REMAINDER OF ALL UNITS MUST BE CONSTRUCTED FOR ACCESSIBILITY IN ACCORDANCE WITH THE LOCAL JURISDICTION AND THE PROVISIONS FOR TYPE B UNITS AS DEFINED BY ANSI - A 1 17.1.
- ALL DWELLING UNITS MEET AND EXCEED THE MINIMUM REQUIREMENTS FOR "OHFTYPE UNITS (ONE-BEDROOM SQUARE FOOTAGE OF 650 S.F. + / TWO-BEDROOM SQUARE FOOTAGE OF
- ALL DWELLING UNITS SHALL BE EQUIPPED WITH THE FOLLOWING APPLIANCES:
- -REFRIGERATOR -30" RANGE
- -DISHMASHER -ALL APPLIANCES MEET CLEAR FLOOR SPACE REQUIREMENTS
- ALL DWELLING UNIT BEDROOMS MEET AND EXCEED THE MINIMUM REQUIREMENTS FOR UNIT BEDROOMS (MINIMUM REQUIREMENT OF 7'-0" IN EACH DIRECTION AND MINIMUM OF 100 S.F.).
- ALL DWELLING UNIT ENTRY DOORS SHALL BE A 36" WIDE SOLID CORE DOOR (NO UNIT HAS A STEP
- ALL DOOR HARDWARE SHALL HAVE A LEVER DESIGN. ALL CARPET TO BE LOW (LESS THAN ½" HIGH PILE) DENSITY WITH FIRM PAD - NO PAD AT ANSI TYPE
- 'A' DMELLING UNITS.
- THRESHOLD REQUIREMENTS: -EXTERIOR MAXIMUM OF 1/2" BEVEL
- -INTERIOR MAXIMUM OF 14" BEVEL
- ALL INTERIOR DOORS SHALL BE 32" (CLEAR WIDTH) OR GREATER.
- ALL DWELLING UNITS ARE EQUIPPED WITH A MIN. OF ONE (1) FULL BATHROOM ALL EXPOSED PLUMBING (AT BATHROOMS AND KITCHENS), SUPPLY AND DRAIN/SANITARY LINES,
- TO PROTECT AGAINST SCALDING/BURNS AND BUMPS. 13. ALL TOILETS TO BE 2 ½" ("ADA" COMPLIANT) HIGHER THAN STANDARD TOILETS (17"-19") OR BE
- ALL INSTALLED GRAB BARS AND REQUIRED BLOCKING (FOR FUTURE INSTALLATION) SHALL MEET OR EXCEED THE ABILITY TO SUPPORT 250-300 LBS.
- BATHROOMS TO MEET OR EXCEED 60" TURNING RADIUS/T-TURN SPACE.
- KITCHENS TO HAVE A FAUCET WITH LEVERED HANDLES. ALL DRAWER PULLS TO HAVE "LOOPED" HANDLES FOR EASY GRIP AND PULL.
- ALL WORK SURFACES TO HAVE TASK LIGHTING ( SEE "ELECTRICAL DRAWINGS").
- ROCKER TYPE LIGHT SWITCHED THROUGHOUT UNIT
- CARBON MONOXIDE DETECTORS TO BE INSTALLED ON EACH FLOOR OF DWELLING UNIT.
- COMBUSTION EQUIPMENT TO BE VENTED TO EXTERIOR.
- BATHROOM & KITCHEN TO BE EXHAUSTED TO EXTERIOR ALL COUNTERTOPS TO HAVE RADIUSED CORNERS (2"R)

#### unit durability notes:

- CONTRACTOR TO USE LEED FOR HOMES DURABILITY CHECKLIST DURING CONSTRUCTION;
- DURABILITY ITEMS ARE LISTED BELOW ARE NOT LIMITED TO THESE ITEMS.
- MATER RESISTANT FLOORING AT KITCHENS/BATHROOMS/LAUNDRIES AND ENTRY WAYS. INSTALL DRAIN & DRAIN PAN AT WATER HEATER.
- MASHER BOX TO HAVE SINGLE THROW VALVE.
- CLOTHES DRYER TO BE EXHAUSTED TO EXTERIOR.
- SEAL ALL EXTERNAL CRACK JOINTS, ETC. WITH CAULKING OR PEST=PROOF SCREEN.
- ALL FLOORING IN BATHROOMS AND KITCHENS TO BE RUN WALL-TO-WALL (UNDER ALL REMOVABLE ACABINETS AND APPLIANCES).
- ALL DRYWALL TO BE SEALED. USE NON-PAPER FACED BACKER BOARD AT ALL BATHROOM WALLS, TUB/SHOWER ENCLOSURES
- AND LAUNDRY AREAS INCLUDING CEILINGS.
- SEAL ALL RECESSED CAN LIPS, UTILITY BOXES AND DOOR JAMBS.
- TUBS/SHOWERS, STAIRS AND FIREPLACE ENCLOSURES REQUIRE EXTERIOR WALLS TO BE PRE-
- INSULATED AND BOARDED PRIOR TO BEING BUILT AGAINST. ALL INTERIOR DOORS TO BE FILLIED CORE.
- KEEP ALL STORED MATERIALS DRY ON SITE.
- PROVIDE POSITIVE DRAINAGE AWAY FROM WALLS.
- RAISE PAPER COVERED GYPSUM BOARD 1/2" ABOVE CONCRETE SLAB. PRIME AND PAINT ALL EXTERIOR WOOD TRIM ON ALL 6 SIDES.
- 17. CEMENTITIOUS SIDING TO BE SEALED AND INSTALLED PER MANUFACTURERS INSTRUCTIONS.

#### unit plan coded notes

- 1 (5) 15" DEEP SHELVES
- 2 SOFFIT LOCATION COORDINATE WITH
- MECHANICAL DRAWINGS
- 3 30" LENGTH MID-HEIGHT SHELF 4 42" ALUMINUM RAILING SEE SPECIFICATIONS
- 5 MEDICINE CABINET
- 6 DRYER NOT IN CONTRACT
- 7 WASHER NOT IN CONTRACT
- 8 WATER HEATER WITH DRAIN PAN 9 AIR HANDLING UNI
- 10 ADJUSTABLE CLOSET SHELF AND ROD
- 11 STAIR
- 12 BATHTUB
- 13 WATER CLOSET
- 14 ROOF BELOW 15 ANSI / ADA COMPLAINT FIBERGLASS SHOWER
- 16 36" GRAB BAR. 17 42" GRAB BAR.
- 18 30"x48" MINIMUM CLEAR FLOOR WORK SPACE
- BELOW CABINET
- 19 FLOOR DRAIN
- 20 ELECTRICAL PANEL
- 21 (5) 9" DEEP SHELVES SEE ACCESSORY
- LOCATION TABLE ON AOO 1 22 PROVIDE 1 HOUR CEILING AND WALL
- ASSEMBLIES AT METER ROOM. SEE ASSEMBLY DETAIL SHEET A002
- 23 AT TYPICAL UNITS WITHOUT METER ROOM, PROVIDE CLOSET SIMILAR TO 3 BEDROOM
- TOMNHOUSE
- 24 MECHANICAL DAMPER LOCATION -CONTRACTOR TO COORDINATE ACCESS
- PANEL SIZE AND LOCATION 25 MECHANICAL CHASE. COORDINATE M/ MECH
- 26 RAISED FLOOR AREA SEE A/A501

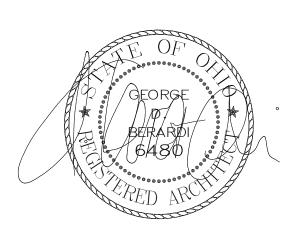

GEORGE D. BERARDI, LICENSE #6480 EXPIRATION DATE: 12/31/2015

Collingwood Green, Phase III





BERARDI + PARTNERS, INC. ARCHITECTS AND ENGINEERS ALL RIGHTS RESERVED THE ARRANGEMENTS DEPICTED HEREIN ARE THE SOLE PROPERTY OF

BERARDI + PARTNERS, INC., ARCHITECTS AND ENGINEERS, AND MAY NOT BE REPRODUCED WITHOUT ITS WRITTEN PERMISSION

ALL BIDDERS SHALL VISIT THE SITE AND BECOME FAMILIAR W/ THE EXISTING CONDITIONS AND REQUIREMENTS OF THE PROJECT AND SHALL NOTIFY THE ARCHITECT OF ANY ERRORS AND OMISSIONS SUBSEQUENTLY DISCOVERED IN THE CONTRACT DOCUMENTS.

THE PROJECT MANUAL IN THEIR ENTIRETY. THE INFORMATION IN THESE DOCUMENTS IS DEPENDENT UPON AND COMPLEMENTARY OF EACH OTHER. SEPARATION OF THE CONTRACT DOCUMENTS SHALL

THE DOCUMENTS, THEY DO SO AT THEIR OWN RISK AND EXPENS

3. ADDITIONALLY, SEE GENERAL INFORMATION ON "AO" SHEETS 4. THE CLIENT ACKNOWLEDGES THE CONSULTANT'S DOCUMENTS ON ELECTRONIC MEDIA AS INSTRUMENTS OF THE CONSULTANTS (ARCHITECT) PROFESSIONAL SERVICE. THE CLIENT SHALL NOT REUSE OR MAKE OR PERMIT TO BE MADE ANY MODIFICATION TO THE DRAWINGS AND SPECIFICATIONS WITHOUT THE PRIOR WRITTEN AUTHORIZATION OF THE CONSULTANT (ARCHITECT). THE CLIENT AGREES TO WAIVE ANY CLAIM AGAINST THE CONSULTANT (ARCHITECT

MODIFICATION OF THE DRAWINGS AND SPECIFICATIONS CONTAINED HEREIN. ANY USE OR REUSE OF ORIGINAL OR ALTERED CADD DESIGN MATERIALS BY THE USER OR OTHER PARTIES WITHOUT THE REVIEW AND WRITTEN RISK OF THE USER. FURTHERMORE, USER AGREES TO DEFEND, INDEMNIFY, AND HOLD ARCHITECT HARMLESS FROM ALL CLAIMS, INJURIES, DAMAGES, LOSSES, EXPENSES, AND ATTORNEY'S FEES ARISING OUT OF THE

6.THESE DRAWINGS AS PART OF THE CONTRACT DOCUMENTS ARE DIAGRAMMATIC AND ARE NOT INTENDED TO DEFINE EXACT QUANTITIES, LOCATIONS OR CODIFIED REQUIREMENTS. THE DRAWINGS SHALL NOT BE SCALED. EXACT STATE AND LOCAL CODE REQUIREMENTS AND OTHE APPLICABLE CODE REQUIREMENTS SHALL BE VERIFIED BY ANI ARE THE SOLE RESPONSIBILITY OF THIS CONTRACTOR. ANY INFORMATION WHICH DIRECTLY CONFLICTS WITH ANY OF THESE CODES OR ANY DISCREPANCIES FOUND IN THE CONTRACT DOCUMENTS

MODIFICATION OR REUSE OF THESE MATERIALS

**Bid Set** 

SHALL BE BROUGHT TO THE ATTENTION OF THE PROJECT ARCHITECT.

PROJECT DATE: 01/26/2017 14105 PROJECT #:

09/06/2017 09/18/2017 Addendum 2

**ENLARGED UNIT PLANS 4BR FLAT** 

A303



architecture + interior design + engineerin 1398 Goodale Blvd. Columbus, Ohio 43212 Phone (614)221-1110) Fax (614)221-0831 www.berardipartners.com

ANSI TYPE 'A' 1/4" = 1'-0"

 $\langle A303 \rangle$ 

4BR FLAT TYPE 'A' UNIT

# unit elevation coded notes

FINISH DIMENSION

FINISH DIMENSION

SB36 REMOVABLE DB9 3"FILLER

M3018

1 1'-3"

FINISH DIMENSION

24" D.W. DB12 30" RANGE

M3630

kitchen elevation

3/8" = 1'-0'

M4230

kitchen elevation

B18 STAR

kitchen elevation

3/8" = 1'-0"

3/8" = 1'-0"

\A304

\A304

M2730

В

 $\A304$ 

 $\sqrt{A304}$ 

F

kitchen elevation

- A PLASTIC LAMINATE COUNTERTOP WITH 4" BACKSPLASH AND SIDE-SPLASH (6" BACKSPLASH AND SIDE-SPLASH AT HANDICAP DWELLING UNITS) B PENINSULA COUNTERTOP - SEE DETAIL E/A402
- C COUNTERTOP SUPPORTS TO MATCH CABINET FINISH
- D FINISHED END PANEL
- E BASE TRIM SEE ROOM FINISH SCHEDULE. F INSTALL BASE TRIM BEHIND MOVEABLE EQUIPMENT G DOUBLE SINK BOWL WITH LEVER FAUCET, AND GARBAGE DISPOSAL. PROVIDE SCALD AND
- ABRASION PROTECTION AT SINK BASE CABINETS WITH REMOVABLE FRONTS, SIDES AND BOTTOMS -REFER TO DETAIL SHEET A402 H FULL HEIGHT FIRE RESISTANT BACKSPLASH - 3/8" FILLER AT OVERHEAD CABINET FOR 30-3/8" BASE
- CABINET OPENING FOR FREE-STANDING RANGES J RANGE HOOD WITH LIGHT, FAN AND STOVETOP FIRESTOP CANISTERS. FAN TO BE VENTED TO OUTSIDE OF BUILDING - REFER TO MECHANICAL DOCUMENTS
- K SOFFITS ABOVE CABINETS REFER TO REFLECTED CEILING PLANS AND MECHANICAL DOCUMENTS FOR EXACT LOCATIONS
- L NO DRAWER / FLUSH INFILL TO MATCH CABINET FRAME

#### unit plan coded notes

- 1 (5) 15" DEEP SHELVES 2 SOFFIT LOCATION - COORDINATE WITH
- MECHANICAL DRAWINGS 3 30" LENGTH MID-HEIGHT SHELF
- 4 42" ALUMINUM RAILING SEE SPECIFICATIONS
- 6 DRYER NOT IN CONTRACT 7 WASHER - NOT IN CONTRACT 8 MATER HEATER WITH DRAIN PAN

5 MEDICINE CABINET

- 9 AIR HANDLING UNI 10 ADJUSTABLE CLOSET SHELF AND ROD
- 11 STAIR 12 BATHTUB
- 13 WATER CLOSET
- 14 ROOF BELOW 15 ANSI / ADA COMPLAINT FIBERGLASS SHOWER
- 16 36" GRAB BAR. 17 42" GRAB BAR.
- 18 30"x48" MINIMUM CLEAR FLOOR WORK SPACE
- BELOW CABINET.
- 19 FLOOR DRAIN 20 ELECTRICAL PANEL
- 21 (5) 9" DEEP SHELVES SEE ACCESSORY LOCATION TABLE ON AOO 1
- 22 PROVIDE 1 HOUR CEILING AND WALL ASSEMBLIES AT METER ROOM. SEE ASSEMBLY DETAIL SHEET A002
- 23 AT TYPICAL UNITS WITHOUT METER ROOM, PROVIDE CLOSET SIMILAR TO 3 BEDROOM TOWNHOUSE
- 24 MECHANICAL DAMPER LOCATION -CONTRACTOR TO COORDINATE ACCESS PANEL SIZE AND LOCATION 25 MECHANICAL CHASE. COORDINATE W/ MECH
- 26 RAISED FLOOR AREA SEE A/A501

#### general notes

- SEE SHEET A001 FOR MOUNTING HEIGHTS, SYMBOLS, AND ADDITIONAL NOTES.
- SEE DETAILS 1 AND 2 A401 FOR REQUIRED GRAB BAR REINFORCEMENT LOCATION FOR DWELLING UNITS.

#### GRAB BAR STRENGTH

BENDING STRESS IN A GRAB BAR OR A SEAT INDUCED BY THE MAXIMUM BENDING MOMENT FROM THE APPLICATION OF 250 LF-FT (112 Nm) SHALL BE LESS THAN THE ALLOWABLE STRESS FOR THE MATERIAL OF THE GRAB BAR OR SEAT.

#### SHEAR STRESS INDUCED IN A GRAB BAR OR A SEAT BY THE APPLICATION OF 250 LB-FT (112 Nm) SHALL BE LESS THAN THE ALLOMABLE SHEAR STRESS FOR THE MATERIAL OF THE GRAB BAR OR SEAT. IF THE CONNECTION BETWEEN THE GRAB BAR OR SEAT AND ITS MOUNTING BRACKET OR OTHER SUPPORT IS CONSIDERED TO BE FULLY RESTRAINED, THEN DIRECT AND TORSIONAL SHEAR STRESSES SHALL BE TOTALED FOR THE COMBINED SHEAR STRESS, WHICH SHALL NOT EXCEED THE ALLOWABLE SHEAR STRESS.

SHEAR FORCE INDUCED IN A FASTENER BY A DIRECT TENSION FORCE OF 250 LB-FT (112 Nm) SHALL BE LESS THAN THE ALLOWABLE LATERAL LOAD OF EITHER THE FASTENER OR MOUNTING DEVICE OF THE SUPPORTING STRUCTURE, WHICHEVER IS THE SMALLER ALLOWABLE

TENSILE FORCE INDUCED IN A FASTENER BY A DIRECT TENSION FORCE OF 250 LB-FT (112 Nm) PLUS THE MAXIMUM MOMENT FROM THE APPLICATION OF 250 LB-FT (112 Nm) SHALL BE LESS THAN THE ALLOWABLE WITHDRAWL AND THE SUPPORTING STRUCTURE.

GRAB BARS SHALL NOT ROTATEL WITHIN THEIR FITTINGS.

CABINETS NOTED TO HAVE REMOVABLE FRONTS TO INCLUDE REMOVABLE SIDES AND BOTTOM SHELVES...

#### BLOCKING FOR GRAB BARS NOT REQUIRED AT TUB/SHOWER IF ENCLOSURES ARE FACTORY REINFORCED TO ACCEPT GRAB BARS.

15'-6 1/4"

6'-5"

THE GENERAL CONTRACTOR IS RESPONSIBLE FOR THIS COORDINATION.

9'-1 1/4"

2'-2 1/4"

(U4)

BATH

METER ROOM/ 2

## unit general notes: unit guidelines

- ALL INTERIOR DWELLING UNITS COMPLY WITH THE "FAIR HOUSING ACCESSIBILITY GUIDELINES" (FHAG)
- AND ALL FEDERAL, STATE AND LOCAL ACCESSIBILITY CODES. FIVE PERCENT (5%) OF THE TOTAL NUMBER OF UNITS (4 DWELLING UNITS CONSISTING OF (3) - TWO BEDROOM AND (1) THREEBEDROOM) ARE 'TYPE A' FULLY ACCESSIBLE AS REQUIRED BY CODE. (LABELED HC) AND MUST BE CONSTRUCTED FOR ACCESSIBILITY IN ACCORDANCE WITH THE LOCAL JURISDICTION AND THE PROVISIONS FOR TYPE A UNIT AS DEFINED BY ANSI - A 1 17.1. THE REMAINDER OF ALL UNITS MUST BE CONSTRUCTED FOR ACCESSIBILITY IN ACCORDANCE WITH THE LOCAL

JURISDICTION AND THE PROVISIONS FOR TYPE BUNITS AS DEFINED BY ANSI - A 1 1 7.1. ALL DWELLING UNITS MEET AND EXCEED THE MINIMUM REQUIREMENTS FOR "OHFTYPE UNITS (ONE-BEDROOM SQUARE FOOTAGE OF 650 S.F. + / TWO-BEDROOM SQUARE FOOTAGE OF

- 850 S.F. +). ALL DWELLING UNITS SHALL BE EQUIPPED WITH THE FOLLOWING APPLIANCES:
- -REFRIGERATOR -30" RANGE
- -DISHMASHER -ALL APPLIANCES MEET CLEAR FLOOR SPACE REQUIREMENTS ALL DWELLING UNIT BEDROOMS MEET AND EXCEED THE MINIMUM REQUIREMENTS FOR UNIT
- BEDROOMS (MINIMUM REQUIREMENT OF 7'-0" IN EACH DIRECTION AND MINIMUM OF 100 S.F.). ALL DWELLING UNIT ENTRY DOORS SHALL BE A 36" WIDE SOLID CORE DOOR (NO UNIT HAS A STEP UP/DOMN).
- ALL DOOR HARDWARE SHALL HAVE A LEVER DESIGN. ALL CARPET TO BE LOW (LESS THAN ½" HIGH PILE) DENSITY WITH FIRM PAD - NO PAD AT ANSI TYPE
- 'A' DMELLING UNITS.
- THRESHOLD REQUIREMENTS: -EXTERIOR MAXIMUM OF 1/2" BEVEL
- -INTERIOR MAXIMUM OF 14" BEVEL ALL INTERIOR DOORS SHALL BE 32" (CLEAR WIDTH) OR GREATER
- ALL DWELLING UNITS ARE EQUIPPED WITH A MIN. OF ONE (1) FULL BATHROOM.
- ALL EXPOSED PLUMBING (AT BATHROOMS AND KITCHENS), SUPPLY AND DRAIN/SANITARY LINES, TO PROTECT AGAINST SCALDING/BURNS AND BUMPS.
- ALL TOILETS TO BE 2 ½" ("ADA" COMPLIANT) HIGHER THAN STANDARD TOILETS (17"-19") OR BE HEIGHT ADJUSTABLE.
- ALL INSTALLED GRAB BARS AND REQUIRED BLOCKING (FOR FUTURE INSTALLATION) SHALL MEET
- OR EXCEED THE ABILITY TO SUPPORT 250-300 LBS. BATHROOMS TO MEET OR EXCEED 60" TURNING RADIUS/T-TURN SPACE.
- KITCHENS TO HAVE A FAUCET WITH LEVERED HANDLES. ALL DRAMER PULLS TO HAVE "LOOPED" HANDLES FOR EASY GRIP AND PULL.
- ALL MORK SURFACES TO HAVE TASK LIGHTING (SEE "ELECTRICAL DRAMINGS"). ROCKER TYPE LIGHT SWITCHED THROUGHOUT UNIT
- CARBON MONOXIDE DETECTORS TO BE INSTALLED ON EACH FLOOR OF DWELLING UNIT.
- COMBUSTION EQUIPMENT TO BE VENTED TO EXTERIOR. 21 BATHROOM & KITCHEN TO BE EXHAUSTED TO EXTERIOR
- 23. ALL COUNTERTOPS TO HAVE RADIUSED CORNERS (2"R)


#### unit durability notes:

- CONTRACTOR TO USE LEED FOR HOMES DURABILITY CHECKLIST DURING CONSTRUCTION; DURABILITY ITEMS ARE LISTED BELOW ARE NOT LIMITED TO THESE ITEMS.
- WATER RESISTANT FLOORING AT KITCHENS/BATHROOMS/LAUNDRIES AND ENTRY WAYS. INSTALL DRAIN & DRAIN PAN AT WATER HEATER.
- MASHER BOX TO HAVE SINGLE THROW VALVE.
- CLOTHES DRYER TO BE EXHAUSTED TO EXTERIOR. SEAL ALL EXTERNAL CRACK JOINTS, ETC. WITH CAULKING OR PEST=PROOF SCREEN.
- ALL FLOORING IN BATHROOMS AND KITCHENS TO BE RUN WALL-TO-WALL (UNDER ALL REMOVABLE ACABINETS AND APPLIANCES).
- ALL DRYWALL TO BE SEALED. USE NON-PAPER FACED BACKER BOARD AT ALL BATHROOM WALLS, TUB/SHOWER ENCLOSURES
- AND LAUNDRY AREAS INCLUDING CEILINGS.
- SEAL ALL RECESSED CAN LIPS, UTILITY BOXES AND DOOR JAMBS.
- TUBS/SHOWERS, STAIRS AND FIREPLACE ENCLOSURES REQUIRE EXTERIOR WALLS TO BE PRE-INSULATED AND BOARDED PRIOR TO BEING BUILT AGAINST.
- ALL INTERIOR DOORS TO BE FILLIED CORE. KEEP ALL STORED MATERIALS DRY ON SITE 13.
- PROVIDE POSITIVE DRAINAGE AWAY FROM WALLS.
- RAISE PAPER COVERED GYPSUM BOARD 1/2" ABOVE CONCRETE SLAB. PRIME AND PAINT ALL EXTERIOR WOOD TRIM ON ALL 6 SIDES.
- CEMENTITIOUS SIDING TO BE SEALED AND INSTALLED PER MANUFACTURERS INSTRUCTIONS.

#### unit general notes:

- 1. SEE SHEET AOO 1 FOR MOUNTING HEIGHTS.
- SYMBOLS AND ADDITIONAL INFORMATION 2. SEE SHEET A002 FOR WALL AND FLOOR TYPES
- 3. ALL INTERIOR WALL THICKNESSES ARE 3 1/2" (TYPE M5) UNLESS INDICATED OTHERWISE
- 4. SEE STRUCTURAL DRAWINGS FOR ALL SHEAR
- WALL CONDITIONS AND DETAILING
- 5. SEE INDEXED SHEET FOR CODE REQUIRED GRAB BAR BLOCKING
- 6. COORDINATE ALL SHOWER DIMENSIONS WITH FINAL SELECTION OF MANUFACTURER PRIOR
- TO CONSTRUCTION
- 7. ALL RATED WALL ASSEMBLIES MUST BE COMPLETE BEHIND ALL SIDES OF SHOWERS
- AND TUBS 8. WASHER/ DRYER CLOSET SIZED AND EQUIPPED
- TO ACCEPT SEPERATE WASHER/ DRYER -
- CENTERED CONDENSING WASHER/DRYER REQIURED FOR FULL VISITABILITY
- 9. SEE REFLECTED CEILING PLAN/MECHANICAL
- DRAWINGES FOR UNITI PLAN SOFFIT LOCATIONS 10. SEE BUILDING FLOOR PLANS (SHEET SERIES
- A 100'S) FOR COMMON PARTITION WALL TYPE
- DESIGNATIONS 1 1. EXTERIOR DOORS AND FRAMES TO BE INSULATED HOLLOW METAL. DOORS WITH HOLLOW METAL FRAMES.
- 12. SEE BELOW DIAGRAM FOR DOOR LOCATIONS. CLOSET DOORS SHOULD BE CENTERED IN OPENING UNLESS OTHERWISE NOTED.

NOTE: 2X6 WALLS INCLUDE BUT ARE NOT LIMITED TO EXTERIOR WALLS, DEMISING WALLS AND PLUMBING WALLS

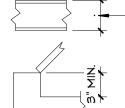

THIS SYMBOL IN A DIMENSION STRING INDICATES A 2X4 MALL (3 1/2")

UNLESS NOTED OTHERWISE - 3" IS THE MINIMUM DISTANCE FROM A ROUGH FRAMED CORNER TO A ROUGH FRAMED DOOR JAMB

LMHA Collingwood Green, Phase III

GEORGE D. BERARDI, LICENSE #6480

EXPIRATION DATE: 12/31/2015



BERARDI + PARTNERS, INC. ARCHITECTS AND ENGINEERS ALL RIGHTS RESERVED THE ARRANGEMENTS DEPICTED HEREIN ARE THE SOLE PROPERTY OF

AND MAY NOT BE REPRODUCED WITHOUT ITS WRITTEN PERMISSION ALL BIDDERS SHALL VISIT THE SITE AND BECOME FAMILIAR W/ THE EXISTING CONDITIONS AND REQUIREMENTS OF THE PROJECT

AND SHALL NOTIFY THE ARCHITECT OF ANY ERRORS AND OMISSIONS SUBSEQUENTLY DISCOVERED IN THE CONTRACT DOCUMENTS. 2. THE CONTRACT DOCUMENTS ARE COMPRISED OF THE DRAWINGS AND THE PROJECT MANUAL IN THEIR ENTIRETY. THE INFORMATION IN THESE DOCUMENTS IS DEPENDENT UPON AND COMPLEMENTARY OF EACH OTHER. SEPARATION OF THE CONTRACT DOCUMENTS SHALL

BERARDI + PARTNERS, INC., ARCHITECTS AND ENGINEERS,

OT BE PERMITTED. IF THE CONTRACTOR CHOOSES TO SEPARATE THE DOCUMENTS, THEY DO SO AT THEIR OWN RISK AND EXPENS 3. ADDITIONALLY, SEE GENERAL INFORMATION ON "AO" SHEETS.

4. THE CLIENT ACKNOWLEDGES THE CONSULTANT'S DOCUMENTS ON ELECTRONIC MEDIA AS INSTRUMENTS OF THE CONSULTANTS (ARCHITECT) PROFESSIONAL SERVICE. THE CLIENT SHALL NOT REUSE OR MAKE OR PERMIT TO BE MADE ANY MODIFICATION TO THE DRAWINGS AND SPECIFICATIONS WITHOUT THE PRIOR WRITTEN AUTHORIZATION OF THE CONSULTANT (ARCHITECT). THE CLIENT AGREES TO WAIVE ANY CLAIM AGAINST THE CONSULTANT (ARCHITECT)

5. ARCHITECT CANNOT WARRANT THE ACCURACY OF DATA CONTAINED HEREIN. ANY USE OR REUSE OF ORIGINAL OR ALTERED CADD DESIGN MATERIALS BY THE USER OR OTHER PARTIES WITHOUT THE REVIEW AND WRITTEN RISK OF THE USER. FURTHERMORE, USER AGREES TO DEFEND, INDEMNIFY, AND HOLD ARCHITECT HARMLESS FROM ALL CLAIMS, INJURIES, DAMAGES, LOSSES, EXPENSES, AND ATTORNEY'S FEES ARISING OUT OF THE

MODIFICATION OF THE DRAWINGS AND SPECIFICATIONS

MODIFICATION OR REUSE OF THESE MATERIALS 6.THESE DRAWINGS AS PART OF THE CONTRACT DOCUMENTS ARE DIAGRAMMATIC AND ARE NOT INTENDED TO DEFINE EXACT QUANTITIES, LOCATIONS OR CODIFIED REQUIREMENTS. THE DRAWINGS SHALL NOT BE SCALED. EXACT STATE AND LOCAL GODE REQUIREMENTS AND OTHE APPLICABLE CODE REQUIREMENTS SHALL BE VERIFIED BY ANI ARE THE SOLE RESPONSIBILITY OF THIS CONTRACTOR.

ANY INFORMATION WHICH DIRECTLY CONFLICTS WITH ANY OF THESE

CODES OR ANY DISCREPANCIES FOUND IN THE CONTRACT DOCUMENTS

SHALL BE BROUGHT TO THE ATTENTION OF THE PROJECT ARCHITECT.

**Bid Set** 

PROJECT DATE: 01/26/2017 PROJECT #:

14105

09/18/2017


09/06/2017


Addendum 2


**ENLARGED UNIT PLANS** 2BR T.H.




architecture + interior design + engineerin 1398 Goodale Blvd. Columbus. Ohio 43212 Phone (614)221-1110) Fax (614)221-0831 www.berardipartners.com

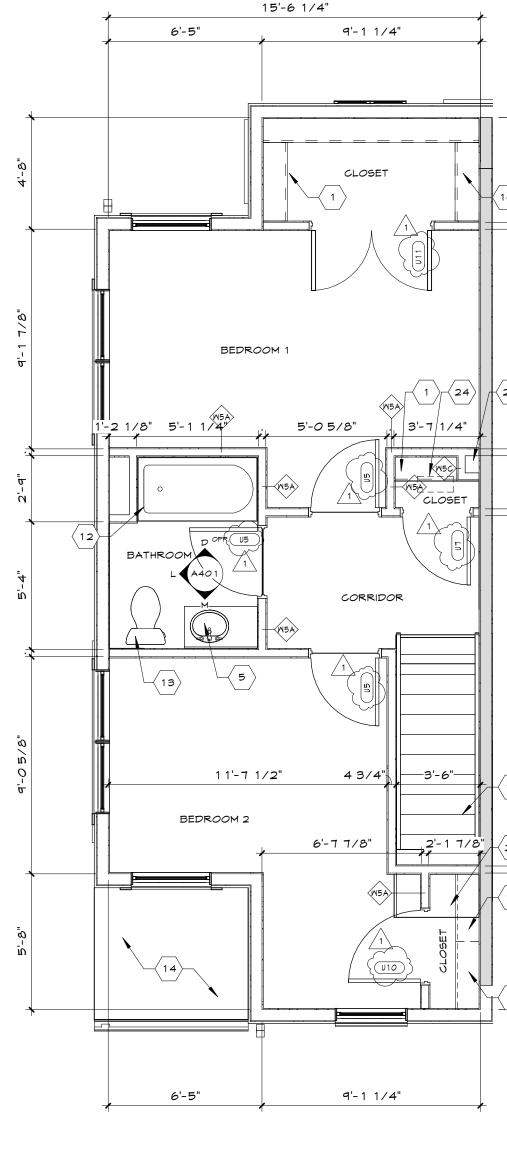

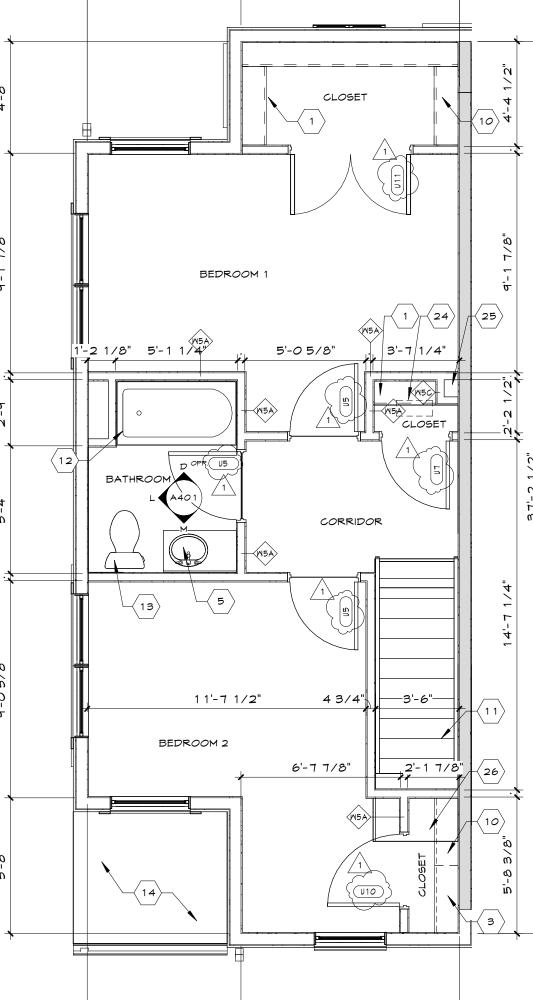

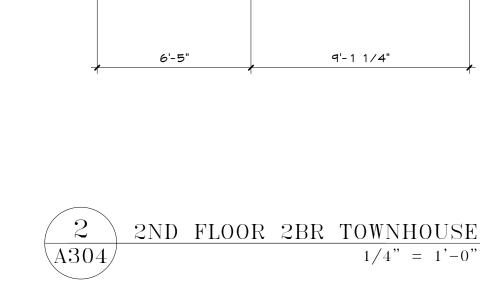

1/4" = 1'-0'

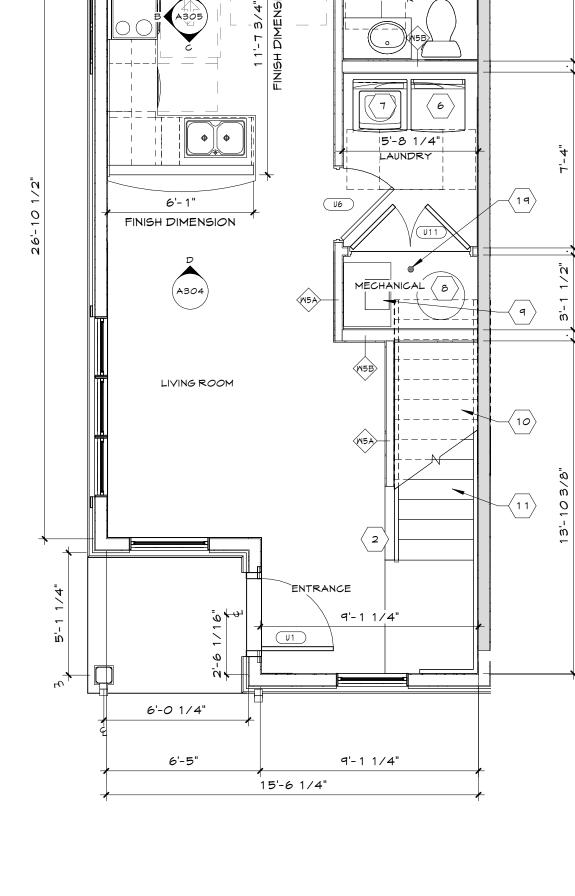



#### general notes

- SEE SHEET A001 FOR MOUNTING HEIGHTS, SYMBOLS, AND ADDITIONAL NOTES.
- SEE DETAILS 1 AND 2 A401 FOR REQUIRED GRAB BAR REINFORCEMENT LOCATION FOR DWELLING UNITS.

#### GRAB BAR STRENGTH

BENDING STRESS IN A GRAB BAR OR A SEAT INDUCED BY THE MAXIMUM BENDING MOMENT FROM THE APPLICATION OF 250 LF-FT (112 Nm) SHALL BE LESS THAN THE ALLOWABLE STRESS FOR THE MATERIAL OF THE GRAB BAR OR SEAT.

SHEAR STRESS INDUCED IN A GRAB BAR OR A SEAT BY THE APPLICATION OF 250 LB-FT (112 Nm) SHALL BE LESS THAN THE ALLOWABLE SHEAR STRESS FOR THE MATERIAL OF THE GRAB BAR OR SEAT. IF THE CONNECTION BETWEEN THE GRAB BAR OR SEAT AND ITS MOUNTING BRACKET OR OTHER SUPPORT IS CONSIDERED TO BE FULLY RESTRAINED, THEN DIRECT AND TORSIONAL SHEAR STRESSES SHALL BE TOTALED FOR THE COMBINED SHEAR STRESS, WHICH SHALL NOT EXCEED THE ALLOWABLE SHEAR STRESS.

SHEAR FORCE INDUCED IN A FASTENER BY A DIRECT TENSION FORCE OF 250 LB-FT (112 Nm) SHALL BE LESS THAN THE ALLOMABLE LATERAL LOAD OF EITHER THE FASTENER OR MOUNTING DEVICE OF THE SUPPORTING STRUCTURE, WHICHEVER IS THE SMALLER ALLOWABLE

TENSILE FORCE INDUCED IN A FASTENER BY A DIRECT TENSION FORCE OF 250 LB-FT (112 Nm) PLUS THE MAXIMUM MOMENT FROM THE APPLICATION OF 250 LB-FT (112 Nm) SHALL BE LESS THAN THE ALLOWABLE WITHDRAWL AND THE SUPPORTING STRUCTURE.

#### GRAB BARS SHALL NOT ROTATEL WITHIN THEIR FITTINGS.

CABINETS NOTED TO HAVE REMOVABLE FRONTS TO INCLUDE REMOVABLE SIDES AND BOTTOM SHELVES..

BLOCKING FOR GRAB BARS NOT REQUIRED AT TUB/SHOWER IF ENCLOSURES ARE FACTORY REINFORCED TO ACCEPT GRAB BARS.

THE GENERAL CONTRACTOR IS RESPONSIBLE FOR THIS COORDINATION.

#### unit elevation coded notes

- A PLASTIC LAMINATE COUNTERTOP WITH 4" BACKSPLASH AND SIDE-SPLASH (6" BACKSPLASH AND SIDE-SPLASH AT HANDICAP DWELLING UNITS)
- B PENINSULA COUNTERTOP SEE DETAIL E/A402 C COUNTERTOP SUPPORTS TO MATCH CABINET FINISH
- D FINISHED END PANEL
- E BASE TRIM SEE ROOM FINISH SCHEDULE.
- F INSTALL BASE TRIM BEHIND MOVEABLE EQUIPMENT G DOUBLE SINK BOWL WITH LEVER FAUCET, AND GARBAGE DISPOSAL. PROVIDE SCALD AND
- ABRASION PROTECTION AT SINK BASE CABINETS WITH REMOVABLE FRONTS, SIDES AND BOTTOMS -REFER TO DETAIL SHEET A402 H FULL HEIGHT FIRE RESISTANT BACKSPLASH - 3/8"
- FILLER AT OVERHEAD CABINET FOR 30-3/8" BASE CABINET OPENING FOR FREE-STANDING RANGES J RANGE HOOD WITH LIGHT, FAN AND STOVETOP FIRESTOP CANISTERS. FAN TO BE VENTED TO
- DOCUMENTS K SOFFITS ABOVE CABINETS - REFER TO REFLECTED CEILING PLANS AND MECHANICAL DOCUMENTS FOR EXACT LOCATIONS

OUTSIDE OF BUILDING - REFER TO MECHANICAL


L NO DRAWER / FLUSH INFILL TO MATCH CABINET


#### unit plan coded notes


- 1 (5) 15" DEEP SHELVES
- 2 SOFFIT LOCATION COORDINATE WITH MECHANICAL DRAWINGS
- 3 30" LENGTH MID-HEIGHT SHELF
- 4 42" ALUMINUM RAILING SEE SPECIFICATIONS 5 MEDICINE CABINET
- 6 DRYER NOT IN CONTRACT
- 7 WASHER NOT IN CONTRACT
- 8 WATER HEATER WITH DRAIN PAN 9 AIR HANDLING UNI
- 10 ADJUSTABLE CLOSET SHELF AND ROD
- 11 STAIR
- 12 BATHTUB 13 WATER CLOSET
- 14 ROOF BELOW 15 ANSI / ADA COMPLAINT FIBERGLASS SHOWER
- 16 36" GRAB BAR. 17 42" GRAB BAR.
- 18 30"x48" MINIMUM CLEAR FLOOR WORK SPACE
- BELOW CABINET.
- 19 FLOOR DRAIN 20 ELECTRICAL PANEL
- LOCATION TABLE ON AOO 1 22 PROVIDE 1 HOUR CEILING AND WALL ASSEMBLIES AT METER ROOM. SEE


21 (5) 9" DEEP SHELVES - SEE ACCESSORY

- ASSEMBLY DETAIL SHEET A002 23 AT TYPICAL UNITS WITHOUT METER ROOM, PROVIDE CLOSET SIMILAR TO 3 BEDROOM
- TOWNHOUSE 24 MECHANICAL DAMPER LOCATION -CONTRACTOR TO COORDINATE ACCESS
- PANEL SIZE AND LOCATION 25 MECHANICAL CHASE. COORDINATE M/ MECH
- 26 RAISED FLOOR AREA SEE A/A501

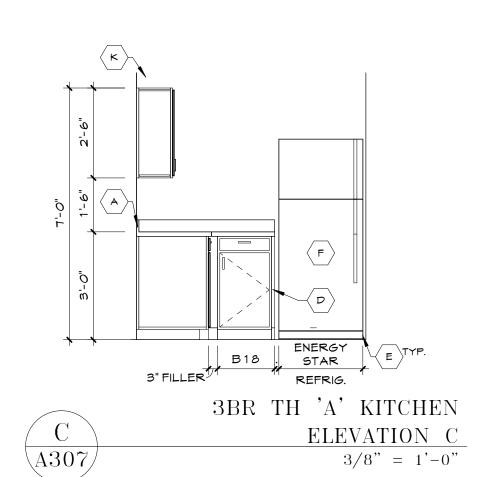

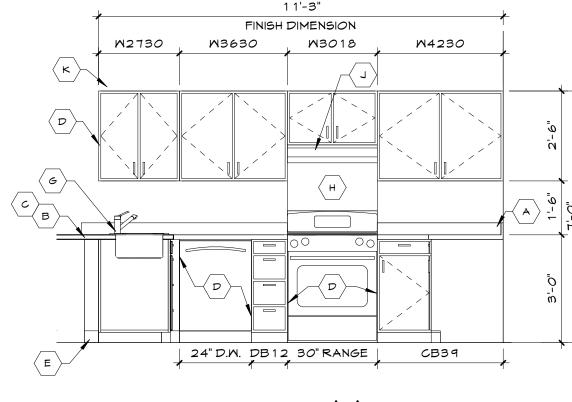

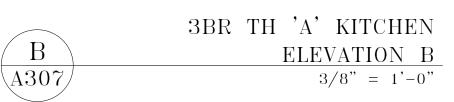

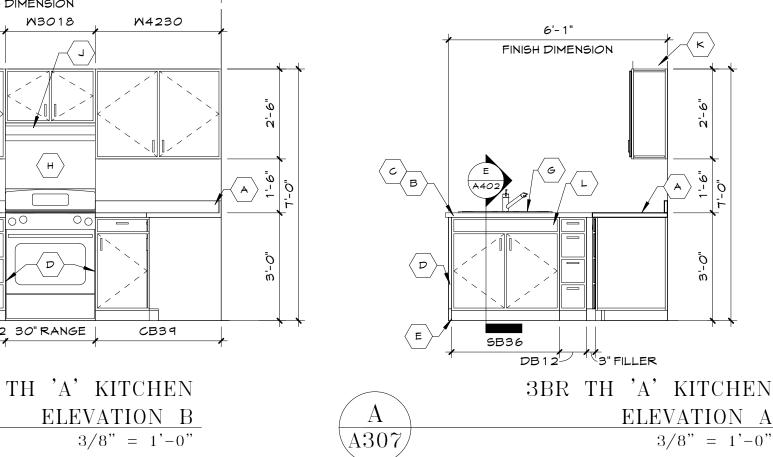

D

 $\setminus A307$ 

6'-1"

FINISH DIMENSION

15'-6 1/4"

LIVING ROOM

ENTRY

MECHANICAL

5'-8 7/8"

LAUNDRY

6'-5"

\_6'-2 13/32"<sup>\_</sup>

6'-1"

FINISH DIMENSION

KITCHEN


4'-8"

ВС

3BR TH 'A' KITCHEN


ELEVATION D

3/8" = 1'-0"

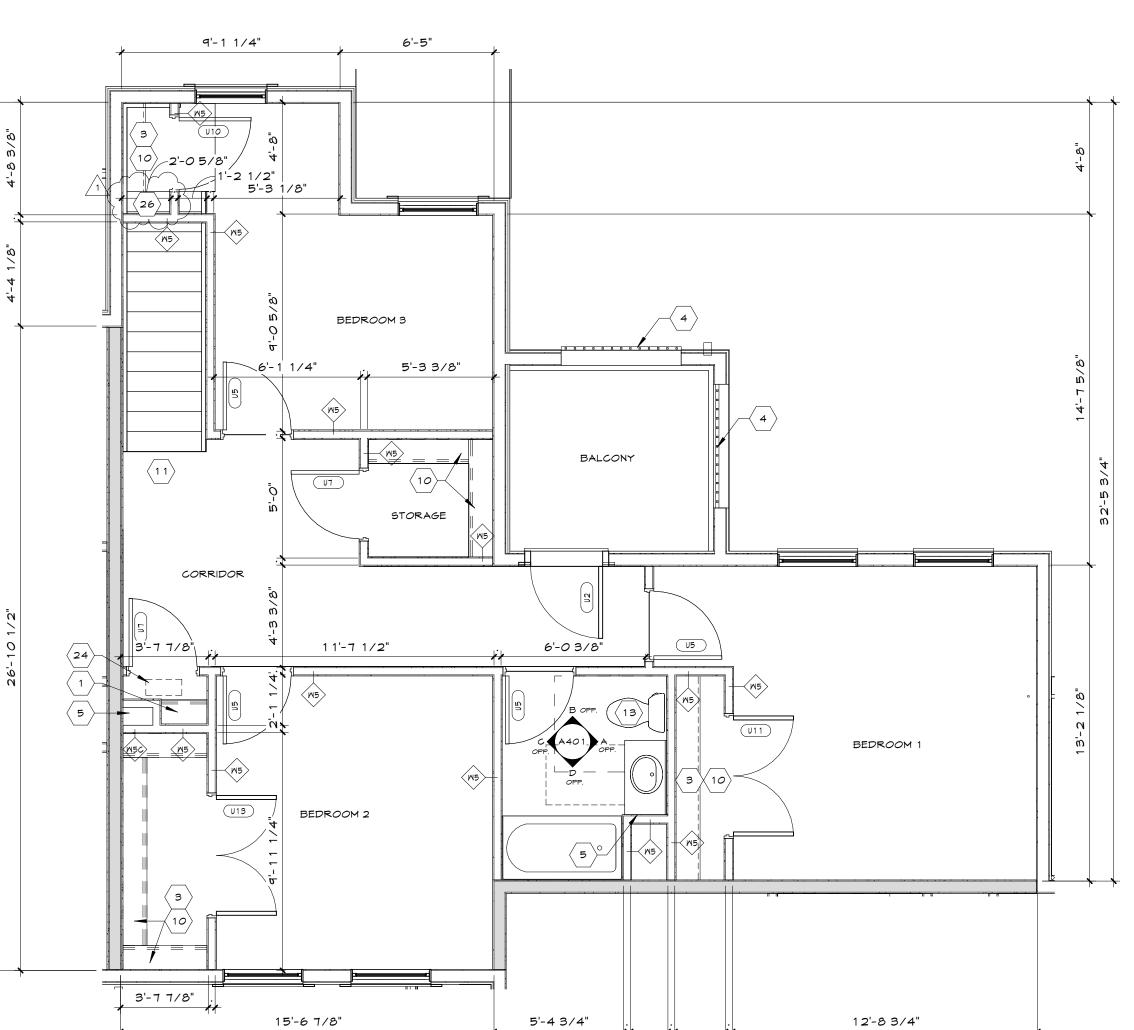

1'-6 3/4"

2'-1 1/4"

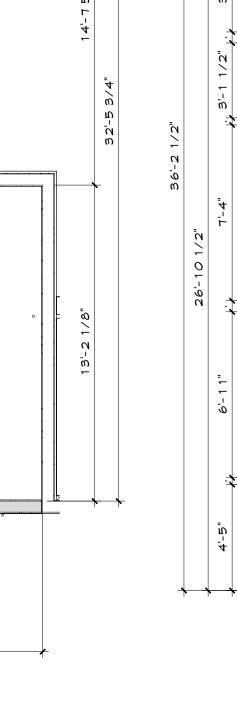

 $\A307$ 

## unit general notes: unit guidelines

- ALL INTERIOR DWELLING UNITS COMPLY WITH THE "FAIR HOUSING ACCESSIBILITY GUIDELINES" (FHAG),
- AND ALL FEDERAL, STATE AND LOCAL ACCESSIBILITY CODES. FIVE PERCENT (5%) OF THE TOTAL NUMBER OF UNITS (4 DWELLING UNITS CONSISTING OF (3) - TWO BEDROOM AND (1) THREEBEDROOM) ARE 'TYPE A' FULLY ACCESSIBLE AS REQUIRED BY CODE. (LABELED HC) AND MUST BE CONSTRUCTED FOR ACCESSIBILITY IN ACCORDANCE WITH THE LOCAL JURISDICTION AND THE PROVISIONS FOR TYPE A UNIT AS DEFINED BY ANSI - A 1 1 7.1. THE REMAINDER

OF ALL UNITS MUST BE CONSTRUCTED FOR ACCESSIBILITY IN ACCORDANCE WITH THE LOCAL

JURISDICTION AND THE PROVISIONS FOR TYPE B UNITS AS DEFINED BY ANSI - A 1 1 7.1. ALL DWELLING UNITS MEET AND EXCEED THE MINIMUM REQUIREMENTS FOR "OHFTYPE UNITS (ONE-BEDROOM SQUARE FOOTAGE OF 650 S.F. + / TWO-BEDROOM SQUARE FOOTAGE OF

- ALL DWELLING UNITS SHALL BE EQUIPPED WITH THE FOLLOWING APPLIANCES: -REFRIGERATOR
- -30" RANGE -DISHMASHER
- -ALL APPLIANCES MEET CLEAR FLOOR SPACE REQUIREMENTS ALL DWELLING UNIT BEDROOMS MEET AND EXCEED THE MINIMUM REQUIREMENTS FOR UNIT BEDROOMS (MINIMUM REQUIREMENT OF 7'-0" IN EACH DIRECTION AND MINIMUM OF 100 S.F.). ALL DWELLING UNIT ENTRY DOORS SHALL BE A 36" WIDE SOLID CORE DOOR (NO UNIT HAS A STEP
- ALL DOOR HARDWARE SHALL HAVE A LEVER DESIGN.
- ALL CARPET TO BE LOW (LESS THAN ½" HIGH PILE) DENSITY WITH FIRM PAD NO PAD AT ANSI TYPE
- 'A' DMELLING UNITS.
- THRESHOLD REQUIREMENTS:
- -EXTERIOR MAXIMUM OF 1/2" BEVEL -INTERIOR MAXIMUM OF 14" BEVEL
- ALL INTERIOR DOORS SHALL BE 32" (CLEAR WIDTH) OR GREATER. ALL DWELLING UNITS ARE EQUIPPED WITH A MIN. OF ONE (1) FULL BATHROOM.
- ALL EXPOSED PLUMBING (AT BATHROOMS AND KITCHENS), SUPPLY AND DRAIN/SANITARY LINES, TO PROTECT AGAINST SCALDING/BURNS AND BUMPS.
- ALL TOILETS TO BE 2 ½" ("ADA" COMPLIANT) HIGHER THAN STANDARD TOILETS (17"-19") OR BE HEIGHT ADJUSTABLE.
- ALL INSTALLED GRAB BARS AND REQUIRED BLOCKING (FOR FUTURE INSTALLATION) SHALL MEET OR EXCEED THE ABILITY TO SUPPORT 250-300 LBS.
- BATHROOMS TO MEET OR EXCEED 60" TURNING RADIUS/T-TURN SPACE.
- KITCHENS TO HAVE A FAUCET WITH LEVERED HANDLES. ALL DRAMER PULLS TO HAVE "LOOPED" HANDLES FOR EASY GRIP AND PULL.
- ALL WORK SURFACES TO HAVE TASK LIGHTING ( SEE "ELECTRICAL DRAMINGS").
- ROCKER TYPE LIGHT SWITCHED THROUGHOUT UNIT CARBON MONOXIDE DETECTORS TO BE INSTALLED ON EACH FLOOR OF DWELLING UNIT.
- COMBUSTION EQUIPMENT TO BE VENTED TO EXTERIOR. BATHROOM & KITCHEN TO BE EXHAUSTED TO EXTERIOR
- 23. ALL COUNTERTOPS TO HAVE RADIUSED CORNERS (2"R)


#### unit durability notes:

- CONTRACTOR TO USE LEED FOR HOMES DURABILITY CHECKLIST DURING CONSTRUCTION; DURABILITY ITEMS ARE LISTED BELOW ARE NOT LIMITED TO THESE ITEMS.
- WATER RESISTANT FLOORING AT KITCHENS/BATHROOMS/LAUNDRIES AND ENTRY WAYS. INSTALL DRAIN & DRAIN PAN AT WATER HEATER.
- WASHER BOX TO HAVE SINGLE THROW VALVE.
- CLOTHES DRYER TO BE EXHAUSTED TO EXTERIOR.
- SEAL ALL EXTERNAL CRACK JOINTS, ETC. WITH CAULKING OR PEST=PROOF SCREEN. ALL FLOORING IN BATHROOMS AND KITCHENS TO BE RUN WALL-TO-WALL (UNDER ALL REMOVABLE ACABINETS AND APPLIANCES).
- ALL DRYWALL TO BE SEALED USE NON-PAPER FACED BACKER BOARD AT ALL BATHROOM WALLS, TUB/SHOWER ENCLOSURES
- AND LAUNDRY AREAS INCLUDING CEILINGS. SEAL ALL RECESSED CAN LIPS, UTILITY BOXES AND DOOR JAMBS.
- TUBS/SHOWERS, STAIRS AND FIREPLACE ENCLOSURES REQUIRE EXTERIOR WALLS TO BE PRE-INSULATED AND BOARDED PRIOR TO BEING BUILT AGAINST.
- ALL INTERIOR DOORS TO BE FILLIED CORE.
- KEEP ALL STORED MATERIALS DRY ON SITE PROVIDE POSITIVE DRAINAGE AWAY FROM WALLS.
- RAISE PAPER COVERED GYPSUM BOARD 1/2" ABOVE CONCRETE SLAB.
- PRIME AND PAINT ALL EXTERIOR WOOD TRIM ON ALL 6 SIDES. 17. CEMENTITIOUS SIDING TO BE SEALED AND INSTALLED PER MANUFACTURERS INSTRUCTIONS.

## unit general notes:


- SEE SHEET AOO 1 FOR MOUNTING HEIGHTS, SYMBOLS AND ADDITIONAL INFORMATION SEE SHEET A002 FOR WALL AND FLOOR TYPES
- 3. ALL INTERIOR WALL THICKNESSES ARE 3 1/2" (TYPE M5) UNLESS INDICATED OTHERWISE
- 4. SEE STRUCTURAL DRAWINGS FOR ALL SHEAR WALL CONDITIONS AND DETAILING 5. SEE INDEXED SHEET FOR CODE REQUIRED
- GRAB BAR BLOCKING 6. COORDINATE ALL SHOWER DIMENSIONS WITH FINAL SELECTION OF MANUFACTURER PRIOR
- TO CONSTRUCTION 7. ALL RATED WALL ASSEMBLIES MUST BE COMPLETE BEHIND ALL SIDES OF SHOWERS
- 8. WASHER/DRYER CLOSET SIZED AND EQUIPPED TO ACCEPT SEPERATE WASHER/ DRYER -
- CENTERED CONDENSING WASHER/DRYER REQIURED FOR FULL VISITABILITY
- SEE REFLECTED CEILING PLAN/MECHANICAL DRAWINGFS FOR UNITI PLAN SOFFIT LOCATIONS 10. SEE BUILDING FLOOR PLANS (SHEET SERIES
- A 100'S) FOR COMMON PARTITION WALL TYPE DESIGNATIONS 1. EXTERIOR DOORS AND FRAMES TO BE INSULATED
- HOLLOW METAL. DOORS WITH HOLLOW METAL FRAMES. 2. SEE BELOW DIAGRAM FOR DOOR LOCATIONS. CLOSET DOORS SHOULD BE CENTERED IN OPENING UNLESS OTHERWISE NOTED.

NOTE: 2X6 WALLS INCLUDE BUT ARE NOT LIMITED TO EXTERIOR WALLS, DEMISING WALLS AND PLUMBING WALLS

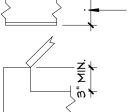

- THIS SYMBOL IN A DIMENSION STRING INDICATES A 2X4 WALL (3 1/2")

UNLESS NOTED OTHERWISE - 3" IS THE MINIMUM DISTANCE FROM A ROUGH FRAMED CORNER TO A ROUGH FRAMED DOOR JAMB

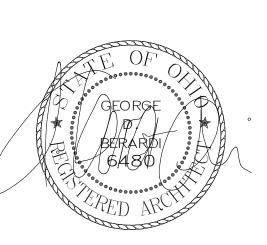

GEORGE D. BERARDI, LICENSE #6480 EXPIRATION DATE: 12/31/2015

**LMHA** Collingwood Green, Phase III





THE ARRANGEMENTS DEPICTED HEREIN ARE THE SOLE PROPERTY OF BERARDI + PARTNERS, INC., ARCHITECTS AND ENGINEERS, AND MAY NOT BE REPRODUCED WITHOUT ITS WRITTEN PERMISSION

ARCHITECTS AND ENGINEERS

ALL RIGHTS RESERVED

ALL BIDDERS SHALL VISIT THE SITE AND BECOME FAMILIAR W/ THE EXISTING CONDITIONS AND REQUIREMENTS OF THE PROJECT AND SHALL NOTIFY THE ARCHITECT OF ANY ERRORS AND OMISSIONS SUBSEQUENTLY DISCOVERED IN THE CONTRACT DOCUMENTS. 2. THE CONTRACT DOCUMENTS ARE COMPRISED OF THE DRAWINGS AND THE PROJECT MANUAL IN THEIR ENTIRETY. THE INFORMATION IN THESE DOCUMENTS IS DEPENDENT UPON AND COMPLEMENTARY OF

EACH OTHER. SEPARATION OF THE CONTRACT DOCUMENTS SHALL

NOT BE PERMITTED. IF THE CONTRACTOR CHOOSES TO SEPARATE THE DOCUMENTS, THEY DO SO AT THEIR OWN RISK AND EXPENSE 3. ADDITIONALLY, SEE GENERAL INFORMATION ON "AO" SHEETS. 4. THE CLIENT ACKNOWLEDGES THE CONSULTANT'S (ARCHITECT) DRAWINGS AND SPECIFICATION, INCLUDING AL DOCUMENTS ON ELECTRONIC MEDIA AS INSTRUMENTS OF THE CONSULTANTS (ARCHITECT) PROFESSIONAL SERVICE. THE CLIENT SHALL NOT REUSE OR MAKE OR PERMIT TO BE MADE ANY MODIFICATION TO THE DRAWINGS AND SPECIFICATIONS WITHOUT THE PRIOR WRITTEN AUTHORIZATION

ARISING FROM ANY UNAUTHORIZED TRANSFER, REUSE OR MODIFICATION OF THE DRAWINGS AND SPECIFICATIONS. CONTAINED HEREIN. ANY USE OR REUSE OF ORIGINAL OR ALTERED CADD DESIGN MATERIALS BY THE USER OR OTHER PARTIES WITHOUT THE REVIEW AND WRITTEN RISK OF THE USER. FURTHERMORE, USER AGREES TO DEFEND, INDEMNIFY, AND HOLD ARCHITECT HARMLESS FROM ALL CLAIMS, INJURIES, DAMAGES, LOSSES,

OF THE CONSULTANT (ARCHITECT). THE CLIENT AGREES TO

WAIVE ANY CLAIM AGAINST THE CONSULTANT (ARCHITECT

MODIFICATION OR REUSE OF THESE MATERIALS. 6.THESE DRAWINGS AS PART OF THE CONTRACT DOCUMENTS ARE DIAGRAMMATIC AND ARE NOT INTENDED TO DEFINE EXACT QUANTITIES, LOCATIONS OR CODIFIED REQUIREMENTS. THE DRAWINGS SHALL NOT BE SCALED, EXACT STATE AND LOCAL GODE REQUIREMENTS AND OTHER APPLICABLE CODE REQUIREMENTS SHALL BE VERIFIED BY AND ARE THE SOLE RESPONSIBILITY OF THIS CONTRACTOR. ANY INFORMATION WHICH DIRECTLY CONFLICTS WITH ANY OF THESE

EXPENSES. AND ATTORNEY'S FEES ARISING OUT OF THE

CODES OR ANY DISCREPANCIES FOUND IN THE CONTRACT DOCUMENTS SHALL BE BROUGHT TO THE ATTENTION OF THE PROJECT ARCHITECT Bid Set

PROJECT DATE: 01/26/2017 PROJECT #:

14105

09/06/2017 09/18/2017 Addendum 2

> **ENLARGED UNIT PLANS** 3BR CORNER T.H. A

A307

THE **COLLABORATIVE** 

architecture + interior design + engineerinį 1398 Goodale Blvd. Columbus, Ohio 43212 Phone (614)221-1110) Fax (614)221-0831

www.berardipartners.com

2ND FLOOR THREE BEDROOM TOWNHOUSE 'A'  $\sqrt{A307}$ 

1ST FLOOR THREE BEDROOM TOWNHOUSE 'A 1/4" = 1'-0'

MUD ROOM

14'-15/16"

6'-11 15/16"

3 bedroom flat (A30	1) ANS	SI TYPE	A		
ROOM	BASE	FLOOR	MALLS	CEILING	REMARKS
ENTRY	VCB	VP	PT2-E	PT1-F	-
ENTRY CLOSET	VCB	VP	PT2-E	PT1-F	-
LIVING ROOM	VCB	VP	PT2-E	PT1-F	-
DINING ROOM	VCB	VP	PT2-E	PT1-F	-
KITCHEN	VCB	VP	PT2-E	PT1-F	PLAM2, VCB AT CAB
LAUNDRY	VCB	٧P	PT2-E	PT1-F	-
MECHANICAL	VCB	VCT	PT2-E	PT1-F	-
HALF BATH	VCB	LVT	PT4-SG	PT1-56	PLAM3, VCB AT CAB, 9
BEDROOM 1, 243	VCB	VP	PT2-E	PT1-F	-
BEDROOM 1, 283 CLOSE	r ycb	VP	PT2-E	PT1-F	-
FULL BATH	VCB	LVT	PT2-56	PT1-56	PLAM3, VCB AT CAB, 9

AB	CABINETS: VISTA, CAFE
PT1	CARPET: PATCRAFT 10069 SOCRATES 11-28 BERKELEY 00114
<b>√</b> T	MANNINGTON COMMERCIAL - WALKWAY, WW 10 CAMMELBACK
LAM1	PLASTIC LAMINATE: FORMICA 3698-58 BELUGA BEIGE

- PLAM2 PLASTIC LAMINATE: FORMICA 3517-58 SAND CRYSTAL PAINT: SHERWIN WILLIAMS 7012 CREAMY (FLAT) PT 1-SG PAINT: SHERWIN WILLIAMS 7012 CREAMY (SEMI-GLOSS) PT2-E PAINT: SHERWIN WILLIAMS 6 1 06 KILIM BEIGE (EGGSHELL)
- PT2-SG PAINT: SHERWIN WILLIAMS 6106 KILIM BEIGE (SEMI-GLOSS) PT3-SG PAINT: SHERWIN WILLIAMS 6204 SEA SALT (SEMI-GLOSS) VINYL BASE: JOHNSONITE 11 CANVAS
- VCB VINYL COMPOSITE TILE: ARMSTRONG, IMPERIAL TEXTURE STANDARD EXCELON 51873 BRUSHED SAND
- VINYL PLANK: JOHNSONITE, FRE-PLANK 5162 APPLE VINYL TREAS & RISER: JOHNSONITE HT-XX-RD WOOD BASE PAINTED PT 1-SG (B-0 SHEET A402)

## general notes

CONC

- ALL WINDOWS TO RECEIVE MINI BLINDS SWF CONTRACT WHITE SATIN 205.
- PRE-MANUFACTURED WINDOW SILLS SHALL BE CULTURED MARBLE; BRIGHT 3. ALL WOOD TRIM THROUGH OUT TO BE PAINTED SEMI-GLOSS. SHERWIN
- WILLIAMS 7012 CREAMY 4. ALL PAINT TO BE LOW VOC.
- 5. LOOP STYLE PULL CABINET HARDWARE. NOT USED

SEALED CONCRETE

- 7. INSTALL VINYL BASE AT CABINET TOE AND SIDE PANELS.
- 9. MEMBRANE PER SPECIFICATIONS AT ALL SECOND FLOOR CERAMIC TILE LOCATIONS

2 bedroom flat (A30	)2) ANS	I TYPE	A		
ROOM	BASE	FLOOR	MALLS	CEILING	REMARKS
ENTRY	VCB	VP	PT2-E	PT1-F	-
ENTRY CLOSET	VCB	٧P	PT2-E	PT1-F	-
LIVING ROOM	YCB	٧P	PT2-E	PT1-F	-
DINING ROOM	YCB	٧P	PT2-E	PT1-F	-
KITCHEN	YCB	٧P	PT2-E	PT1-F	PLAM2, VCB AT CAB
LAUNDRY	YCB	٧P	PT2-E	PT1-F	-
MECHANICAL	YCB	VCT	PT2-E	PT1-F	-
BEDROOM 1\$2	VCB	CPT1	PT2-E	PT1-F	-
BEDROOM 1\$2 CLOSET	VCB	CPT1	PT2-E	PT1-F	-
FULL BATHROOM	VCB	LVT	PT3-56	PT1-56	PLAM1, VCB AT CAB, 9
unit finish key					

ullit	minsii key			

- CABINETS: VISTA, CAFE CARPET: PATCRAFT 10069 SOCRATES 11-28 BERKELEY 00114 MANNINGTON COMMERCIAL - WALKWAY WW 10 CAMELBACK PLASTIC LAMINATE: FORMICA 3698-58 BELUGA BEIGE PLAM1 PLASTIC LAMINATE: FORMICA 3517-58 SAND CRYSTAL
- PAINT: SHERWIN WILLIAMS 7012 CREAMY (FLAT) PT 1-SG PAINT: SHERWIN WILLIAMS 7012 CREAMY (SEMI-GLOSS) PAINT: SHERWIN WILLIAMS 6 106 KILIM BEIGE (EGGSHELL) PT2-E PT2-SG PAINT: SHERWIN WILLIAMS 6 106 KILIM BEIGE (SEMI-GLOSS) PT3-SG PAINT: SHERWIN WILLIAMS 6204 SEA SALT (SEMI-GLOSS) VINYL BASE: JOHNSONITE 11 CANVAS
- VINYL COMPOSITE TILE: ARMSTRONG, IMPERIAL TEXTURE STANDARD EXCELON 51873 BRUSHED SAND VINYL PLANK: JOHNSONITE, FRE-PLANK 5162 APPLE
- VINYL TREAS & RISER: JOHNSONITE HT-XX-RD WOOD BASE PAINTED PT 1-SG (B-0 SHEET A402) SEALED CONCRETE

#### general notes

- ALL WINDOWS TO RECEIVE MINI BLINDS SWF CONTRACT WHITE SATIN 205.
- PRE-MANUFACTURED WINDOW SILLS SHALL BE CULTURED MARBLE; BRIGHT
- ALL WOOD TRIM THROUGH OUT TO BE PAINTED SEMI-GLOSS. SHERWIN WILLIAMS 7012 CREAMY
- ALL PAINT TO BE LOW VOC. 5. LOOP STYLE PULL CABINET HARDWARE.
- 6. NOT USED
- 7. INSTALL VINYL BASE AT CABINET TOE AND SIDE PANELS. NOT USED
- 9. MEMBRANE PER SPECIFICATIONS AT ALL SECOND FLOOR CERAMIC TILE LOCATIONS

4 bedroom flat (A30	)3) ANS	I TYPE	A		
ROOM	BASE	FLOOR	MALLS	CEILING	REMARKS
ENTRY	VCB	٧P	PT2-E	PT1-F	-
ENTRY CLOSET	VCB	VP	PT2-E	PT1-F	-
LIVING ROOM	∨CB	٧P	PT2-E	PT1-F	-
DINING ROOM	VCB	٧P	PT2-E	PT1-F	-
KITCHEN	VCB	٧P	PT2-E	PT1-F	PLAM2, VCB AT CAB
LAUNDRY	VCB	VP	PT2-E	PT1-F	-
MECHANICAL	VCB	VCT	PT2-E	PT1-F	-
FULL BATH 1	VCB	LVT	PT4-5G	PT1-56	PLAM3, VCB AT CAB, 9
FULL BATH 2	VCB	LVT	PT2-56	PT1-56	PLAM3, VCB AT CAB, 9
BEDROOM 1, 2, 344	VCB	٧P	PT2-E	PT1-F	-
BEDROOM 1, 2, 3 \$4 CLOSET	VCB	VP	PT2-E	PT1-F	-
unit finish key					
CAB CABINETS: V CPT1 CARPET: PA			RATES II-2	8 BERKELI	EY 00114

- PLAM1 PLASTI
- PLAM2 PLASTIC LAMINATE: FORMICA 3517-58 SAND CRYSTAL PT1-F PAINT: SHERMIN WILLIAMS 7012 CREAMY (FLAT) PT1-SG PAINT: SHERWIN WILLIAMS 7012 CREAMY (SEMI-GLOSS)
- PT2-E PAINT: SHERWIN WILLIAMS 6106 KILIM BEIGE (EGGSHELL) PT2-SG PAINT: SHERWIN WILLIAMS 6106 KILIM BEIGE (SEMI-GLOSS)
- PT3-SG PAINT: SHERWIN WILLIAMS 6204 SEA SALT (SEMI-GLOSS) VINYL BASE: JOHNSONITE 11 CANVAS
- VINYL COMPOSITE TILE: ARMSTRONG, IMPERIAL TEXTURE STANDARD EXCELON 51873 BRUSHED SAND
- VINYL PLANK: JOHNSONITE, FRE-PLANK 5162 APPLE VINYL TREAS & RISER: JOHNSONITE HT-XX-RD
- WOOD BASE PAINTED PT 1-SG (B-0 SHEET A402) CONC SEALED CONCRETE

#### general notes

- ALL WINDOWS TO RECEIVE MINI BLINDS SWF CONTRACT WHITE SATIN 205.
- PRE-MANUFACTURED WINDOW SILLS SHALL BE CULTURED MARBLE; BRIGHT 3. ALL MOOD TRIM THROUGH OUT TO BE PAINTED SEMI-GLOSS. SHERWIN
- MILLIAMS 7012 CREAMY 4. ALL PAINT TO BE LOW VOC.
- 5. LOOP STYLE PULL CABINET HARDWARE. 6. NOT USED
- 7. INSTALL VINYL BASE AT CABINET TOE AND SIDE PANELS. 8. NOT USED
- 9. MEMBRANE PER SPECIFICATIONS AT ALL SECOND FLOOR CERAMIC TILE LOCATIONS

VCB													
VCB	lat (A30	03) ANS	SI TYPE	A				2 bedroom townhom	ne (A30	4) ANSI	TYPE I	В	
VCB	•	BASE	FLOOR	MALLS	CEILING	REMARKS		ROOM	BASE	FLOOR	MALLS	CEILING	REMARKS
VCB		VCB	VP	PT2-E	PT1-F	-		ENTRY	VCB	٧P	PT2-E	PT1-F	-
VCB	-	VCB	VP	PT2-E	PT1-F	-		ENTRY CLOSET	VCB	VP	PT2-E	PT1-F	-
VCB		VCB	VP	PT2-E	PT1-F	-		STORAGE	VCB	٧P	PT2-E	PT1-F	-
NITCHEN   VCB   VP   PT2-E   PT1-F   PLAM2, VCB AT CAB		VCB	VP	PT2-F	PT1-F	_	-	LIVING ROOM	VCB	٧P	PT2-E	PT1-F	-
VCB VP PT2-E PT1-F -  VCB VCT PT2-E PT1-F -  VCB VCT PT2-E PT1-F -  VCB LVT PT4-96 PT1-96 PLAM3, VCB AT CAB, 9  VCB LVT PT2-56 PT1-96 PLAM3, VCB AT CAB, 9  VCB LVT PT2-56 PT1-96 PLAM3, VCB AT CAB, 9  VCB LVT PT2-96 PT1-96 PLAM3, VCB AT CAB, 9  S144 VCB VP PT2-E PT1-F -  S144 VCB VP PT2-E PT1-F -  CORRIDOR VCB VP PT2-E PT1-F -  CORRIDOR CLOSET VCB VP PT2-E PT1-F -  CORRIDOR CLOSET VCB VP PT2-E PT1-F -  BEDROOM 142 VCB VP PT2-E PT1-F -  BEDROOM 142 CLOSET VCB CPT1 PT2-E PT1-F -  BEDROOM 142 CLOS		105	• •	1			-	KITCHEN	VCB	٧P	PT2-E	PT1-F	PLAM2, VCB AT CAB
VCB		VCB	VP	PT2-E	PT1-F	PLAM2, VCB AT CAB		LAUNDRY	VCB	VP	PT2-E	PT1-F	-
VCB         VCT         PT2-E         PT1-F         -           VCB         LVT         PT4-9G         PT1-9G         PLAM3, VCB AT CAB, 9           VCB         LVT         PT2-9G         PT1-9G         PLAM3, VCB AT CAB, 9           J344         VCB         VP         PT2-E         PT1-F         -           J345         VCB         VP         PT2-E         PT1-F         -           J346         VCB         VP         PT2-E         PT1-F         -           J347         VCB         VP         PT2-E         PT1-F         - <tr< td=""><td></td><td>VCB</td><td>VP</td><td>PT2-E</td><td>PT1-F</td><td>-</td><td></td><td>MECHANICAL</td><td>VCB</td><td>VCT</td><td>PT2-E</td><td>PT1-F</td><td>-</td></tr<>		VCB	VP	PT2-E	PT1-F	-		MECHANICAL	VCB	VCT	PT2-E	PT1-F	-
MUD ROOM		VCB	VCT	PT2-E	PT1-F	_		HALF BATH	VCB	LVT	PT3-56	PT1-5G	PLAM1, VCB AT CAB, 9
VCB							_	MUD ROOM	VCB	٧P	PT2-E	PT1-F	-
384   VCB   VP   PT2-E   PT1-F   -		VCB	LVT	PT4-SG	PT1-56	PLAM3, VCB AT CAB, 9		MUD ROOM CLOSET	VCB	٧P	PT2-E	PT1-F	-
CORRIDOR CLOSET VCB VP PT2-E PT1-F -  BEDROOM 1&2 VCB CPT1 PT2-E PT1-F -  BEDROOM 1&2 CLOSET VCB CPT1 PT2-E PT1		VCB	LVT	PT2-56	PT1-56	PLAM3, VCB AT CAB, 9		STAIR	VCB	VT&R	PT2-E	PT1-F	PT 1-SG ON STRINGER
BEDROOM 1&2 VCB CPT1 PT2-E PT1-F -  BEDROOM 1&2 CLOSET VCB CPT1 PT2-E PT1-F -  BEDROOM 1&2 CLOSET VCB CPT1 PT2-E PT1-F -  BEDROOM 1&2 CLOSET VCB CPT1 PT2-E PT1-F -  FULL BATHROOM VCB LVT PT2-SG PT1-SG PLAM1, VCE  RPET: PATCRAFT 1006 9 SOCRATES II-28 BERKELEY 00114  NNINGTON COMMERCIAL - WALKWAY WW 10 CAMELBACK  Unit finish key	, 3#4	VCB	VP	PT2-E	PT1-F	-		CORRIDOR	VCB	٧P	PT2-E	PT1-F	-
BEDROOM 1\$2 CLOSET VCB CPT1 PT2-E PT1-F - BINETS: VISTA, CAFE RPET: PATCRAFT 10069 SOCRATES 11-26 BERKELEY 00114 NNINGTON COMMERCIAL - WALKWAY WW10 CAMELBACK  BEDROOM 1\$2 CLOSET VCB CPT1 PT2-E PT1-F - FULL BATHROOM VCB LVT PT2-SG PT1-SG PLAM1, VCB unit finish kev	, 3\$4	VCB	٧P	PT2-E	PT1-F	-		CORRIDOR CLOSET	YCB	٧P	PT2-E	PT1-F	-
FULL BATHROOM VCB LVT PT2-5G PT1-5G PLAM1, VCE RPET: PATCRAFT 10069 SOCRATES II-28 BERKELEY 00114 NNINGTON COMMERCIAL - WALKWAY WW10 CAMELBACK  unit finish kev							<del>-</del>	BEDROOM 1\$2	VCB	CPT1	PT2-E	PT1-F	-
RPET: PATCRAFT 10069 SOCRATES 11-28 BERKELEY 00114  NNINGTON COMMERCIAL - WALKWAY WW10 CAMELBACK  unit finish kev	ey							BEDROOM 1 \$2 CLOSET	VCB	CPT1	PT2-E	PT1-F	-
NNINGTON COMMERCIAL - WALKWAY MW 10 CAMELBACK unit finish kev				PATES II_ ?	S REPKEL	EY 00114		FULL BATHROOM	VCB	LVT	PT2-SG	PT1-5G	PLAM1, VCB AT CAB, 9
ASTIC LAMINATE: FORMICA 3698-58 BELUGA BEIGE	NNINGTON	N COMMER	CIAL - MA	LKMAY MY	N10 CAME	LBACK		unit finish key					

111111111111111111111111111111111111111	пксу		
ΔB	CABINETS: VI	STA CAFE	

- CARPET: PATCRAFT 10069 SOCRATES II-28 BERKELEY 00114 MANNINGTON COMMERCIAL - WALKWAY WW 10 CAMELBACK PLAM1 PLASTIC LAMINATE: FORMICA 3698-58 BELUGA BEIGE PLAM2 PLASTIC LAMINATE: FORMICA 3517-58 SAND CRYSTAL
- PAINT: SHERMIN MILLIAMS 7012 CREAMY (FLAT) PT1-SG PAINT: SHERWIN WILLIAMS 7012 CREAMY (SEMI-GLOSS) PT2-E PAINT: SHERWIN WILLIAMS 6106 KILIM BEIGE (EGGSHELL) PT2-SG PAINT: SHERMIN MILLIAMS 6106 KILIM BEIGE (SEMI-GLOSS)
- PT3-SG PAINT: SHERWIN WILLIAMS 6204 SEA SALT (SEMI-GLOSS) VINYL BASE: JOHNSONITE 11 CANVAS VCB VINYL COMPOSITE TILE: ARMSTRONG, IMPERIAL TEXTURE STANDARD EXCELON
- 5 1873 BRUSHED SAND VINYL PLANK: JOHNSONITE, FRE-PLANK 5162 APPLE
- VINYL TREAS & RISER: JOHNSONITE HT-XX-RD MOOD BASE PAINTED PT 1-SG (B-0 SHEET A402) SEALED CONCRETE

#### general notes

- ALL WINDOWS TO RECEIVE MINI BLINDS SWF CONTRACT WHITE SATIN 205.
- PRE-MANUFACTURED WINDOW SILLS SHALL BE CULTURED MARBLE; BRIGHT 3. ALL WOOD TRIM THROUGH OUT TO BE PAINTED SEMI-GLOSS. SHERWIN
- MILLIAMS 7012 CREAMY ALL PAINT TO BE LOW VOC.
- 5. LOOP STYLE PULL CABINET HARDWARE.
- INSTALL VINYL BASE AT CABINET TOE AND SIDE PANELS.

## MEMBRANE PER SPECIFICATIONS AT ALL SECOND FLOOR CERAMIC TILE

# LOCATIONS

#### FLOOR TRANSITIONS \*ALL FLOORING AND TRANSITIONS INSTALLED PER MANUFACTURER'S INSTRUCTIONS JOHNSONITE T-MOULDING JOHNSONITE TRACK FOR CE-XX-A COORDINATE T-MOULDING MT-00-B PROFILE WITH INSTALLATION CARPET VINYL PLANK VINYL PLANKTO CARPET JOHNSONITE WHEELED TRAFFIC TRANSITION CTA-XX-N VINYL PLANK VCT VIYNL PLANK TO VCT

ROOM	BASE	FLOOR	MALLS	CEILING	REMARKS
ENTRY	VCB	٧P	PT2-E	PT1-F	-
ENTRY CLOSET	VCB	٧P	PT2-E	PT1-F	-
LIVING ROOM	VCB	VP	PT2-E	PT1-F	-
STORAGE	VCB	VP	PT2-E	PT1-F	-
KITCHEN	VCB	VP	PT2-E	PT1-F	PLAM2, VCB AT CAB
LAUNDRY	VCB	VP	PT2-E	PT1-F	-
MECHANICAL	VCB	VCT	PT2-E	PT1-F	-
MUD ROOM	VCB	VP	PT2-E	PT1-F	-
MUD ROOM CLOSET	VCB	VP	PT2-E	PT1-F	-
HALF BATH	VCB	LVT	PT4-5G	PT1-56	PLAM3, VCB AT CAB, 9
HALF BATH CLOSET	VCB	LVT	PT4-5G	PT1-56	-
BEDROOM 1	VCB	VP	PT2-E	PT1-F	-
BEDROOM 1 CLOSET	VCB	VP	PT2-E	PT1-F	-
STAIR	VCB	VT&R	PT2-E	PT1-F	PT 1-SG ON STRINGER
CORRIDOR	VCB	VP	PT2-E	PT1-F	-
CORRIDOR CLOSET	VCB	VP	PT2-E	PT1-F	-
BATHROOM SECOND FLOOR	VCB	LVT	PT2-56	PT1-56	PLAM3, VCB AT CAB, 9
BEDROOM 243	VCB	CPT1	PT2-E	PT1-F	-
BEDROOM 2#3 CLOSET	VCB	CPT1	PT2-E	PT1-F	-

- CABINETS: VISTA, CAFE
- CARPET: PATCRAFT 10069 SOCRATES 11-28 BERKELEY 00114 MANNINGTON COMMERCIAL - WALKWAY WW 10 CAMELBACK PLAM1 PLASTIC LAMINATE: FORMICA 3698-58 BELUGA BEIGE
- PLAM2 PLASTIC LAMINATE: FORMICA 3517-58 SAND CRYSTAL PT1-F PAINT: SHERWIN WILLIAMS 7012 CREAMY (FLAT) PT1-SG PAINT: SHERMIN WILLIAMS 7012 CREAMY (SEMI-GLOSS)
- PT2-E PAINT: SHERMIN WILLIAMS 6106 KILIM BEIGE (EGGSHELL) PT2-SG PAINT: SHERMIN WILLIAMS 6106 KILIM BEIGE (SEMI-GLOSS)
- VINYL BASE: JOHNSONITE 11 CANVAS VCB VINYL COMPOSITE TILE: ARMSTRONG, IMPERIAL TEXTURE STANDARD EXCELON VCT 51873 BRUSHED SAND
- VINYL PLANK: JOHNSONITE, FRE-PLANK 5162 APPLE
- VINYL TREAS & RISER: JOHNSONITE HT-XX-RD MOOD BASE PAINTED PT 1-SG (B-0 SHEET A402)

PT3-SG PAINT: SHERMIN WILLIAMS 6204 SEA SALT (SEMI-GLOSS)

### SEALED CONCRETE

#### general notes

- . ALL WINDOWS TO RECEIVE MINI BLINDS SWF CONTRACT WHITE SATIN 205. . PRE-MANUFACTURED WINDOW SILLS SHALL BE CULTURED MARBLE; BRIGHT
- 3. ALL WOOD TRIM THROUGH OUT TO BE PAINTED SEMI-GLOSS. SHERWIN
- WILLIAMS 7012 CREAMY
- 4. ALL PAINT TO BE LOW VOC. 5. LOOP STYLE PULL CABINET HARDWARE.
- 7. INSTALL VINYL BASE AT CABINET TOE AND SIDE PANELS.
- 9. MEMBRANE PER SPECIFICATIONS AT ALL SECOND FLOOR CERAMIC TILE LOCATIONS

ROOM	BASE	FLOOR	MALLS	CEILING	REMARKS
ENTRY	VCB	VP	PT2-E	PT1-F	-
ENTRY GLOSET	VCB	VP	PT2-E	PT1-F	-
IVING ROOM	VCB	VP	PT2-E	PT1-F	-
STORAGE	VCB	٧P	PT2-E	PT1-F	-
KITCHEN	VCB	٧P	PT2-E	PT1-F	PLAM2, VCB AT CAB
AUNDRY	VCB	VP	PT2-E	PT1-F	-
MECHANICAL	VCB	VCT	PT2-E	PT1-F	-
MUD ROOM	VCB	VP	PT2-E	PT1-F	-
BATHROOM FIRST FLOOR	VCB	LVT	PT4-5G	PT1-56	PLAM3, VCB AT CAB, 9
BEDROOM 1	VCB	VP	PT2-E	PT1-F	-
BEDROOM 1 CLOSET	VCB	VP	PT2-E	PT1-F	-
STAIR	VCB	VT&R	PT2-E	PT1-F	PT 1-SG ON STRINGER
CORRIDOR	VCB	VP	PT2-E	PT1-F	-
CORRIDOR STORAGE	VCB	VP	PT2-E	PT1-F	-
CORRIDOR CLOSET	VCB	VP	PT2-E	PT1-F	-
BATHROOM SECOND FLOOR	VCB	LVT	PT2-56	PT1-56	PLAM3, VCB AT CAB, 9
3EDROOM 2, 3 \$ 4	VCB	CPT1	PT2-E	PT1-F	-
BEDR <i>OO</i> M 2, 3 \$ 4 CLOSET	MB	CPT1	PT2-E	PT1-F	-
ınit finish key					
CAB CABINETS: \ CPT 1 CARPET: PA .VT MANNINGTO!	TCRAFT IC	0069 500			

- PT2-E PAINT: SHERWIN WILLIAMS 6106 KILIM BEIGE (EGGSHELL) PT2-SG PAINT: SHERMIN WILLIAMS 6106 KILIM BEIGE (SEMI-GLOSS) PT3-SG PAINT: SHERWIN WILLIAMS 6204 SEA SALT (SEMI-GLOSS) VINYL BASE: JOHNSONITE 11 CANVAS VINYL COMPOSITE TILE: ARMSTRONG, IMPERIAL TEXTURE STANDARD EXCELON VCT
- 51873 BRUSHED SAND VINYL PLANK: JOHNSONITE, FRE-PLANK 5162 APPLE VINYL TREAS & RISER: JOHNSONITE HT-XX-RD
- MOOD BASE PAINTED PT 1-SG (B-0 SHEET A402) SEALED CONCRETE

#### general notes

- ALL WINDOWS TO RECEIVE MINI BLINDS SWF CONTRACT WHITE SATIN 205. PRE-MANUFACTURED WINDOW SILLS SHALL BE CULTURED MARBLE; BRIGHT
- ALL WOOD TRIM THROUGH OUT TO BE PAINTED SEMI-GLOSS. SHERWIN WILLIAMS 7012 CREAMY
- ALL PAINT TO BE LOW YOC.
- LOOP STYLE PULL CABINET HARDWARE. NOT USED
- INSTALL VINYL BASE AT CABINET TOE AND SIDE PANELS. MEMBRANE PER SPECIFICATIONS AT ALL SECOND FLOOR CERAMIC TILE
- LOCATIONS

3 bedroom townhor	ne (A30	7) ANS	TYPE	A	
ROOM	BASE	FLOOR	MALLS	CEILING	REMARKS
ENTRY	VCB	VP	PT2-E	PT1-F	-
ENTRY CLOSET	VCB	VP	PT2-E	PT1-F	-
LIVING ROOM	VCB	VP	PT2-E	PT1-F	-
KITCHEN	VCB	٧P	PT2-E	PT1-F	PLAM2, VCB AT CA
LAUNDRY	VCB	VP	PT2-E	PT1-F	-
MECHANICAL	VCB	VCT	PT2-E	PT1-F	-
MUD ROOM	VCB	VP	PT2-E	PT1-F	-
MUD ROOM CLOSET	VCB	VP	PT2-E	PT1-F	-
HALF BATH	VCB	LVT	PT4-SG	PT1-SG	PLAMS, VCB AT CA
STAIR	VCB	VT&R	PT2-E	PT1-F	PT 1-SG ON STRING
CORRIDOR	VCB	VP	PT2-E	PT1-F	-
CORRIDOR STORAGE	VCB	VP	PT2-E	PT1-F	-
CORRIDOR CLOSET	VCB	VP	PT2-E	PT1-F	-
BATHROOM SECOND FLOOR	VCB	LVT	PT2-56	PT1-56	PLAMS, VCB AT C
BEDROOM 1, 2\$3	VCB	CPT1	PT2-E	PT1-F	-
BEDROOM 1, 243 CLOSET	VCB	CPT1	PT2-E	PT1-F	-
unit finish key					
CAB CABINETS: V CPT1 CARPET: PA LVT MANNINGTON	TCRAFT IC N COMMER	0069 50C1 .CIAL - MAL	MAY MM 1	O CAMELE	BACK
PLAM1 PLASTIC LAN PLAM2 PLASTIC LAN PT1-F PAINT: SHER PT1-SG PAINT: SHER	INATE: FO	RMICA 35	17-58 SA	ND CRYST	

- PT2-E PAINT: SHERWIN WILLIAMS 6 106 KILIM BEIGE (EGGSHELL) PT2-SG PAINT: SHERWIN WILLIAMS 6106 KILIM BEIGE (SEMI-GLOSS) PT3-SG PAINT: SHERMIN MILLIAMS 6204 SEA SALT (SEMI-GLOSS) VINYL BASE: JOHNSONITE 11 CANVAS VCB VINYL COMPOSITE TILE: ARMSTRONG, IMPERIAL TEXTURE STANDARD EXCELON VCT
- 51873 BRUSHED SAND VINYL PLANK: JOHNSONITE, FRE-PLANK 5162 APPLE VINYL TREAS & RISER: JOHNSONITE HT-XX-RD MOOD BASE PAINTED PT 1-SG (B-O SHEET A402)

#### general notes

CONC

- ALL WINDOWS TO RECEIVE MINI BLINDS SWF CONTRACT WHITE SATIN 205. PRE-MANUFACTURED WINDOW SILLS SHALL BE CULTURED MARBLE; BRIGHT
- ALL WOOD TRIM THROUGH OUT TO BE PAINTED SEMI-GLOSS. SHERWIN
- WILLIAMS 7012 CREAMY 4. ALL PAINT TO BE LOW VOC.
- 5. LOOP STYLE PULL CABINET HARDWARE. 6. NOT USED

SEALED CONCRETE

- 7. INSTALL VINYL BASE AT CABINET TOE AND SIDE PANELS.
- 9. MEMBRANE PER SPECIFICATIONS AT ALL SECOND FLOOR CERAMIC TILE LOCATIONS



GEORGE D. BERARDI, LICENSE #6480 EXPIRATION DATE: 12/31/2015



BERARDI + PARTNERS, INC. ARCHITECTS AND ENGINEERS ALL RIGHTS RESERVED

THE ARRANGEMENTS DEPICTED HEREIN ARE THE SOLE PROPERTY OF BERARDI + PARTNERS, INC., ARCHITECTS AND ENGINEERS AND MAY NOT BE REPRODUCED WITHOUT ITS WRITTEN PERMISSION

. ALL BIDDERS SHALL VISIT THE SITE AND BECOME FAMILIAR W/ THE EXISTING CONDITIONS AND REQUIREMENTS OF THE PROJECT AND SHALL NOTIFY THE ARCHITECT OF ANY ERRORS AND OMISSIONS SUBSEQUENTLY DISCOVERED IN THE CONTRACT DOCUMENTS.

2.THE CONTRACT DOCUMENTS ARE COMPRISED OF THE DRAWINGS AND THE PROJECT MANUAL IN THEIR ENTIRETY. THE INFORMATION IN THESE DOCUMENTS IS DEPENDENT UPON AND COMPLEMENTARY OF EACH OTHER. SEPARATION OF THE CONTRACT DOCUMENTS SHALL NOT BE PERMITTED. IF THE CONTRACTOR CHOOSES TO SEPARATE THE DOCUMENTS, THEY DO SO AT THEIR OWN RISK AND EXPENSE.

3.ADDITIONALLY, SEE GENERAL INFORMATION ON "AO" SHEETS. 4. THE CLIENT ACKNOWLEDGES THE CONSULTANT'S (ARCHITECT) DRAWINGS AND SPECIFICATION, INCLUDING ALL DOCUMENTS ON ELECTRONIC MEDIA AS INSTRUMENTS OF THE CONSULTANTS (ARCHITECT) PROFESSIONAL SERVICE. THE CLIENT SHALL NOT REUSE OR MAKE OR PERMIT TO BE MADE ANY MODIFICATION TO THE DRAWINGS AND SPECIFICATIONS WITHOUT THE PRIOR WRITTEN AUTHORIZATION OF THE CONSULTANT (ARCHITECT). THE CLIENT AGREES TO WAIVE ANY CLAIM AGAINST THE CONSULTANT (ARCHITECT).

ARISING FROM ANY UNAUTHORIZED TRANSFER REUSE OR MODIFICATION OF THE DRAWINGS AND SPECIFICATIONS. 5.ARCHITECT CANNOT WARRANT THE ACCURACY OF DATA CONTAINED HEREIN. ANY USE OR REUSE OF ORIGINAL OR ALTERED CADD DESIGN MATERIALS BY THE USER OR OTHER PARTIES WITHOUT THE REVIEW AND WRITTEN APPROVAL OF THE ARCHITECT SHALL BE AT THE SOLE RISK OF THE USER. FURTHERMORE, USER AGREES TO DEFEND, INDEMNIFY, AND HOLD ARCHITECT HARMLESS FROM ALL CLAIMS, INJURIES, DAMAGES, LOSSES,

EXPENSES, AND ATTORNEY'S FEES ARISING OUT OF THE MODIFICATION OR REUSE OF THESE MATERIALS. 6.THESE DRAWINGS AS PART OF THE CONTRACT DOCUMENTS ARE DIAGRAMMATIC AND ARE NOT INTENDED TO DEFINE EXACT QUANTITIES, LOCATIONS OR CODIFIED REQUIREMENTS. THE DRAWINGS SHALL NOT ARE THE SOLE RESPONSIBILITY OF THIS CONTRACTOR ANY INFORMATION WHICH DIRECTLY CONFLICTS WITH ANY OF THESE CODES OR ANY DISCREPANCIES FOUND IN THE CONTRACT DOCUMENTS SHALL BE BROUGHT TO THE ATTENTION OF THE PROJECT ARCHITECT.

Bid Set

PROJECT DATE: 01/26/2017 PROJECT #: 14105

Date Bid Set 09/06/2017 09/18/2017 Addendum 2

> **UNIT FINISH** PLANS & **SCHEDULES**



THE COLLABORATIVE

architecture + interior design + engineering

1398 Goodale Blvd. Columbus, Ohio 43212 Phone (614)221-1110) Fax (614)221-0831 www.berardipartners.com